


FA 102-1

Plat of Survey



of

Lot 1 of Certified Survey Map No. 102,
recorded in Vol. 1 of Certified Survey Maps of Walworth
County on Page 102 and located in the Northwest 1/4
Section 36, Town 2 North, Range 16 East, Town of Delavan,
Walworth County, Wisconsin.

Surveyed for: **Jim Pfeil**
90 North Potawatomi Road - Unit 7D
Williams Bay, Wisconsin 53191

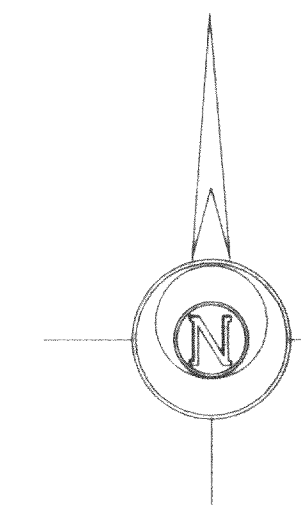

Bearings referenced to Certified
Survey Map No. 102.

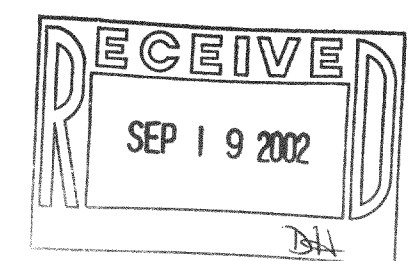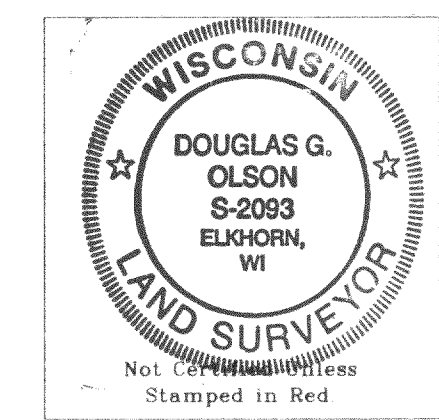

- Notes: 1) This survey plat is not
certified unless signed
and sealed in red ink.
- 2) This survey is subject to Wisconsin lien laws.
This Plat of Survey is the notice of intent
to file lien. Lien waiver required.


Copyright © 2001 by Jensen & Olson Land Surveying, LLC.

All rights reserved. No part of this survey plat may be reproduced
or transmitted in any form by any means - graphic, electronic, or
mechanical, including photocopying, tracing, or information storage
and retrieval systems - without permission in writing from Douglas
G. Olson, Jensen & Olson Land Surveying, LLC.

I, Douglas G. Olson, Wisconsin Registered Land Surveyor,
do hereby certify that this survey was performed by me or under my
direction in full compliance with the owner's/agent's instructions
and Chapter A-E 7 of the Wisconsin Administrative Code "Minimum
Standards for Property Surveys", and that this map is an accurate
representation thereof to the best of my knowledge and belief.

Douglas G. Olson
Wisconsin Registered Land Surveyor - 2093


Bailey Road (66' Wide)

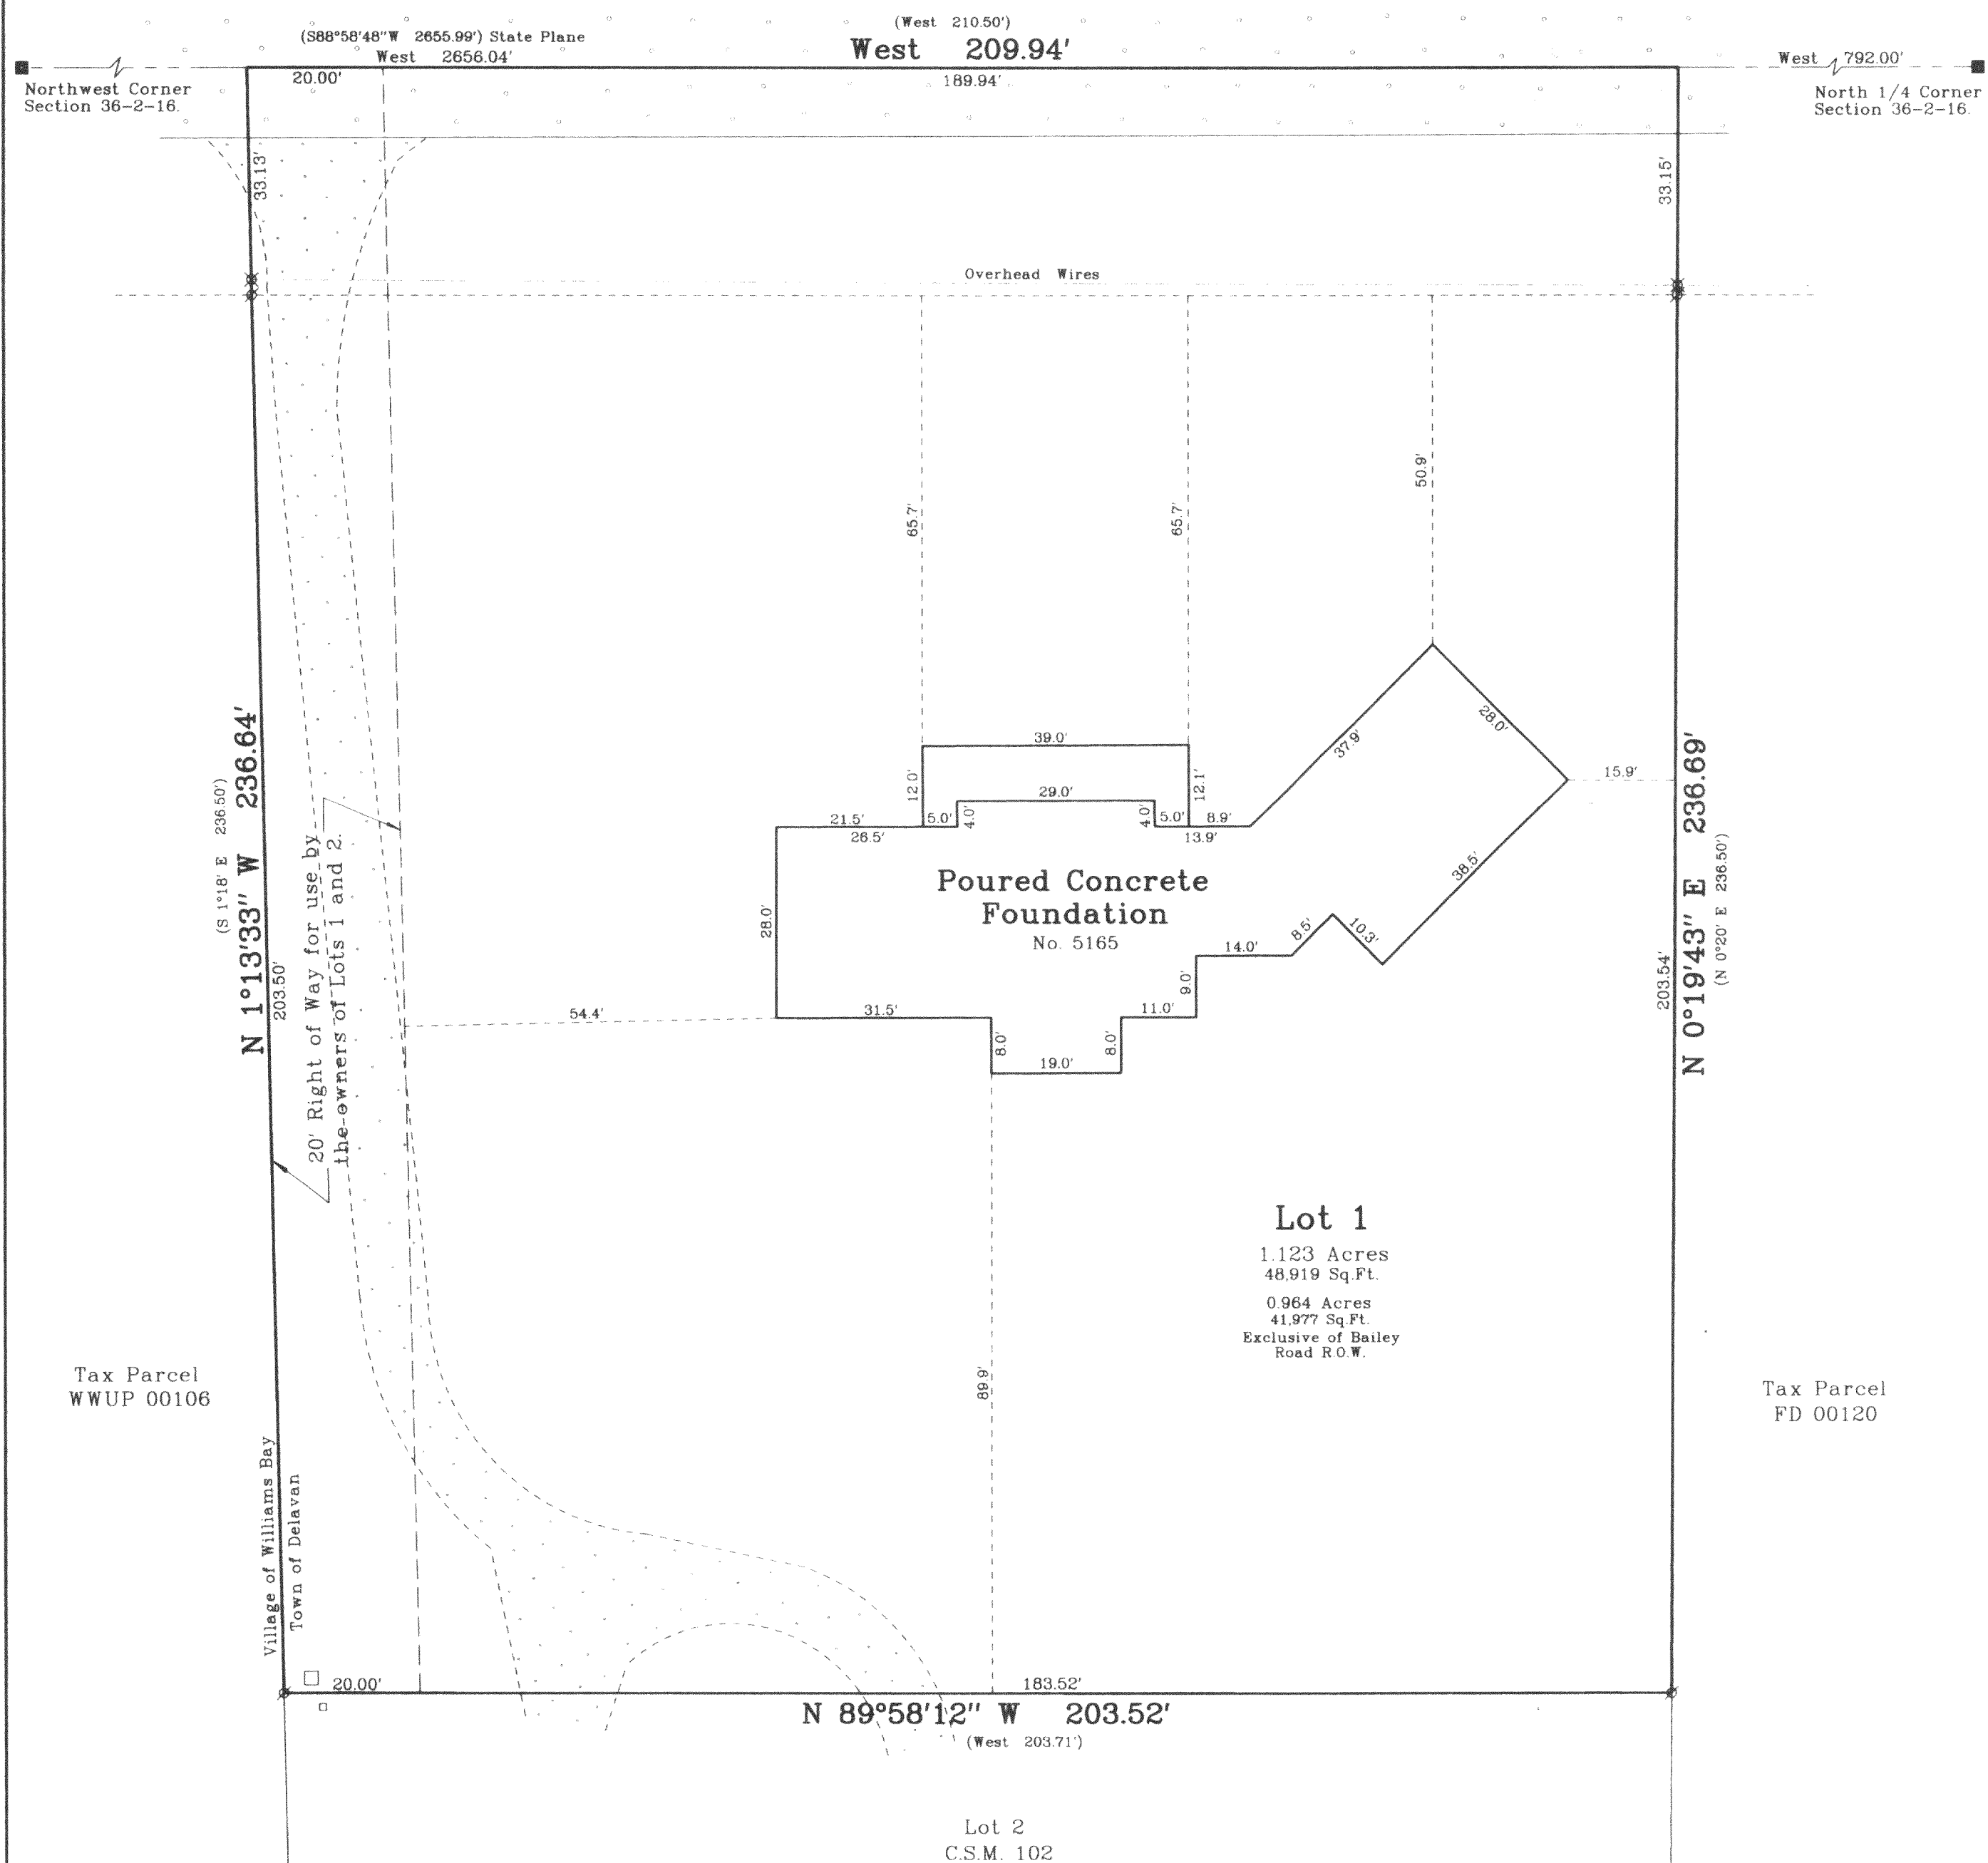

Tax Parcel
WWUP 00106

Tax Parcel
FD 00120

Survey Date: May 9, 2001.
Revisions:

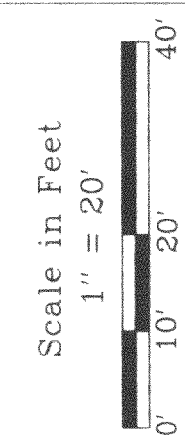

Jensen & Olson Land Surveying, LLC

45 South Wisconsin Street P.O. Box 322
Elkhorn, Wisconsin 53121
Telephone (262) 723-3434
Facsimile (262) 723-8044

Legend

- Found County Section Corner
- Found Iron Pipe
- Recorded Information
- Set Lath
- Set Wood Stake
- Utility Pole
- Utility Box or Pedestal

Sheet 1 of 1 Sheets

Job Reference Number
2001.059

2001.059

216-3260