
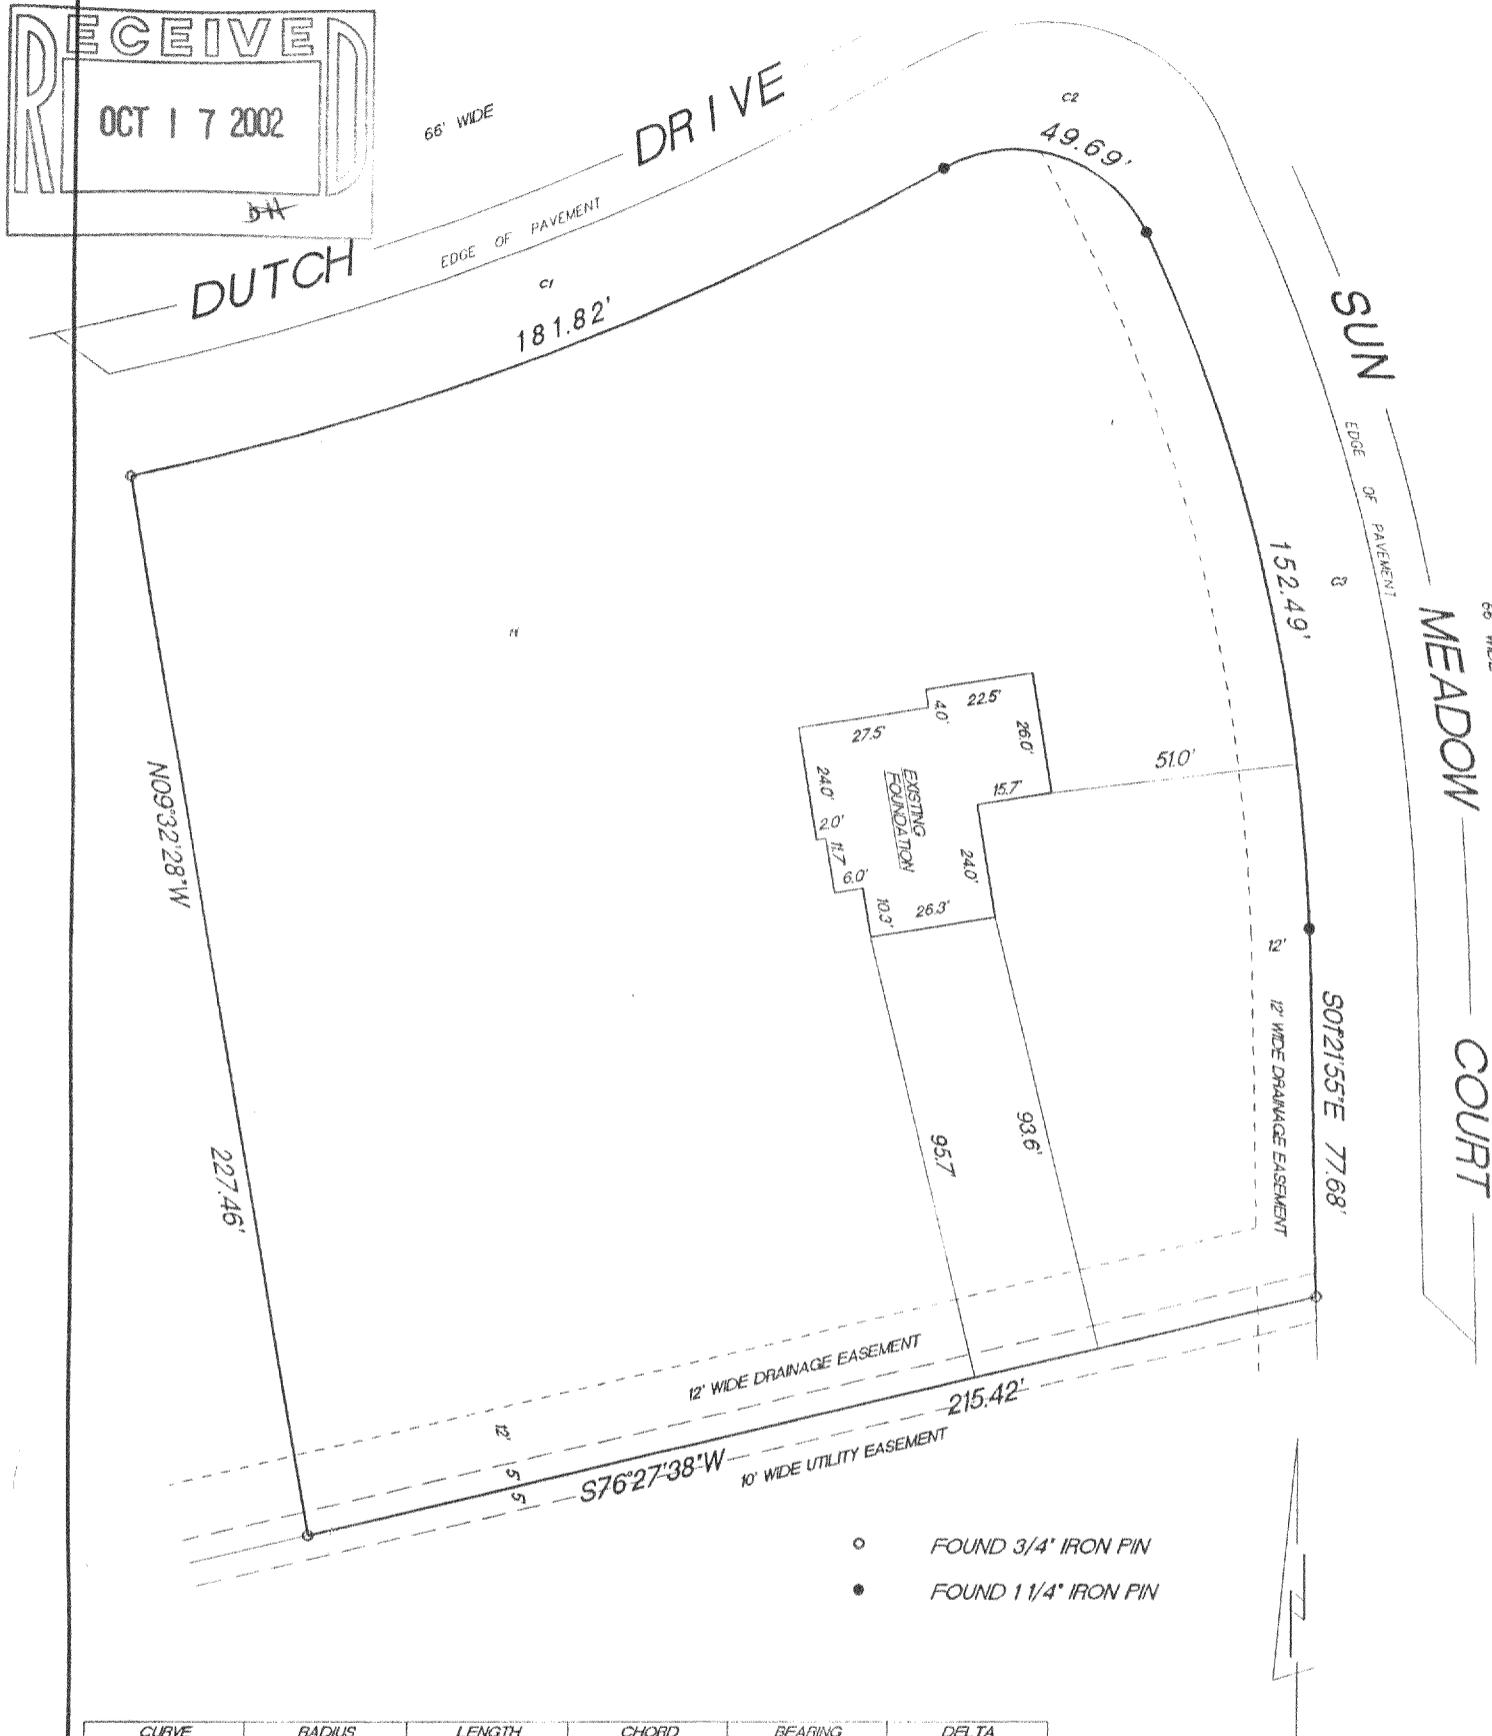


PLAT OF SURVEY

LOT 9, DUTCH MEADOWS SUBDIVISION, located in the Northwest  $\frac{1}{4}$  of Section 31, Town 2 North, Range 16 East, Town of Delavan, Walworth, County, Wisconsin.

Surveyed for: Bielinski Bros. Builders Inc./Armando, Sandra and Rosendo Huerta

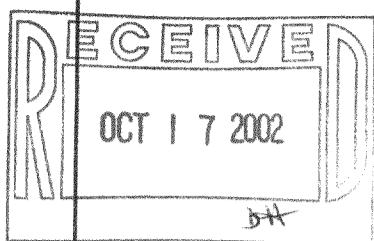

"I hereby certify that I have surveyed the above described property and that the above map is a true representation thereof and shows the size and location of the property, its exterior boundaries, the location of all visible structures and dimension of all principal buildings thereon, boundary fences, apparent easements, roadways and encroachments if any."

"This survey is made for the use of the present owners of the property, and also those who purchase, mortgage or guarantee the title thereto within one year from date hereof."

REV. 10/3/02  
7/24/02

TEP/DW

TEP

02114

DATE

FIELD WORK BY

DRAWN BY

JOB NUMBER

THIS IS NOT AN ORIGINAL SURVEY UNLESS THE SEAL IS RED.



216-3271

✓ FDU T-9