


GEORGE T. DUNHAM  
SURVEYING & SUBDIVIDING  
DELAVER, WISCONSIN

N

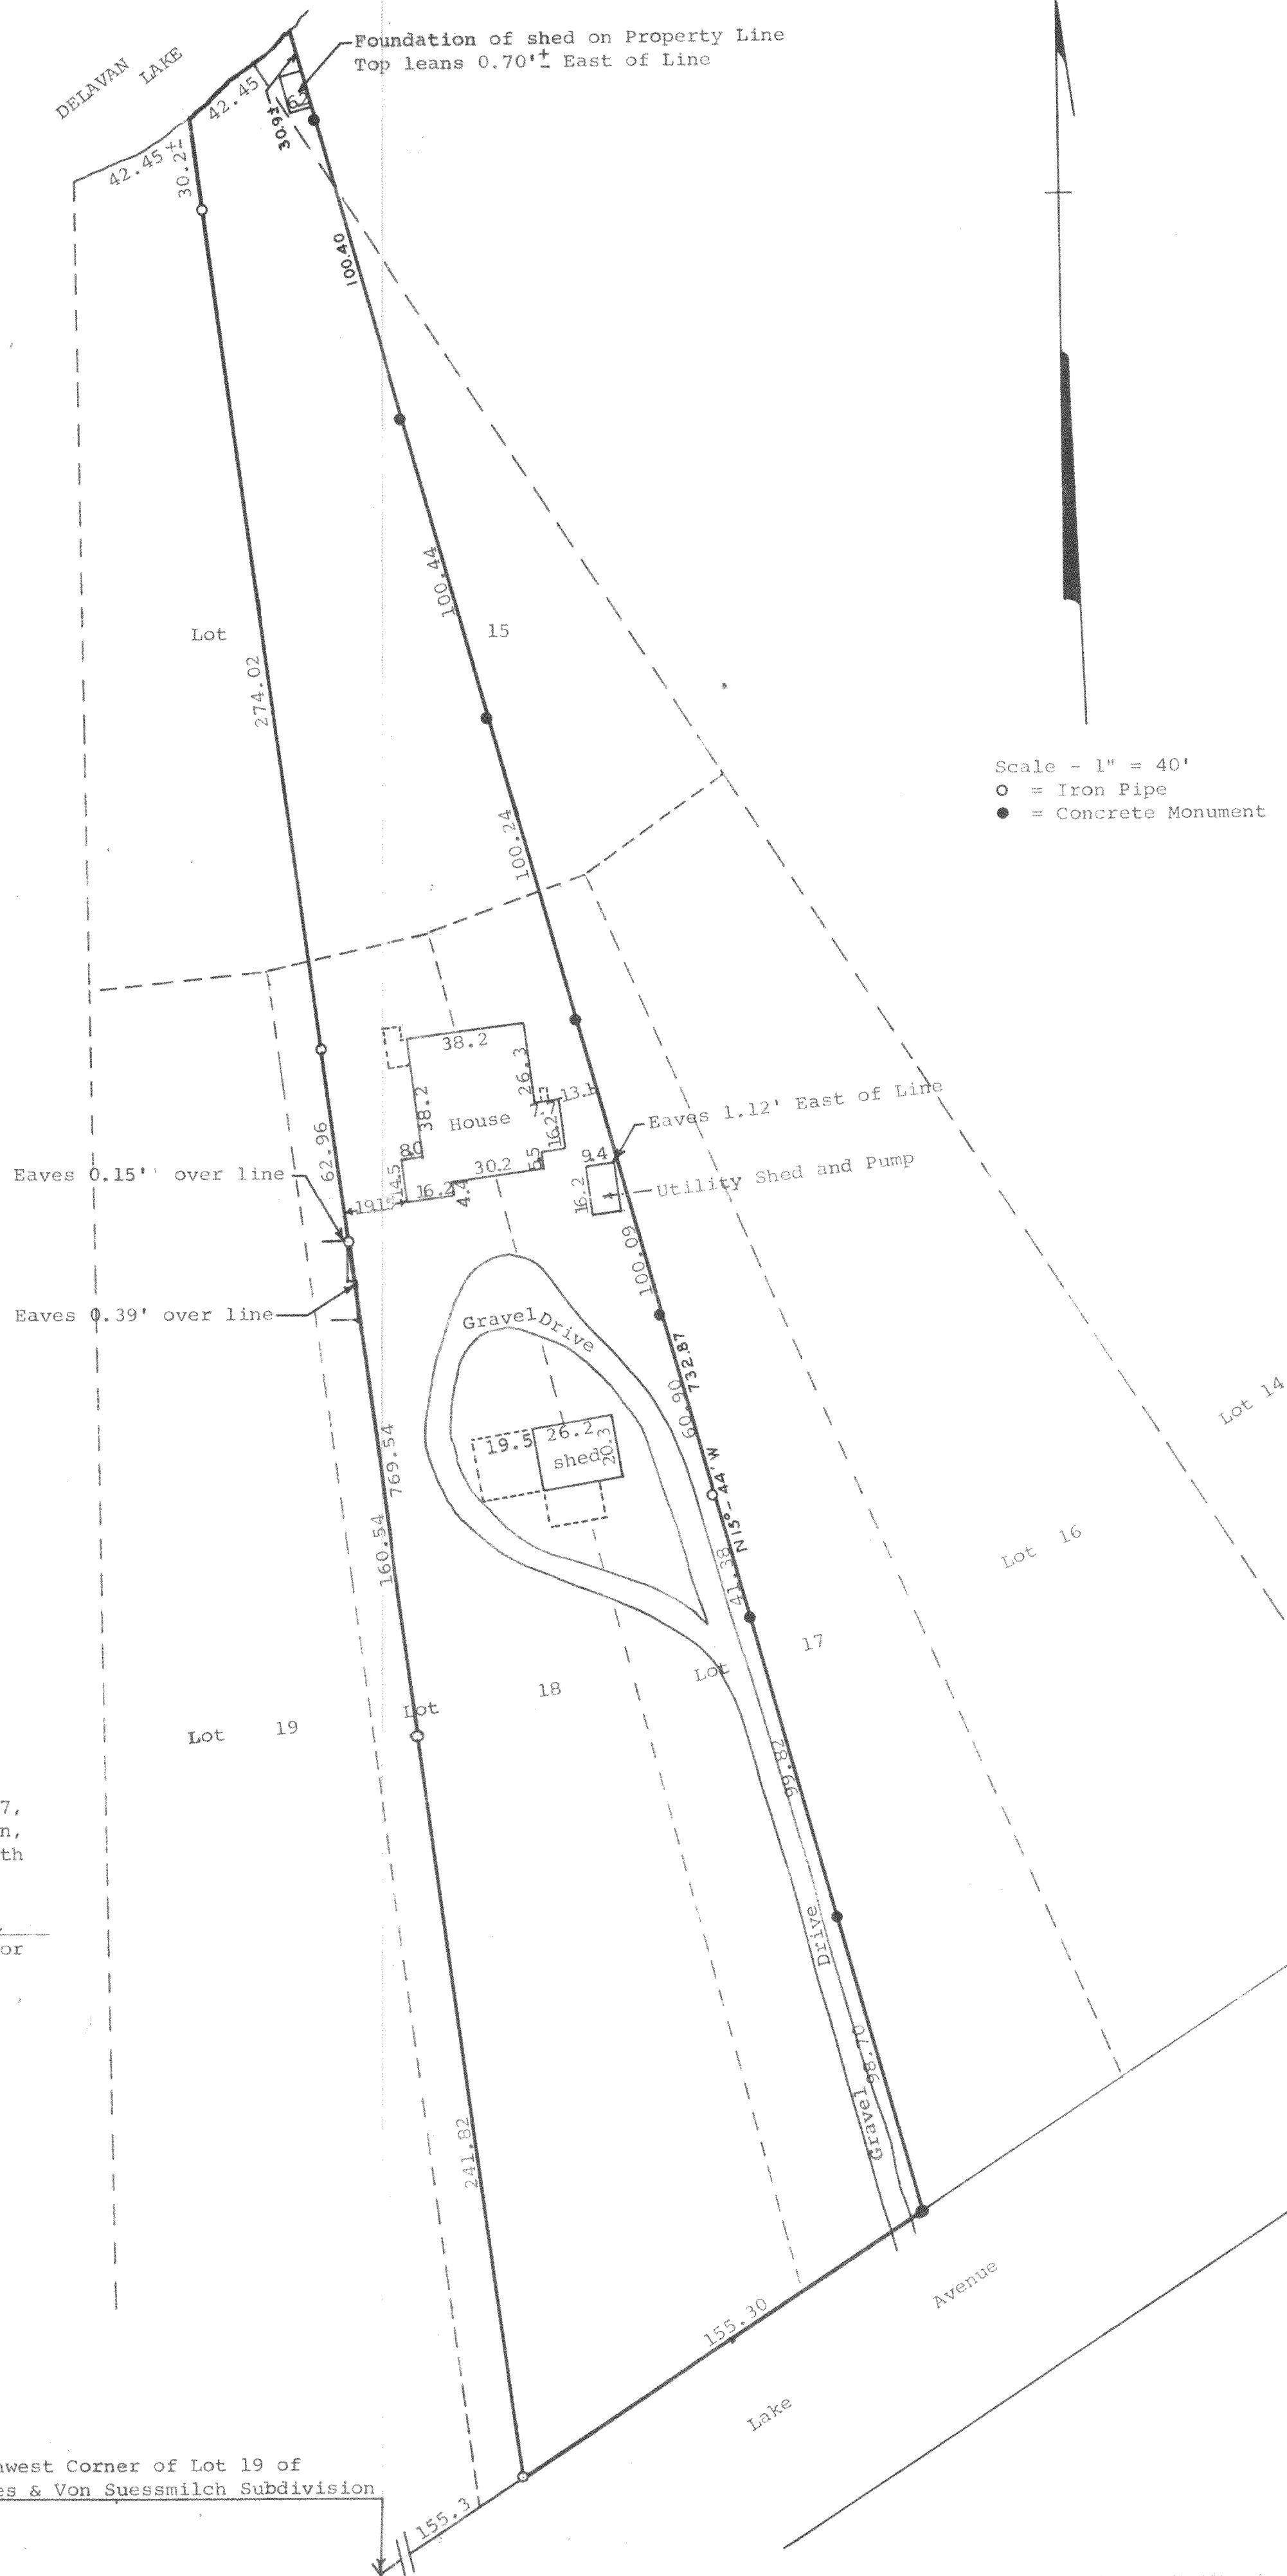

Plat of survey of part of Lots 14, 15, 16, 17,  
and 18 of Barnes & Von Suessmilch Subdivision,  
located in Section 33, T 2 N, R 16 E, Walworth  
County, Wisconsin.  
October, 1969

*George T. Dunham*  
George T. Dunham, Surveyor

FBA-8  
11 9  
11 10