


ABELL
SURVEYING & MAPPING

1140 SEQUOIA STREET • DELAVAN, WISCONSIN 53115

262-728-6737

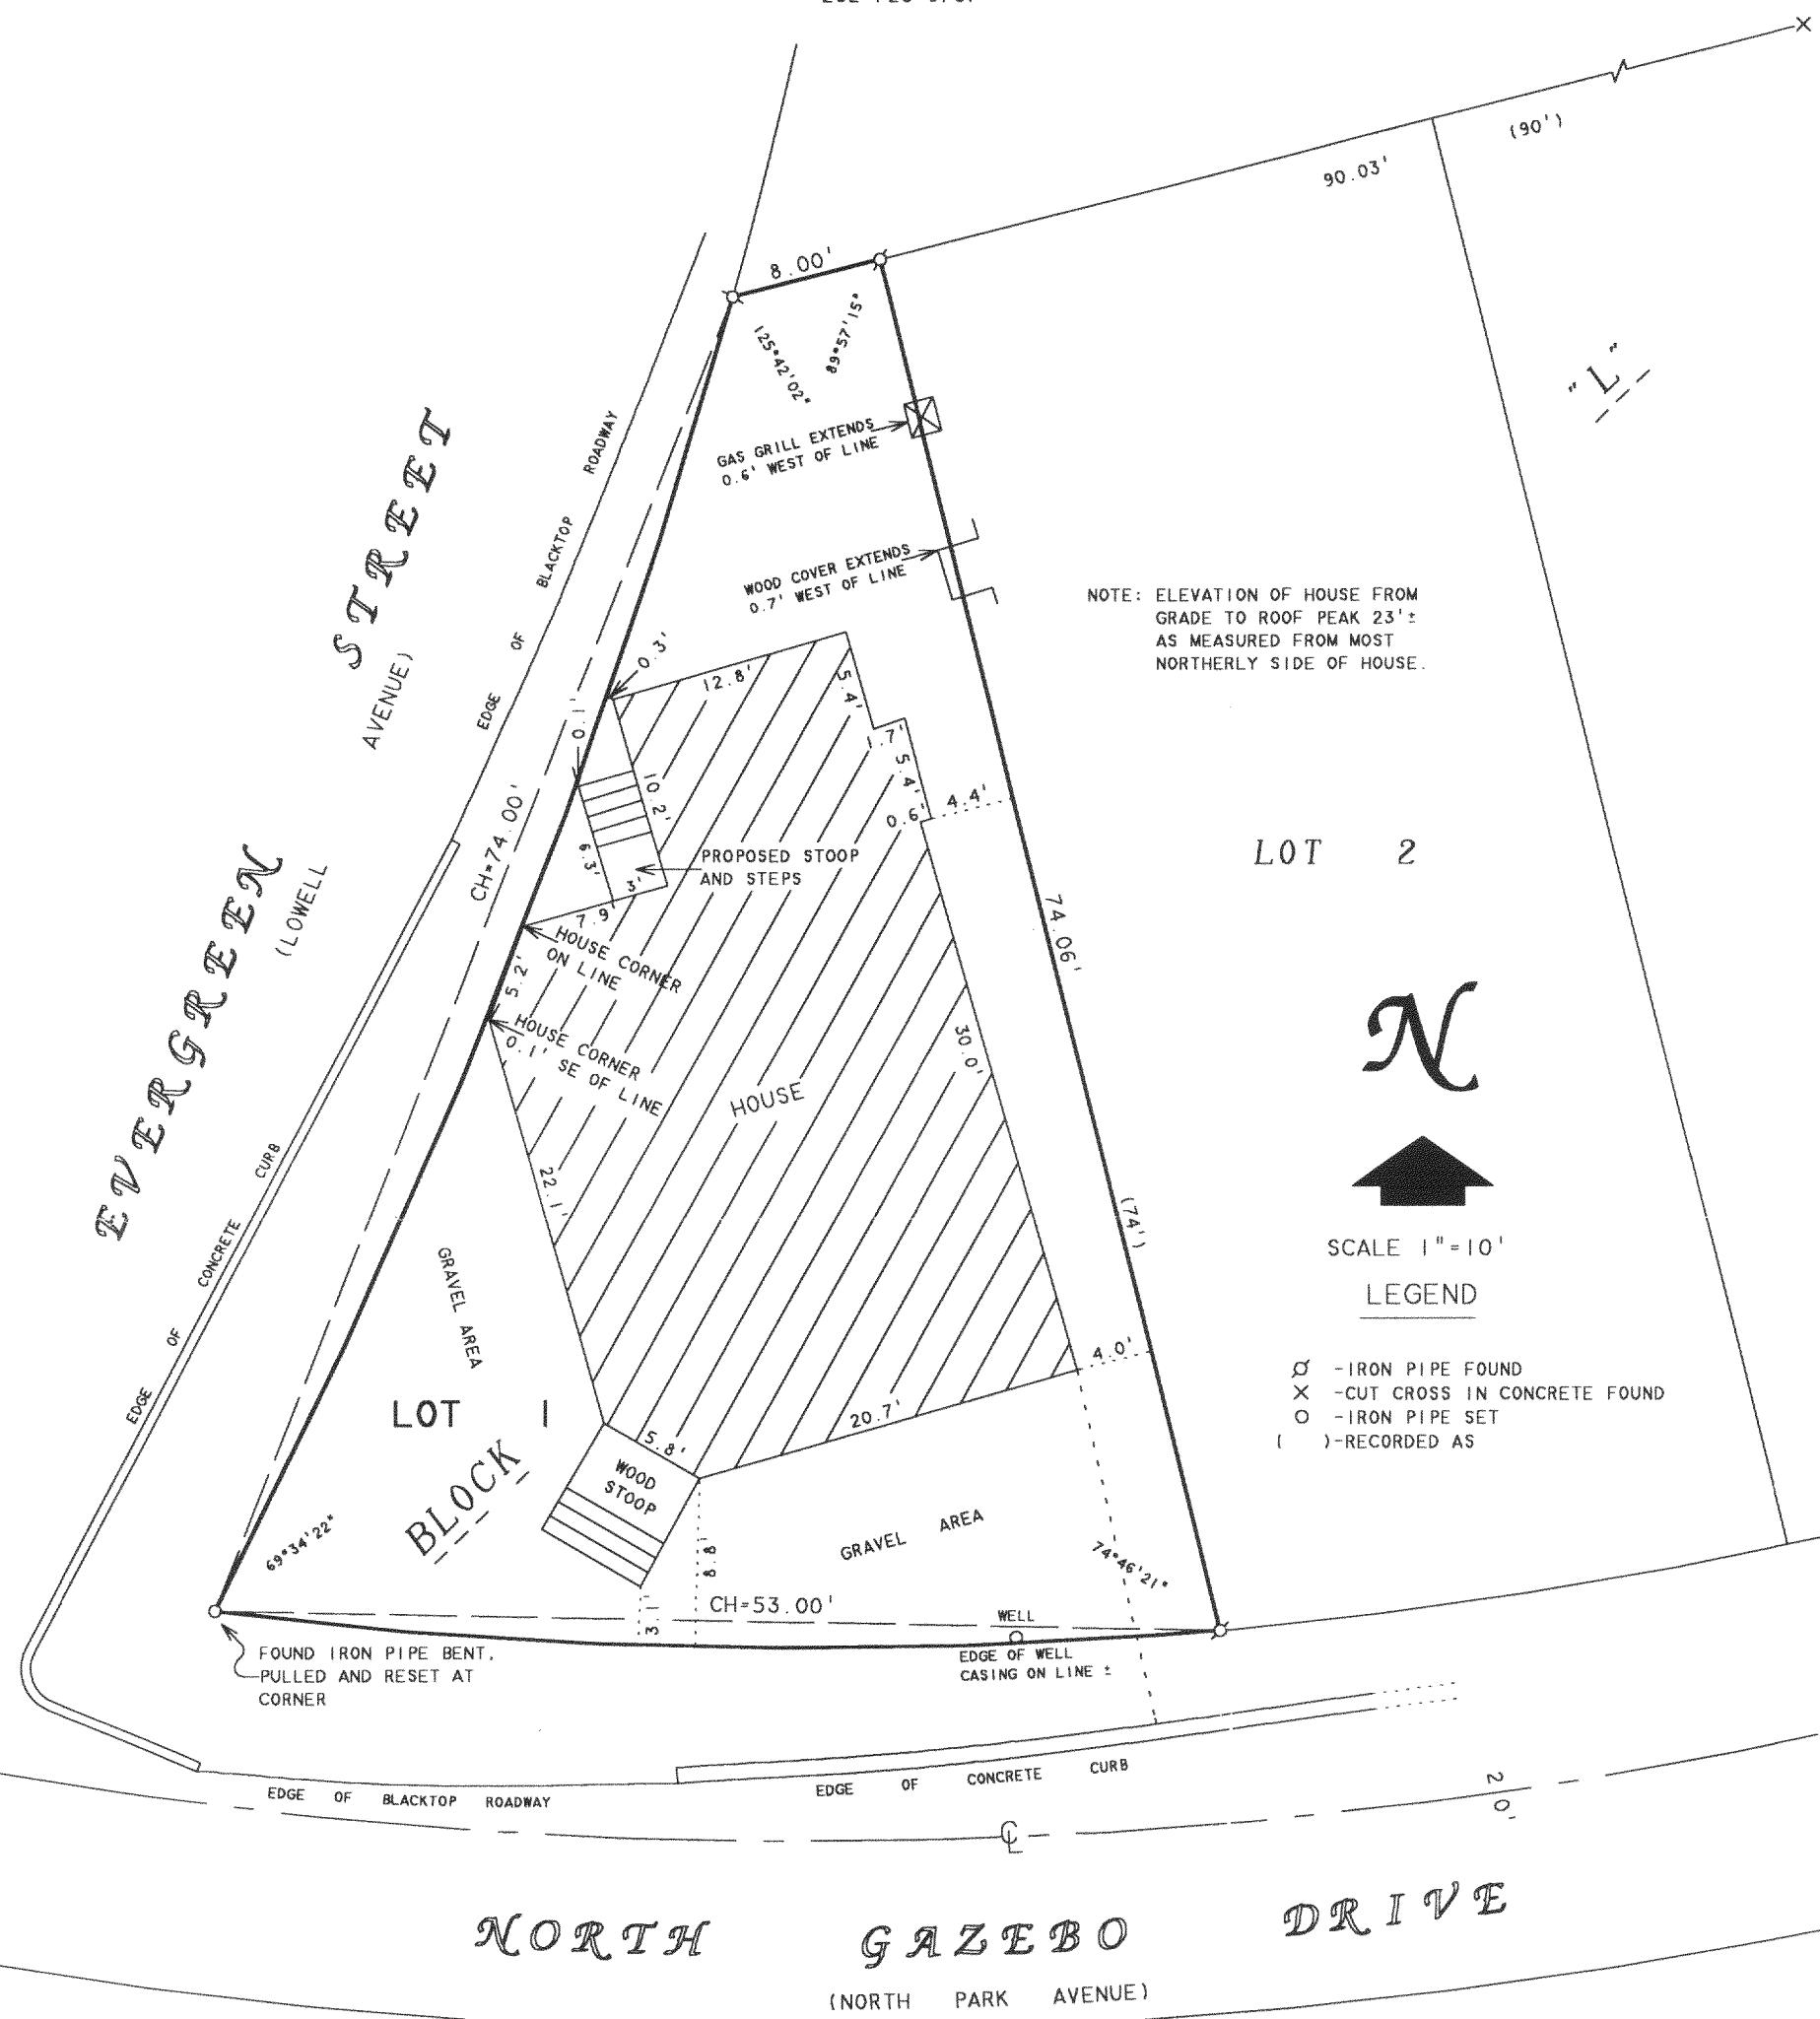

PLAT OF SURVEY OF

LOT 1, BLOCK "L", DELAVAN LAKE ASSEMBLY GROUNDS, LOCATED IN T2N, R16E, WALWORTH COUNTY, WISCONSIN.

ORDERED BY: GENE PURCELL
1103 COMPTON
ADDISON, IL 60101

REVISED DATE: SEPTEMBER 16, 2002
REVISED TO SHOW MODIFICATIONS TO PROPOSED STOOP AND STEPS.

REVISED DATE: SEPTEMBER 12, 2002
REVISED TO SHOW MODIFICATIONS TO HOUSE AND PROPOSED STOOP AND STEPS.

ORDERED BY: JIM O'DONNELL
13726 S 88th AVENUE
ORLAND PARK, IL 60462

I, DAVID F. ABELL, DO HEREBY CERTIFY THAT I HAVE SURVEYED THE PROPERTY HEREON DESCRIBED ACCORDING TO THE OFFICIAL RECORDS AND THAT THE PLAT HEREON IS A CORRECT REPRESENTATION OF THE PROPERTY LINES TO THE BEST OF MY KNOWLEDGE AND BELIEF

David F. Abell

DAVID F. ABELL
WISCONSIN REGISTERED LAND SURVEYOR, S-1596

October 17, 1996

DATE: OCTOBER 17, 1996
JOB NUMBER - 96180B
NOTE: THIS IS NOT A CERTIFIED COPY UNLESS SEALED.

NOV 12 2002

DA

✓ FDLA-117

216-3282