

ABERNATHY and ASSOCIATES


Kenneth B. Abernathy Jr.

Wisconsin Registered Land Surveyor S-1594


W4056 BRAY RD.
ELKHORN, WI. 53121
PHONE: (262) 723-4260 (OFFICE)
(262) 723-7209 (FAX)
Email: abernathy@elknet.net

PLAT OF SURVEY

LOT 4 OF MABIE WOOD, A SUBDIVISION LOCATED IN THE
SOUTHEAST 1/4 OF SECTION 21, TOWN 2 NORTH, RANGE 16 EAST,
DELAVAN TOWNSHIP, WALWORTH COUNTY, WISCONSIN.

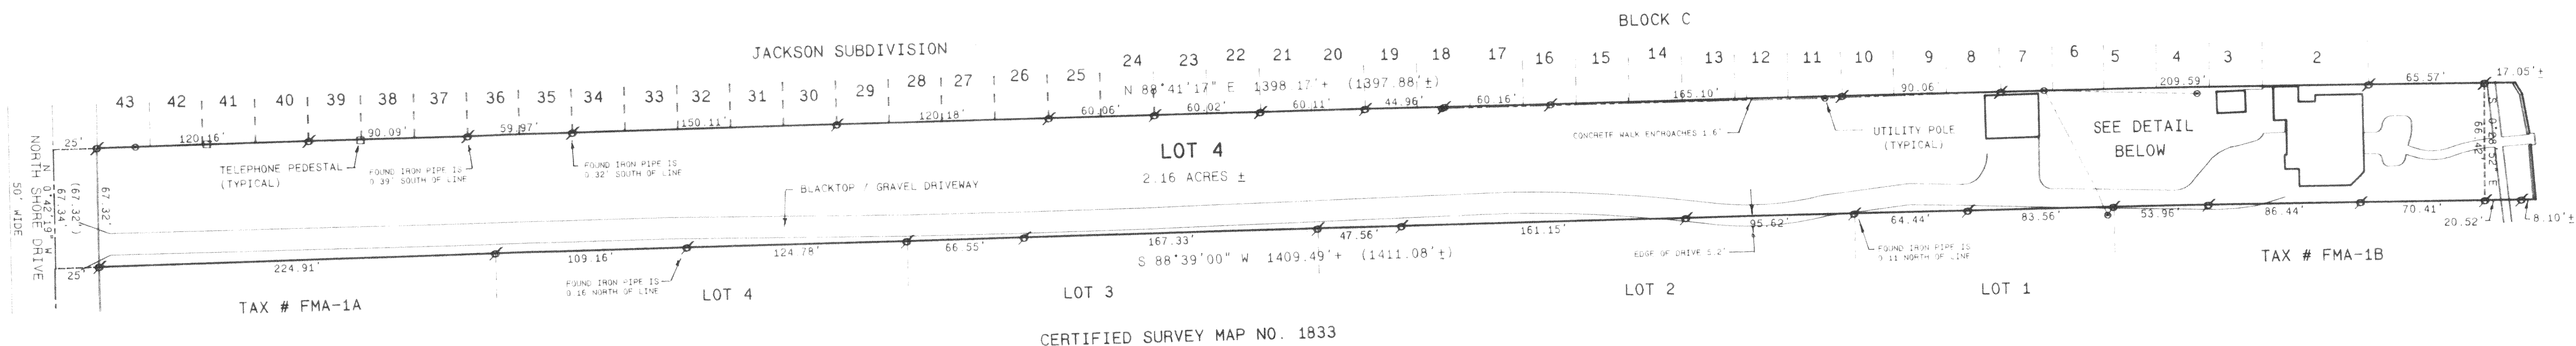

NOTE:
100 YEAR FLOOD ELEVATION 429.00 FALLS ON SIDE OF
STONE SEAWALL. LAKE ELEVATION ON JANUARY 30, 2002
= 527.68

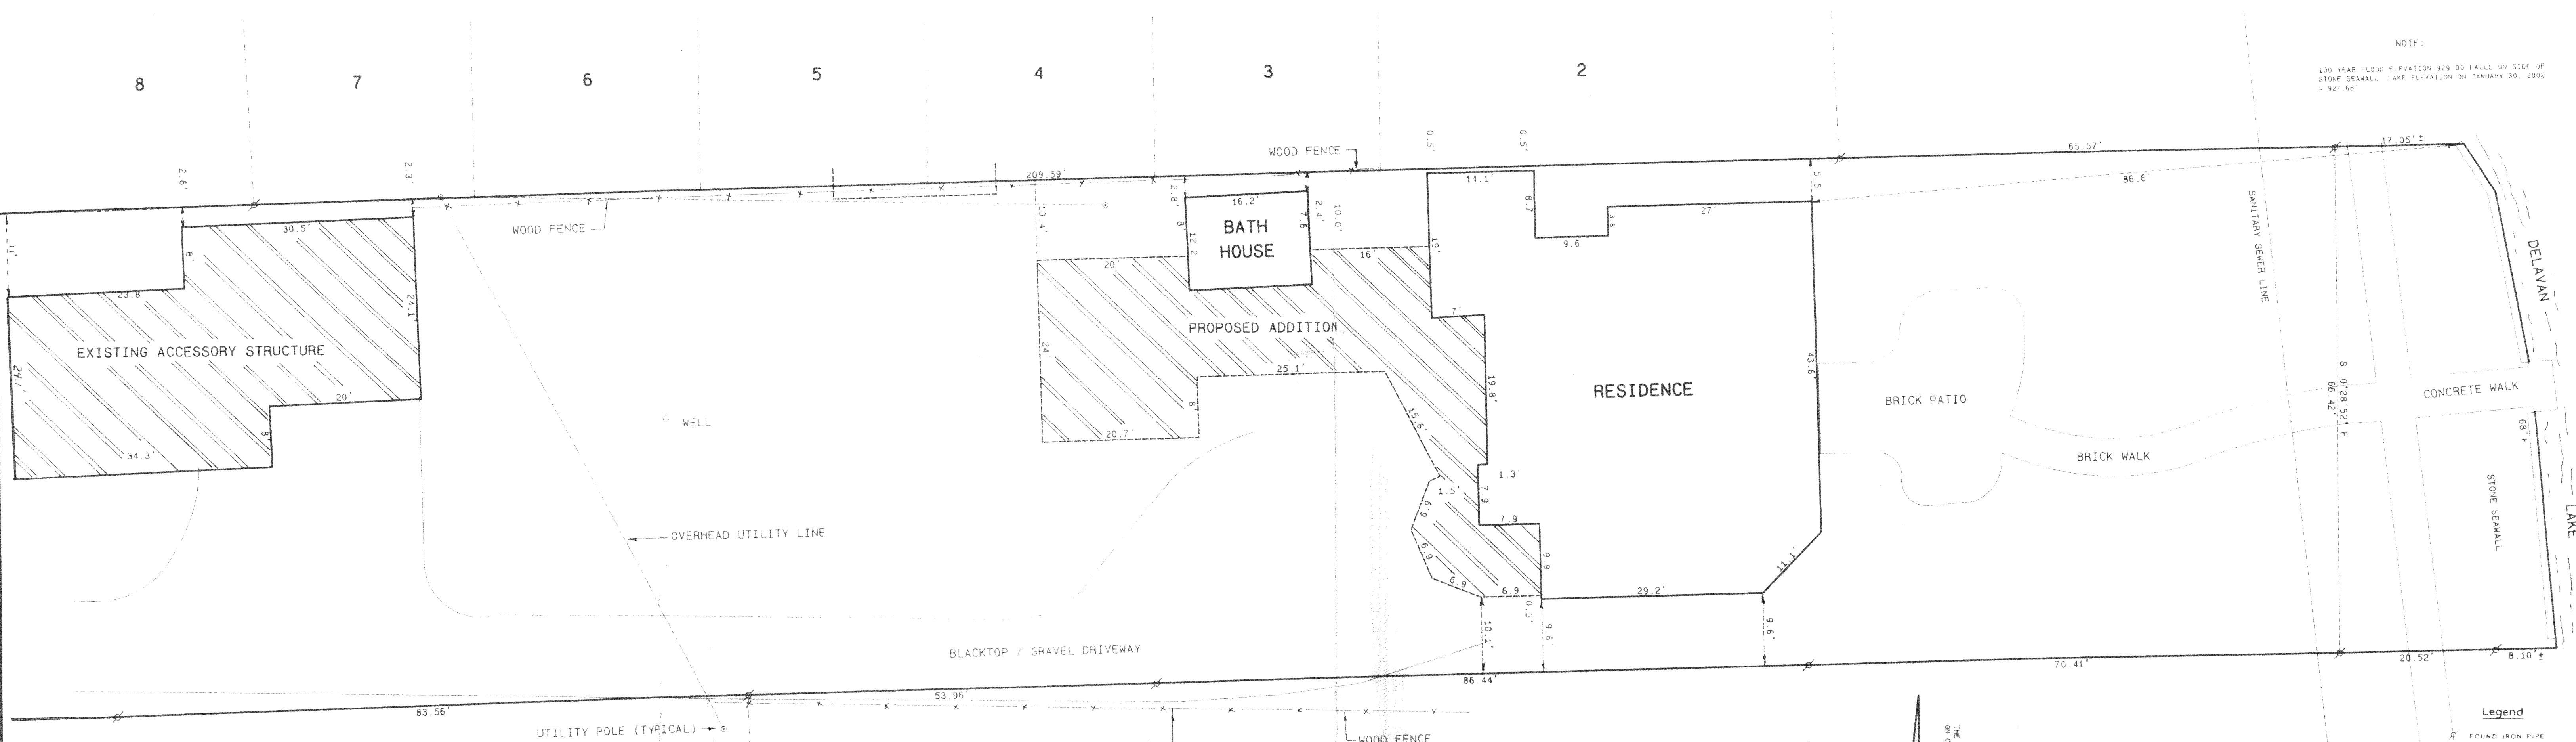

LOT 4, CERTIFIED SURVEY MAP NO. 1833

ORDERED BY: HOME DESIGN MANUFACTURING
N2002 HWY "67"
POST OFFICE BOX 527
FONTANA, WI 53125

OWNER: CHARLENE A. MEHLHAFF
P.O. BOX 22
DELAVAN, WI 53115


TAX KEY NO. FMA-1B



THE SOUTH LINE OF LOT 4 HAS ASSUMED S 88°39' W AS PLATTED
ON CERTIFIED SURVEY MAP NO. 1833

NOTE
THIS PLAT HAS BEEN REVISED ON JUNE 25,
2002 TO SHOW PROPOSED ADDITIONS. THE
BUILDER IS TO VERIFY DIMENSIONS WHICH
HAVE BEEN ROUNDED TO THE NEAREST TENTH
OF A FOOT TO INSURE PROPER PLAN
INTERPRETATION AND CONTACT THIS OFFICE
IMMEDIATELY IF ANY DISCREPANCY EXISTS.

REVISED 7/10/02
REVISED NOV. 1, 2002 TO SHOW
THE ACCESSORY STRUCTURE "AS BUILT"

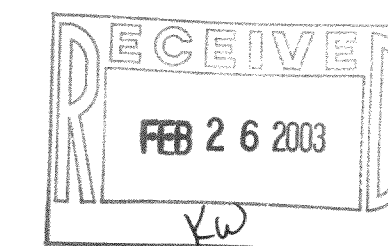

SCALE: 1"=50 FEET

SCALE: 1 INCH = 50 FEET
DETAIL: 1 INCH = 10 FEET

I hereby certify that the above described property has been surveyed
by me or under my direction and that the above map is a true
representation thereof and shows the size and location of the property,
its exterior boundaries, the location of all visible structures, and
dimensions of all principal buildings thereon, boundary fences, apparent
easements, roadways and visible encroachments, if any.
This survey is made for the use of the present owners of the property
and also those who purchase, mortgage, or guarantee the same
within one year from date hereof.

Kenneth B. Abernathy, Jr.
KENNETH B. ABERNATHY, JR.
WISCONSIN REGISTERED LAND SURVEYOR,
S-1594
Date: FEB. 8, 2002 Job No. 02-301

216-3315