

ABELL
SURVEYING & MAPPING

1140 SEQUOIA STREET • DELAVAN, WISCONSIN 53115

262-728-6737

N


SCALE 1" = 20'

LEGEND

- - IRON PIPE FOUND
- * - WOOD FENCE
- XXX - CHAINLINK FENCE
- XX - WIRE FENCE
- () - RECORDED AS

STREET

PLEASANT

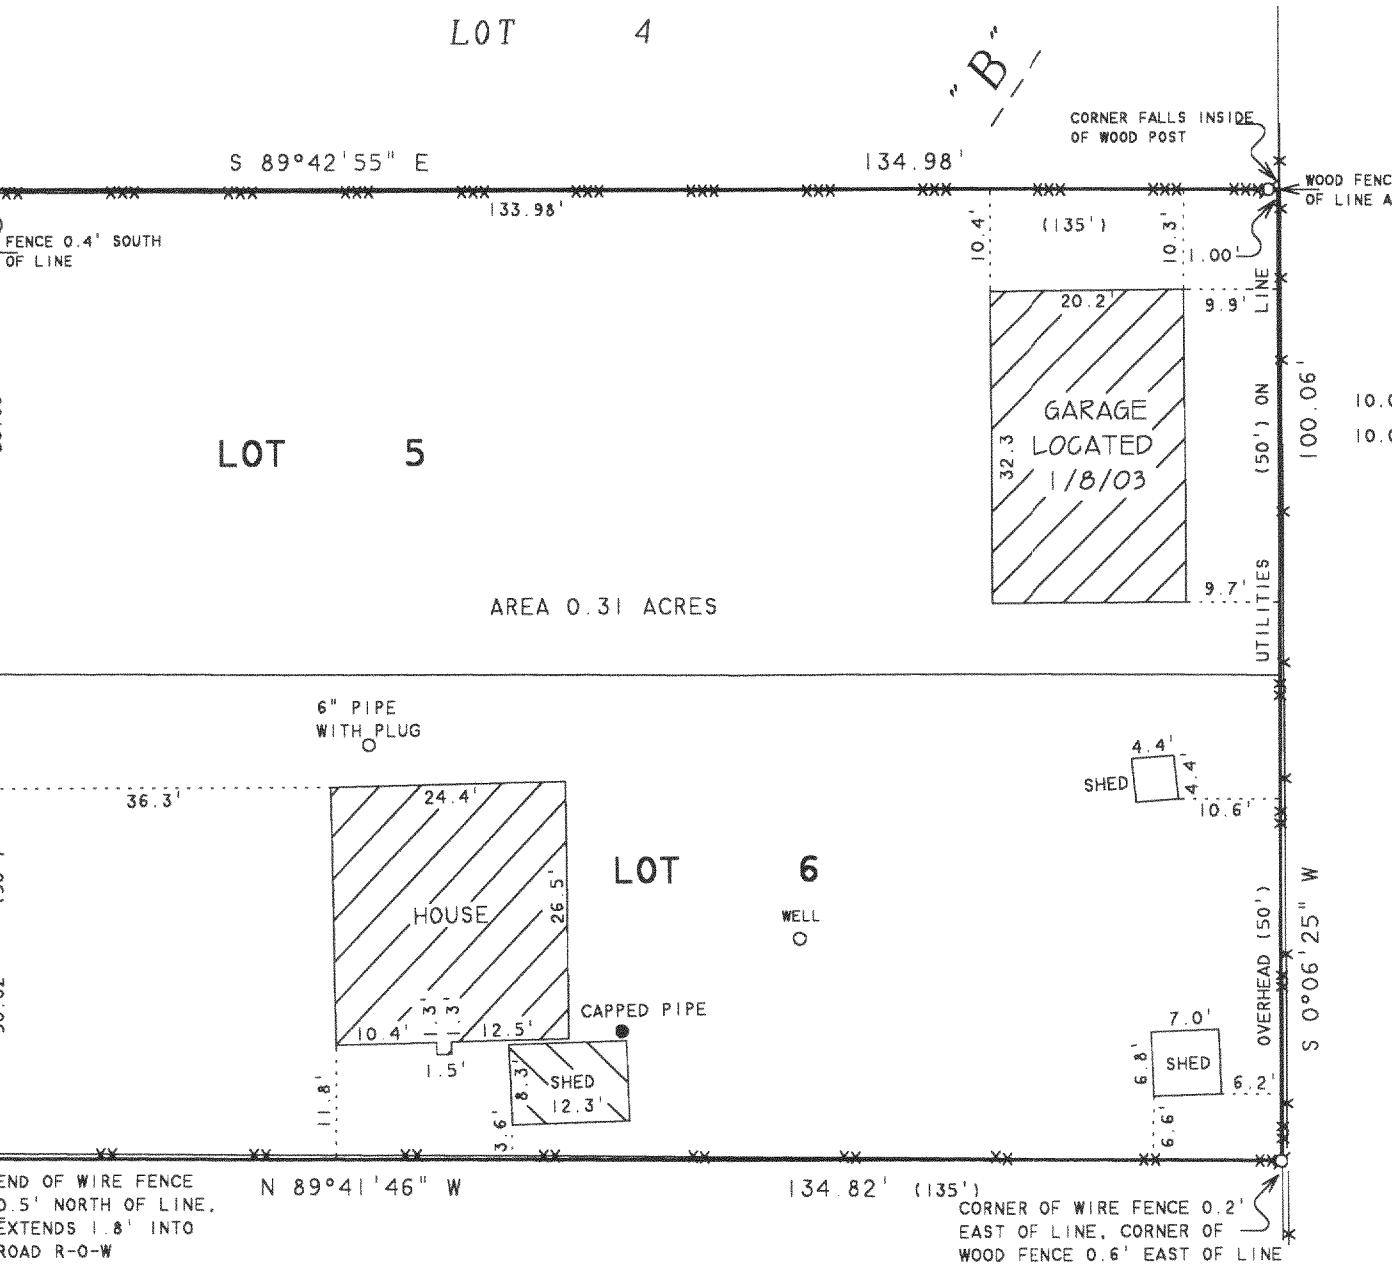

BLOCK

MAR 5 2003

REVISED DATE: JANUARY 9, 2003
REVISED TO SHOW GARAGE LOCATION.

REVISED DATE: JULY 26, 2002
REVISED TO SHOW PROPOSED GARAGE LOCATION

ORDERED BY: GEORGE KOPP
140 ST. ANDREWS TRAIL
FONTANA, WI 53125

PLAT OF SURVEY OF

LOTS 5 AND 6, BLOCK "B", MAPLE HURST, LOCATED IN T2N, R16E, WALWORTH COUNTY, WISCONSIN.

I HEREBY CERTIFY THAT I HAVE SURVEYED THE ABOVE DESCRIBED PROPERTY AND THAT THE ABOVE MAP IS A TRUE REPRESENTATION THEREOF AND SHOWS THE SIZE AND LOCATION OF THE PROPERTY, ITS EXTERIOR BOUNDARIES, THE LOCATION OF ALL VISIBLE STRUCTURES AND DIMENSIONS OF ALL PRINCIPAL BUILDINGS THEREON, BOUNDARY FENCES, APPARENT EASEMENTS, ROADWAYS AND VISIBLE ENCROACHMENTS, IF ANY, TO THE BEST OF MY KNOWLEDGE AND BELIEF.

THIS SURVEY IS MADE FOR THE USE OF THE PRESENT OWNERS OF THE PROPERTY, AND ALSO THOSE WHO PURCHASE, MORTGAGE, OR GUARANTEE THE TITLE THERETO WITHIN ONE (1) YEAR FROM DATE HEREON.

David F. Abell

DAVID F. ABELL
WISCONSIN REGISTERED LAND SURVEYOR, S-1596

July 24, 2002

DATE JOB NUMBER - 02108B
NOTE: THIS IS NOT A CERTIFIED COPY UNLESS SEALED.

FMH-13

216-3323