


DUNHAM SURVEYING
SURVEYING & SUBDIVIDING
DELAVER, WISCONSIN 53115

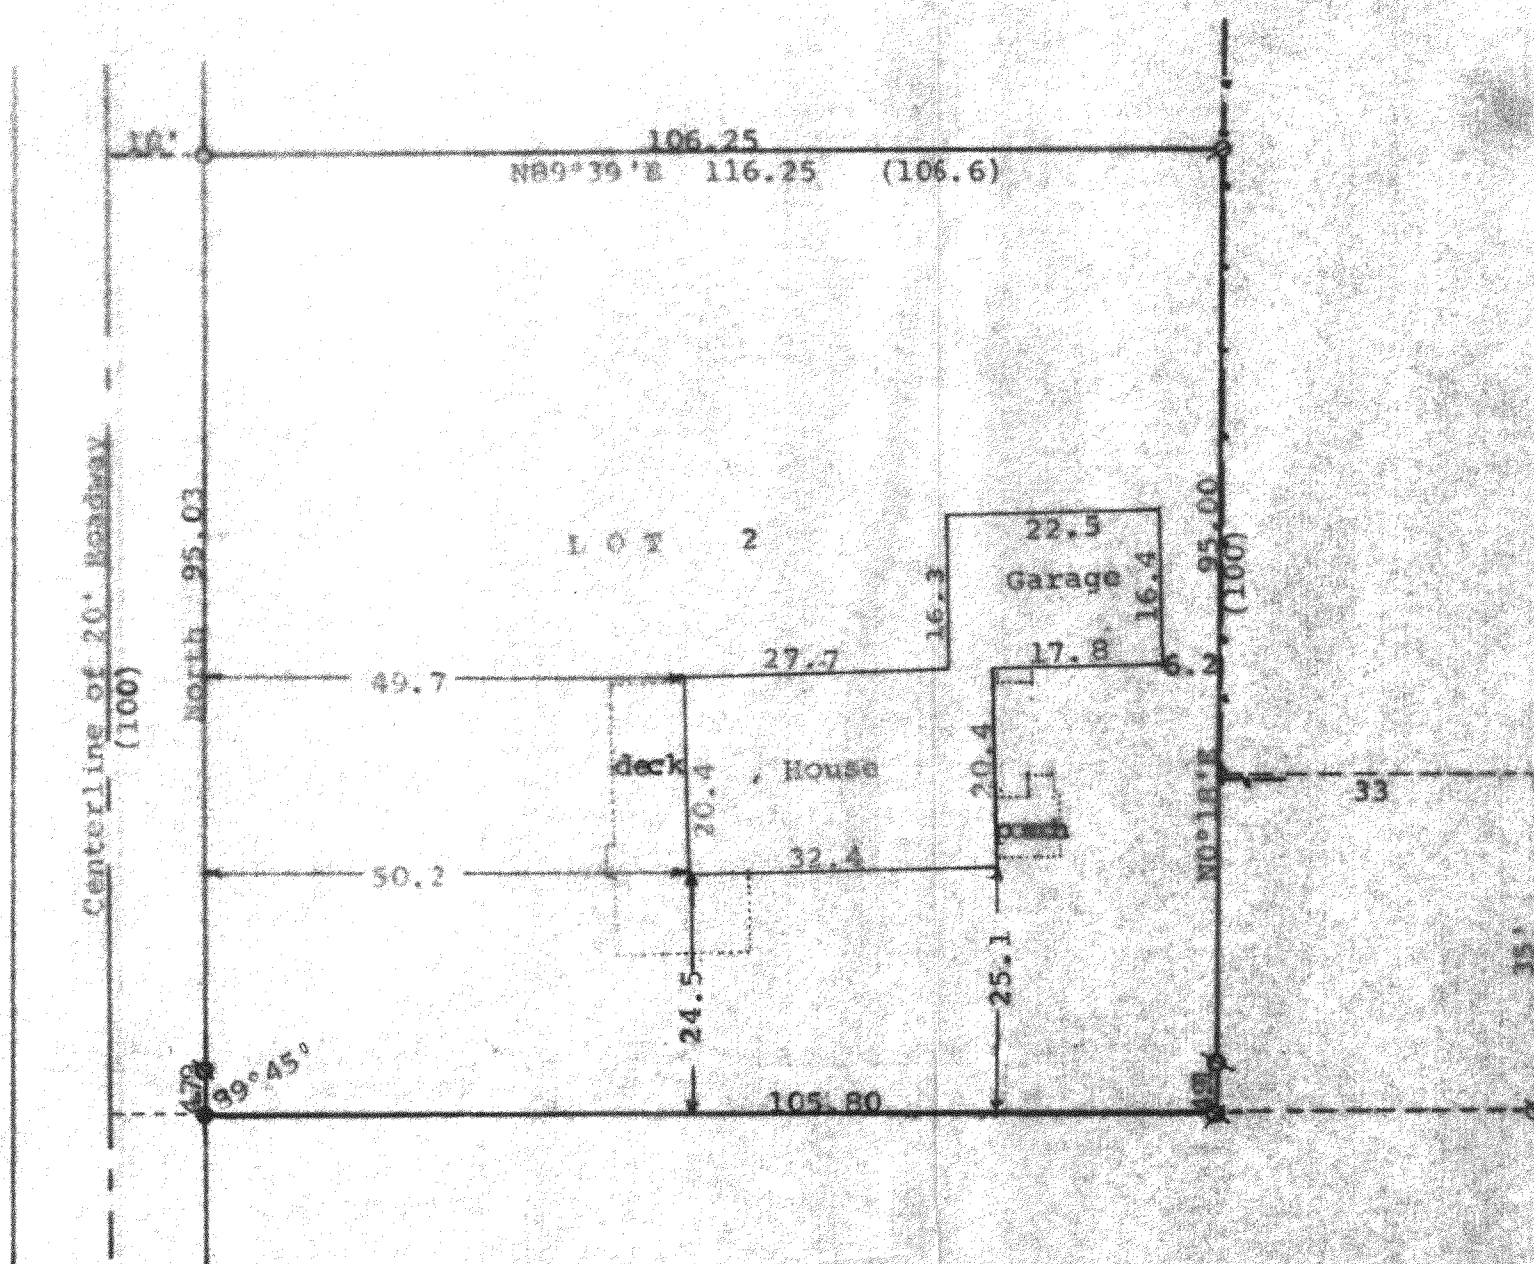

Scale - 1" = 20'
 ⚬ = 1/4" Iron Pipe Found
 ⚬ = 3/4" Iron Pipe Found
 --- = Fence Line
 (0.00) = recorded distance
 Survey ordered by:
 Century 21, Skandia Realty
 112 South 7th Street
 Delavan, WI 53115
 Updating and recertification ordered by:
 Century 21, Skandia Realty
 112 South 7th Street
 Delavan, WI 53115
 Updating and recertification ordered by:
 Twin Lakes Realty
 P.O. Box 1026
 Twin Lakes, WI 53181
 ⚬ = Iron Rod Found
 ⚬ = 3/4" Iron pipe set

STATE OF WISCONSIN) ss
 COUNTY OF WALWORTH)

I, George T. Dunham, Surveyor, certify that I have surveyed the property described as follows:

Lot 2 in Chicago Club Subdivision located in the Northeast 1/4 of Section 31, T 2 N, R 16 E, Walworth County, Wisconsin, excepting therefrom a tract 33 feet by 35 feet in the southeast corner thereof.

and that the plat shown hereon is a correct representation thereof and shows the size and location of the property, its exterior boundaries, the location of all visible structures and dimensions of all principal buildings thereon, boundary fences, apparent easements, roadways and visible encroachments, if any, and that I have surveyed the property hereon described, according to the official records, to the best of my knowledge and belief.

August 9, 1991

Updated and recertified to this 13th day of July, 1994

Updated and recertified to this 14th day of October, 2002

George T. Dunham
 George T. Dunham, Surveyor

