


DUNHAM SURVEYING, S.C.
SURVEYING & SUBDIVIDING
DELAVER, WISCONSIN 53115

A Plat of a Survey:
Lots 18, 19, and 20, Block 19 of Delavan Lake
View Crest Subdivision, Section 31, T 2 N,
R 16 E, Walworth County, Wisconsin.
October 27, 1978
Updated October 31, 2002
to show house location
Updating survey ordered by:
R. J. P. Custun Inc.
Judy Mygad
3759 Grandmore Ave.
Gurnee, IL 60031

George T. Dunham
George T. Dunham, Surveyor

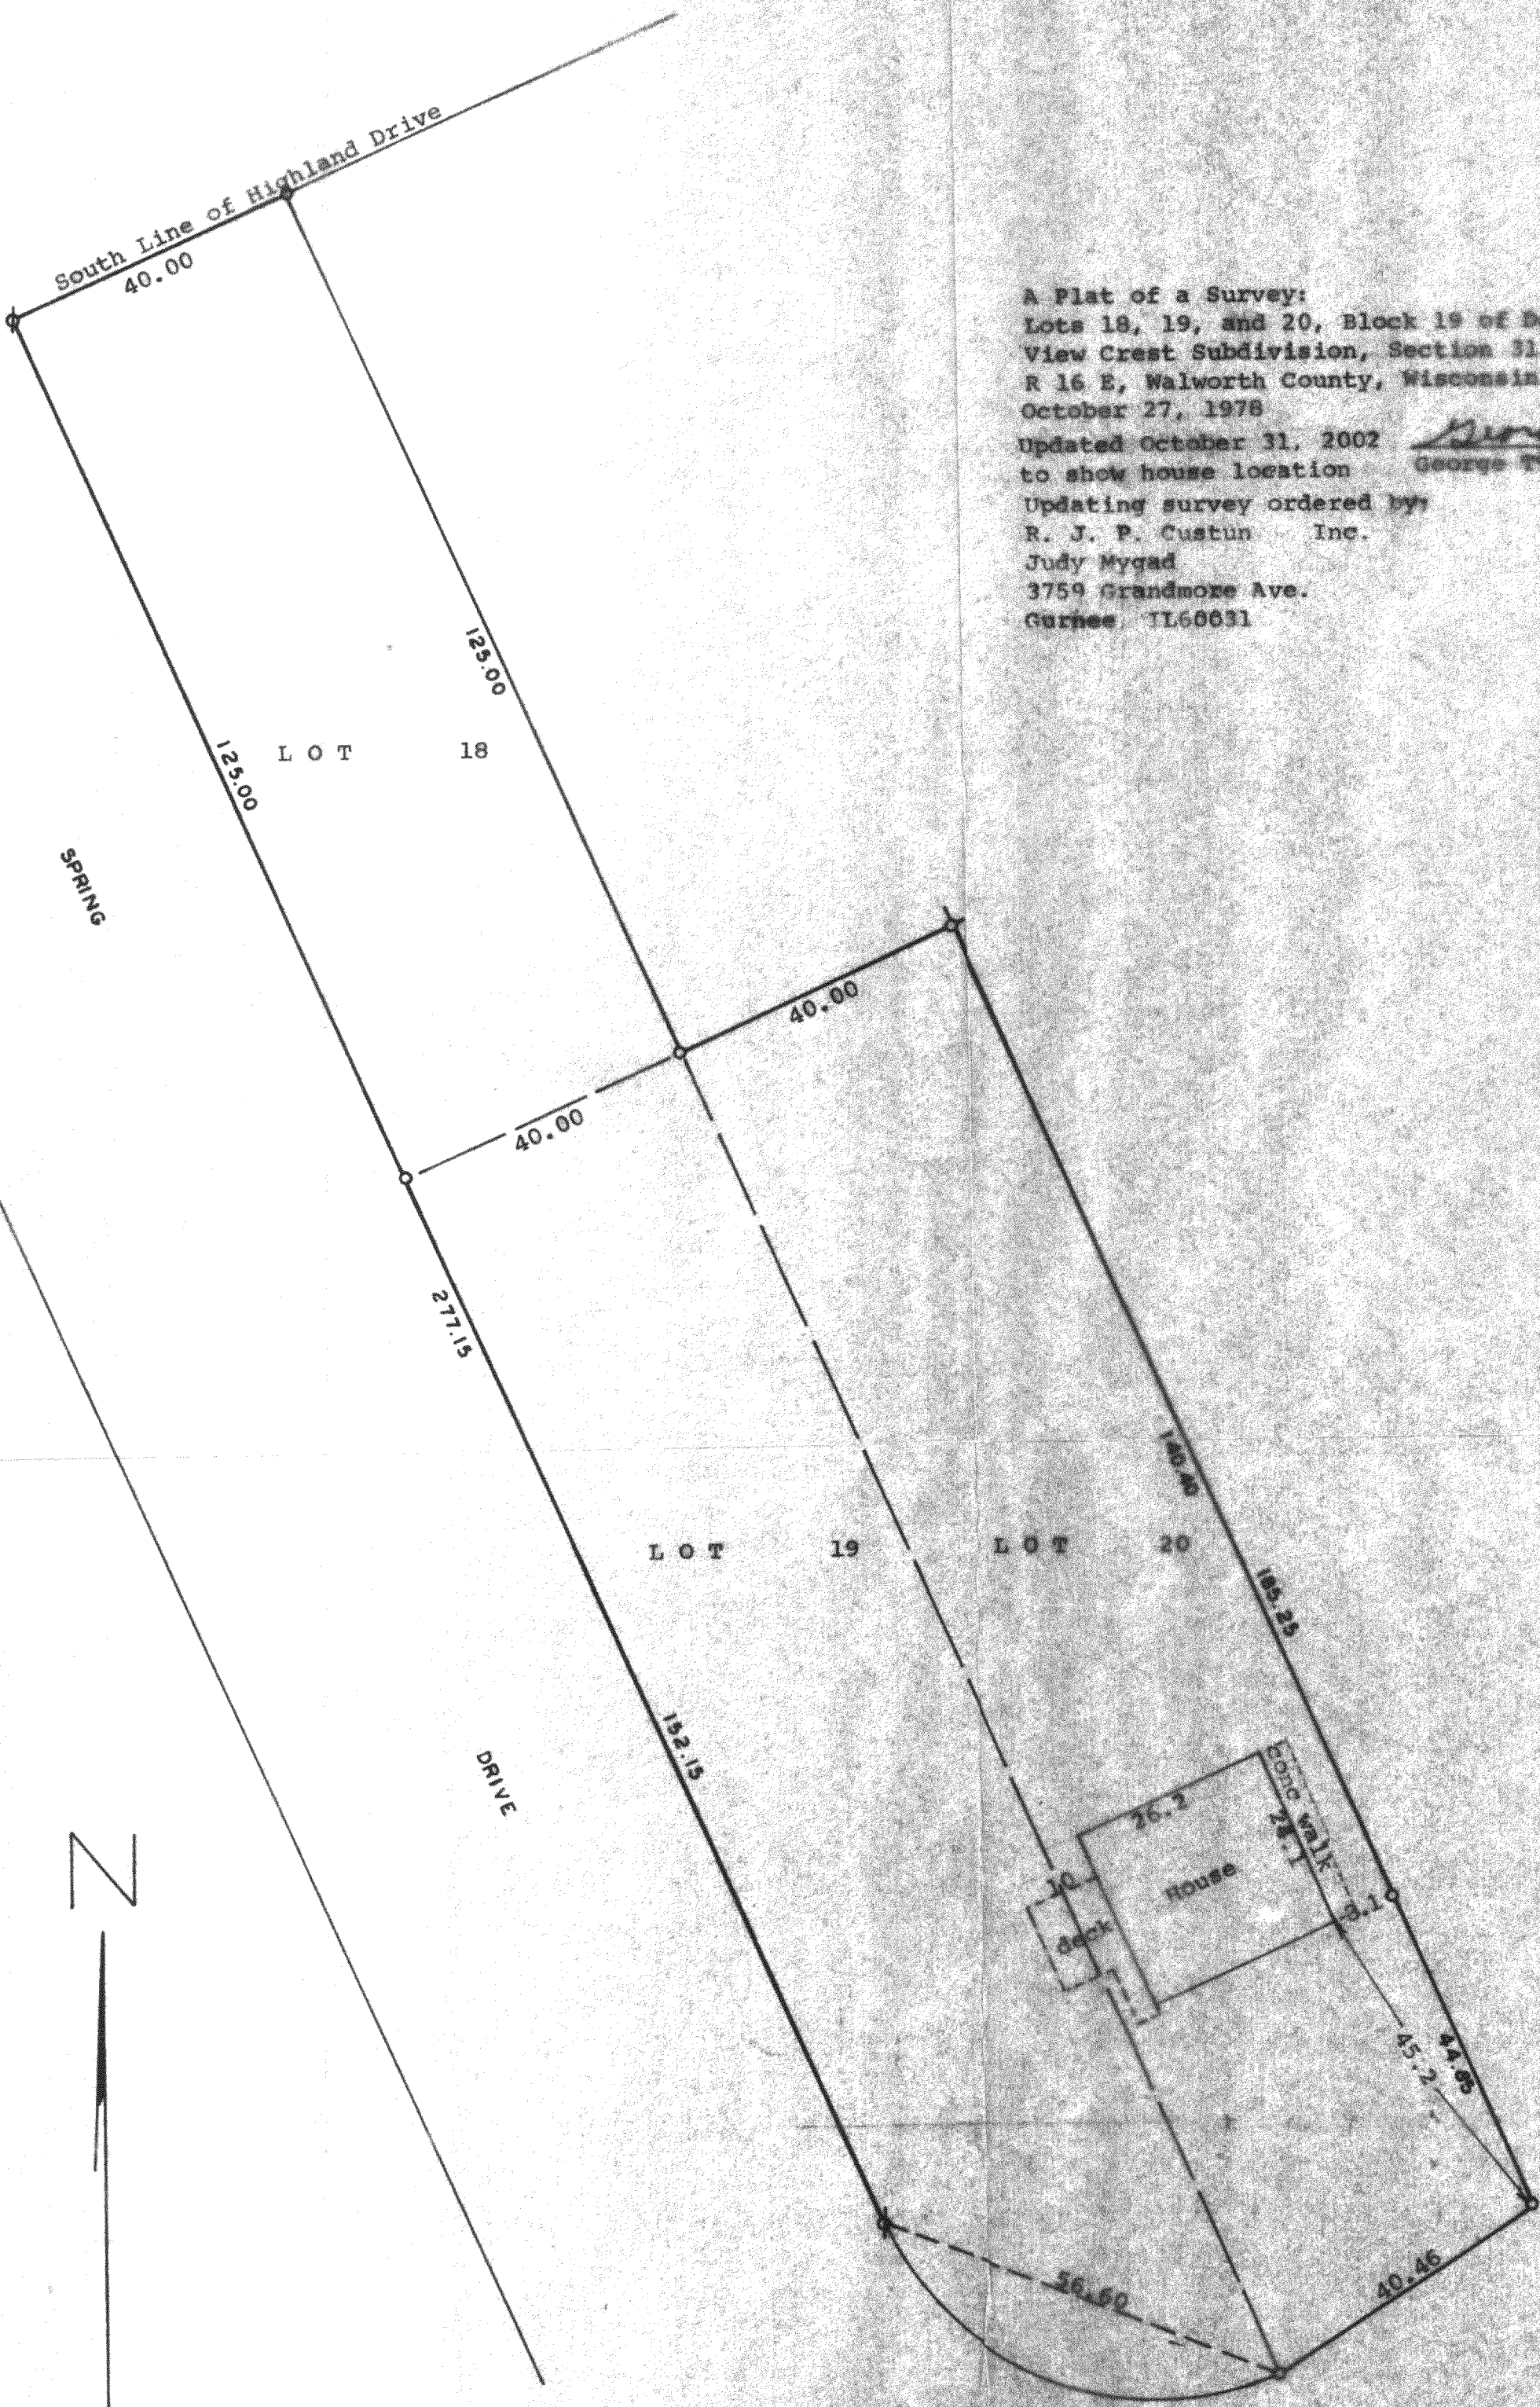

Scale - 1" = 20'
o = Iron Pipe Set
φ = Iron Pipe Found

