



DUNHAM SURVEYING, S.C.
SURVEYING & SUBDIVIDING
DELAVER, WISCONSIN 53115

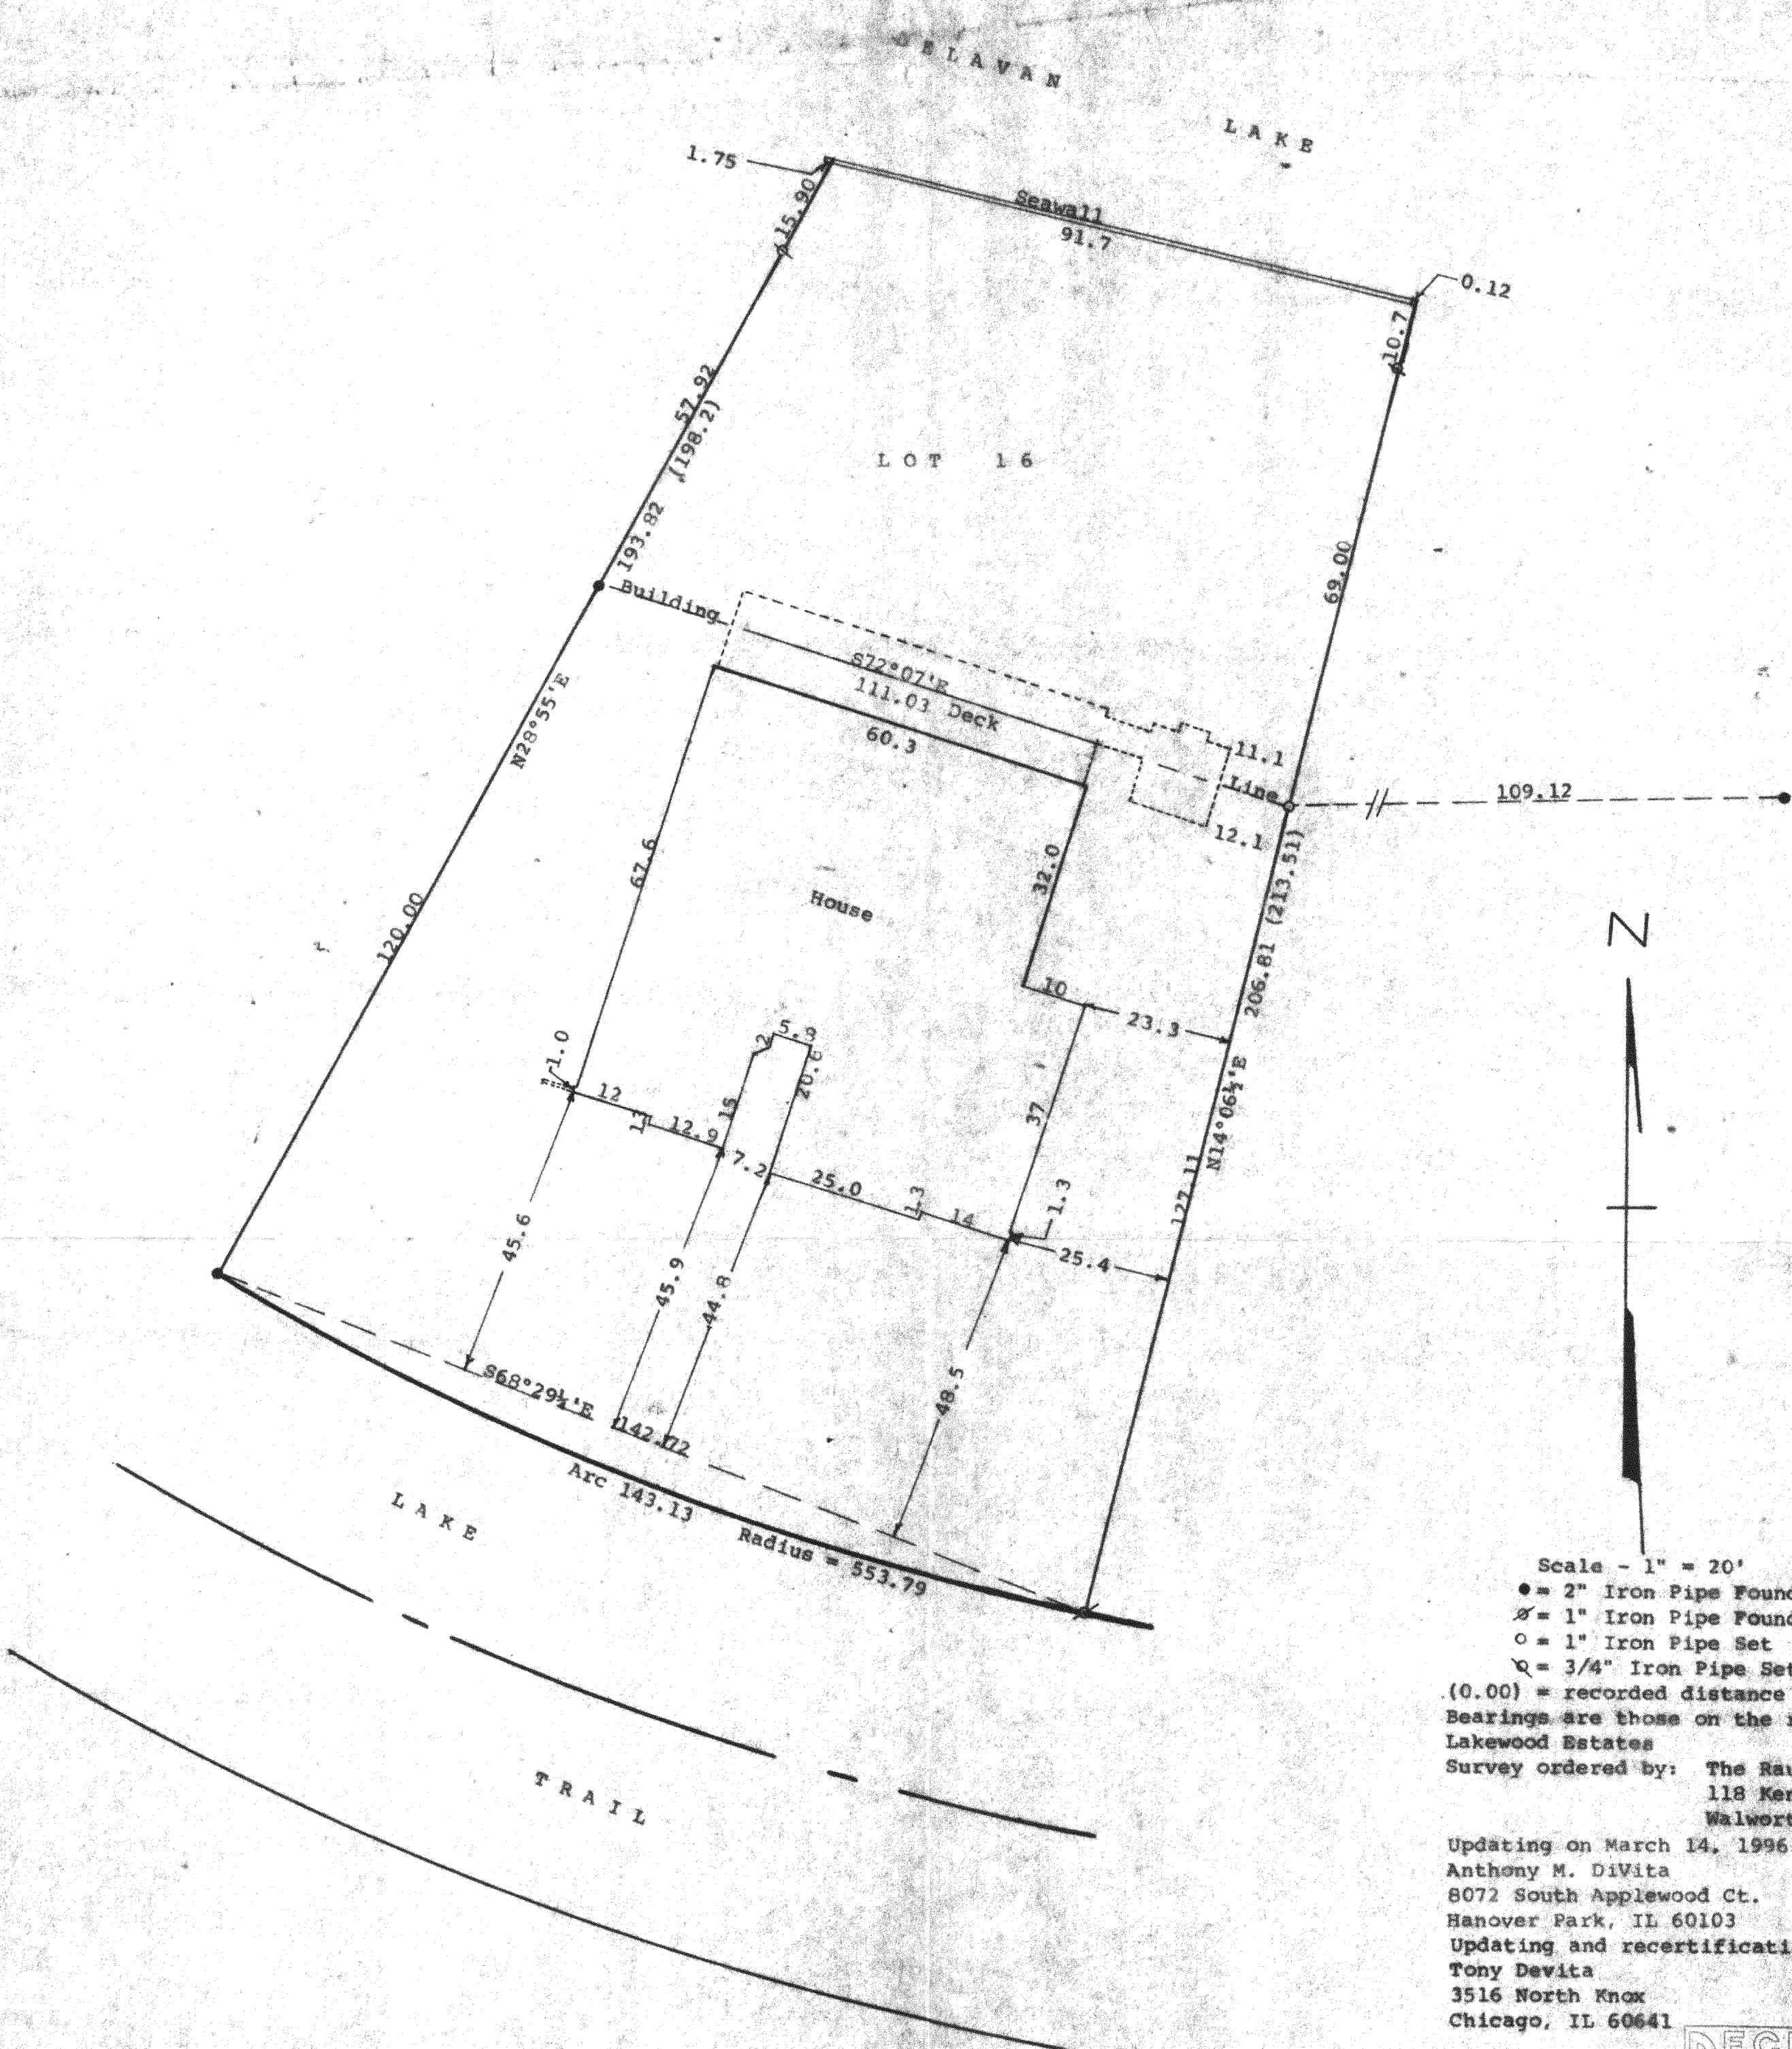

Scale - 1" = 20'
 ● = 2" Iron Pipe Found
 ✕ = 1" Iron Pipe Found
 ○ = 1" Iron Pipe Set
 ⊕ = 3/4" Iron Pipe Set
 (0.00) = recorded distance
 Bearings are those on the recorded plat of
 Lakewood Estates
 Survey ordered by: The Rauland Agency
 118 Kenosha Street
 Walworth, WI 53184
 Updating on March 14, 1996 ordered by:
 Anthony M. DiVita
 8072 South Applewood Ct.
 Hanover Park, IL 60103
 Updating and recertification ordered by:
 Tony Devita
 3516 North Knox
 Chicago, IL 60641

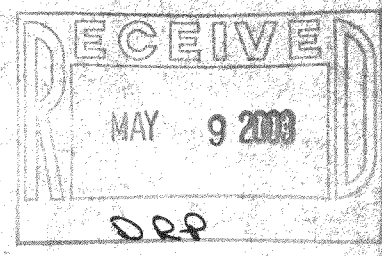

STATE OF WISCONSIN) SS
 COUNTY OF WALWORTH)
 I, George T. Dunham, Surveyor, certify that I have surveyed the property
 described as follows:
 Lot 16 in Lakewood Estates, a subdivision located Section 21, T 2 N, R 16 E,
 Walworth County, Wisconsin
 and that the plat shown hereon is a correct representation thereof and shows the size
 and location of the property, its exterior boundaries, the location of all visible
 structures and dimensions of all principal buildings thereon, boundary fences, apparent
 easements, roadways and visible encroachments, if any, and that I have surveyed the property
 hereon described, according to the official records, to the best of my knowledge and belief.
 June 14, 1995
 Updated March 14, 1996 to show proposed size
 and location of proposed house
 Revised April 10, 1996 for change in size and
 location of house
 Updated and recertified to be correct this
 12th day of May, 1997

George T. Dunham
 George T. Dunham, Surveyor

