


GEORGE T. DUNHAM
SURVEYING & SUBDIVIDING
DELAVAN, WISCONSIN

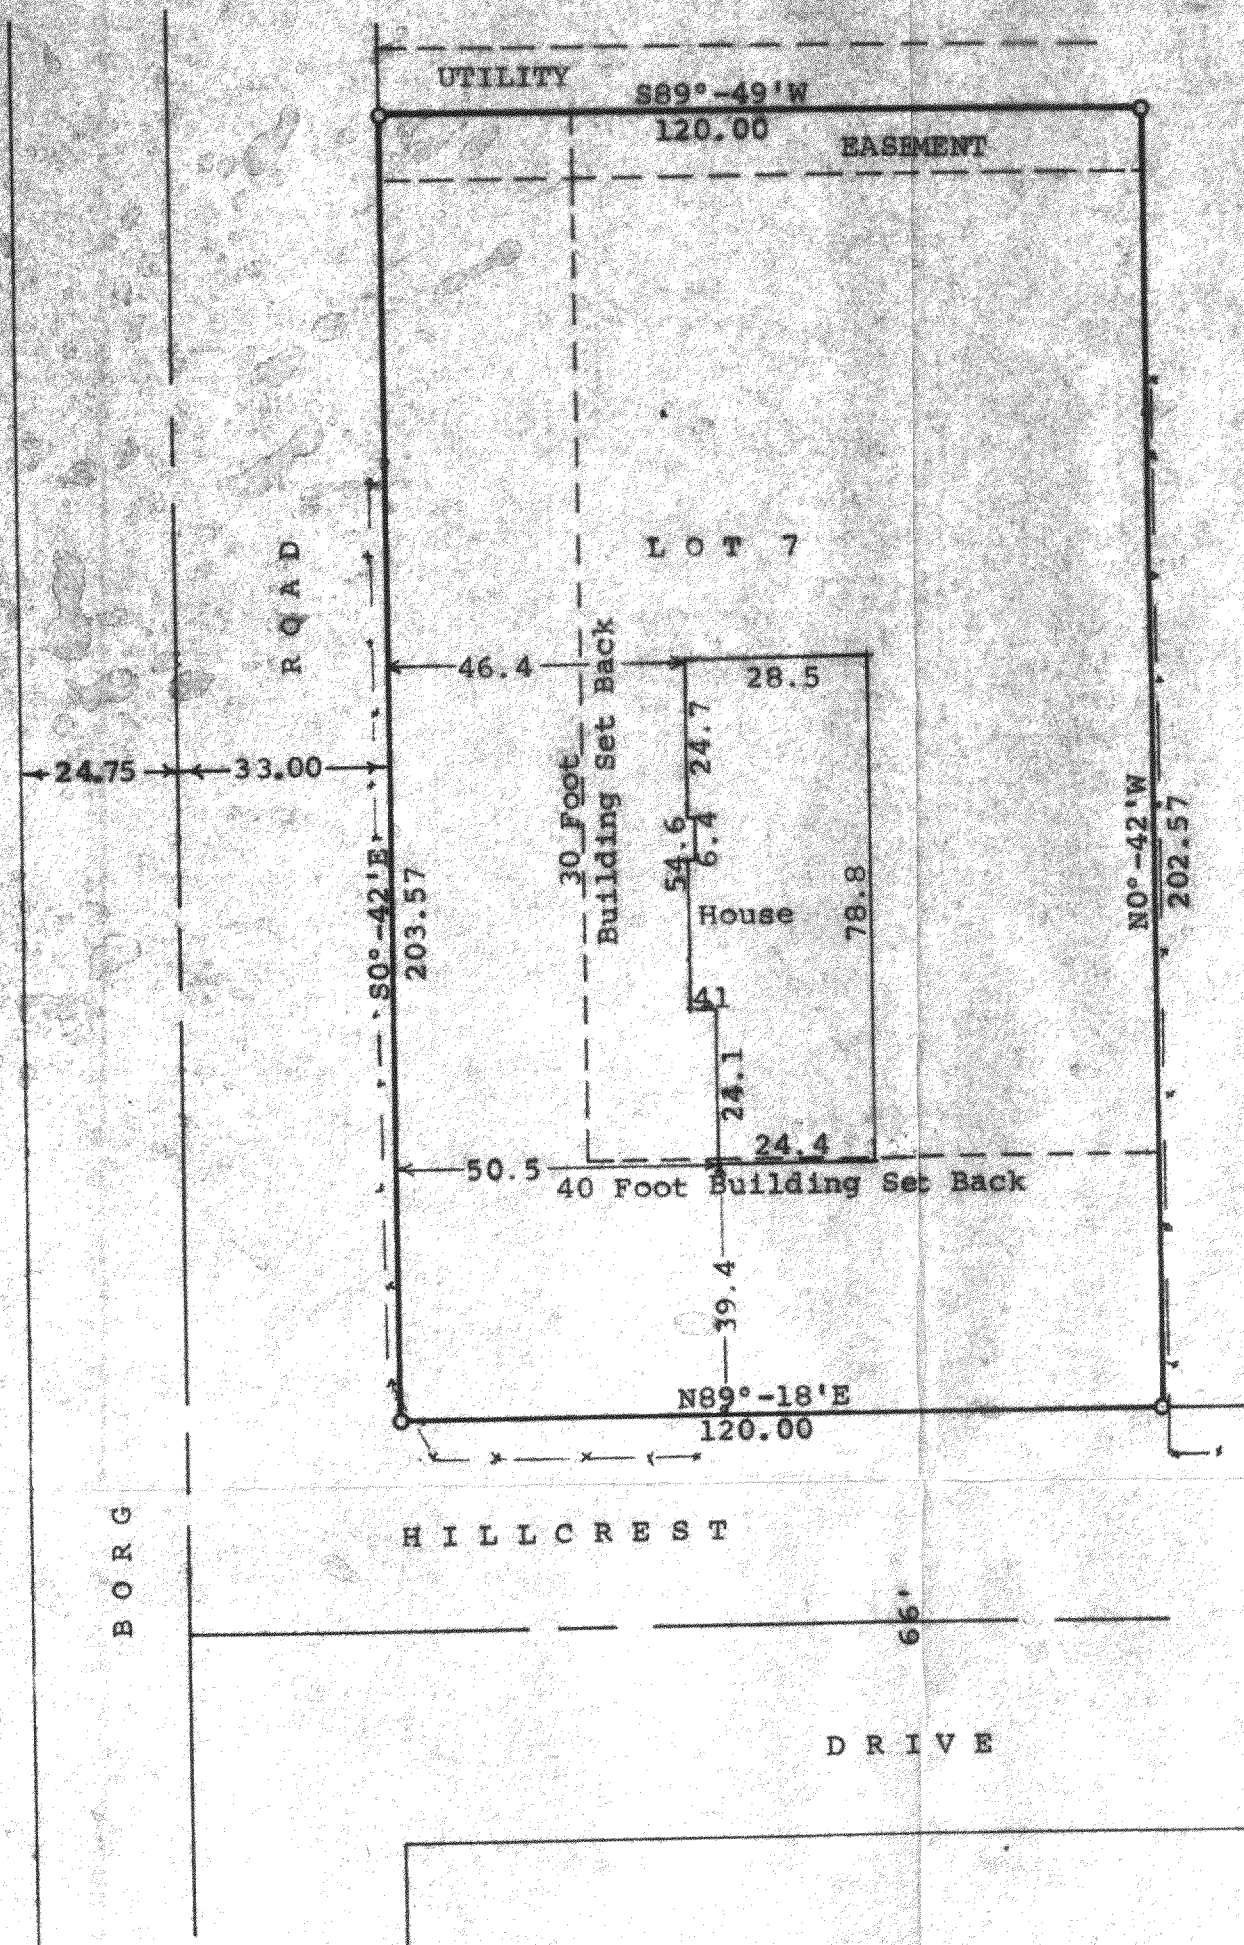

Scale - 1" = 30'

o = Iron Rods Found

--- = Fence Line

Updating and recertification ordered by:
Keefe Real Estate
1155 East Geneva Street
Delavan, WI 53115

STATE OF WISCONSIN)
COUNTY OF WALWORTH) SS

I, George T. Dunham, Surveyor, certify that I have surveyed the property described as follows,

Lot 7 of Oak Meadow Subdivision, a subdivision located in the Northeast 1/4 of Section 29, T 2 N, R 16 E, Walworth County, Wisconsin,

and that the above map is a true representation thereof and shows the size and location of the property, its exterior boundaries, and that there are no visible encroachments.

November 5, 1974

George T. Dunham
George T. Dunham, Surveyor

Updated and recertified to December 11, 2001, and the above map is a true representation thereof, showing size & location of the property, its exterior boundaries, the location of all visible structures and dimensions of all principal buildings thereon, boundary fences, apparent easements, and visible encroachments, if any, and that I have surveyed the property hereon described, according to the official records to the best of my knowledge and belief.

December 11, 2001

George T. Dunham
George T. Dunham, Surveyor

