


SURVEYING & SUBDIVIDING
DELAN, WISCONSIN 53115

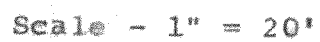

- = 1" Iron Pipe Found
- = 3/4" Iron Pipe Found
- = 1" bent iron pipe found 6" below surface, pulled and reset

Bearings referenced to the recorded bearing of
S82°W along the northerly line of Maple Drive
Survey ordered by: Johannesen-Farrar Real Estate, Inc.
110 South 3rd Street
Delavan, WI 53115

Updating and recertification ordered by:
David Schiltz
Attorney

803 West Main Street
Lake Geneva, WI 53147

November 29, 2000 updating and recertification
ordered by: Dave Conant

4106 Maple Drive
Delavan, WI 53115

● = Iron Rod Set 11/29/00
⊕ = Iron Pipe Set 11/29/00

STATE OF WISCONSIN)
COUNTY OF WALWORTH) ss

I, George T. Dunham, Surveyor, certify that I have surveyed the property described as follows:

Lots 77, 78, 79, and 80 in Krumhaar's 3rd Addition to Ravenswood, a subdivision located in Section 31, T 2 N, R 16 E, Walworth County, Wisconsin, EXCEPTING therefrom the East 10.00 feet of said lots and also excepting the Westerly 17.00 feet of said lots.

and that the map shown above is a true representation thereof and shows the size and location of the property, its exterior boundaries, the location of all visible structures and dimensions of all principal buildings thereon, boundary fences, apparent easements, roadways and visible encroachments, if any, and that I have surveyed the property hereon described according to the official records, to the best of my knowledge and belief.

November 8, 1983

Updated and recertified to this
20th day of October, 1995

Updated January 16, 1996

I, George T. Dunham, Surveyor, further certify that I have also surveyed the property described as follows:

the Westerly 17.00 feet of Lots 77, 78, 79, and 80 in Brumhaar's 3rd Addition to Ravenswood, a subdivision located in Section 31, T 2 N, R 16 E, Walworth County, Wisconsin.

Updated and recertified to this
29th day of November, 2000

George T. Dunham
George T. Dunham, Surveyor

George T. Dunham
George T. Dunham, Surveyor

