


DUNHAM SURVEYING, S.C.
SURVEYING & SUBDIVIDING
DELAVER, WISCONSIN 53115

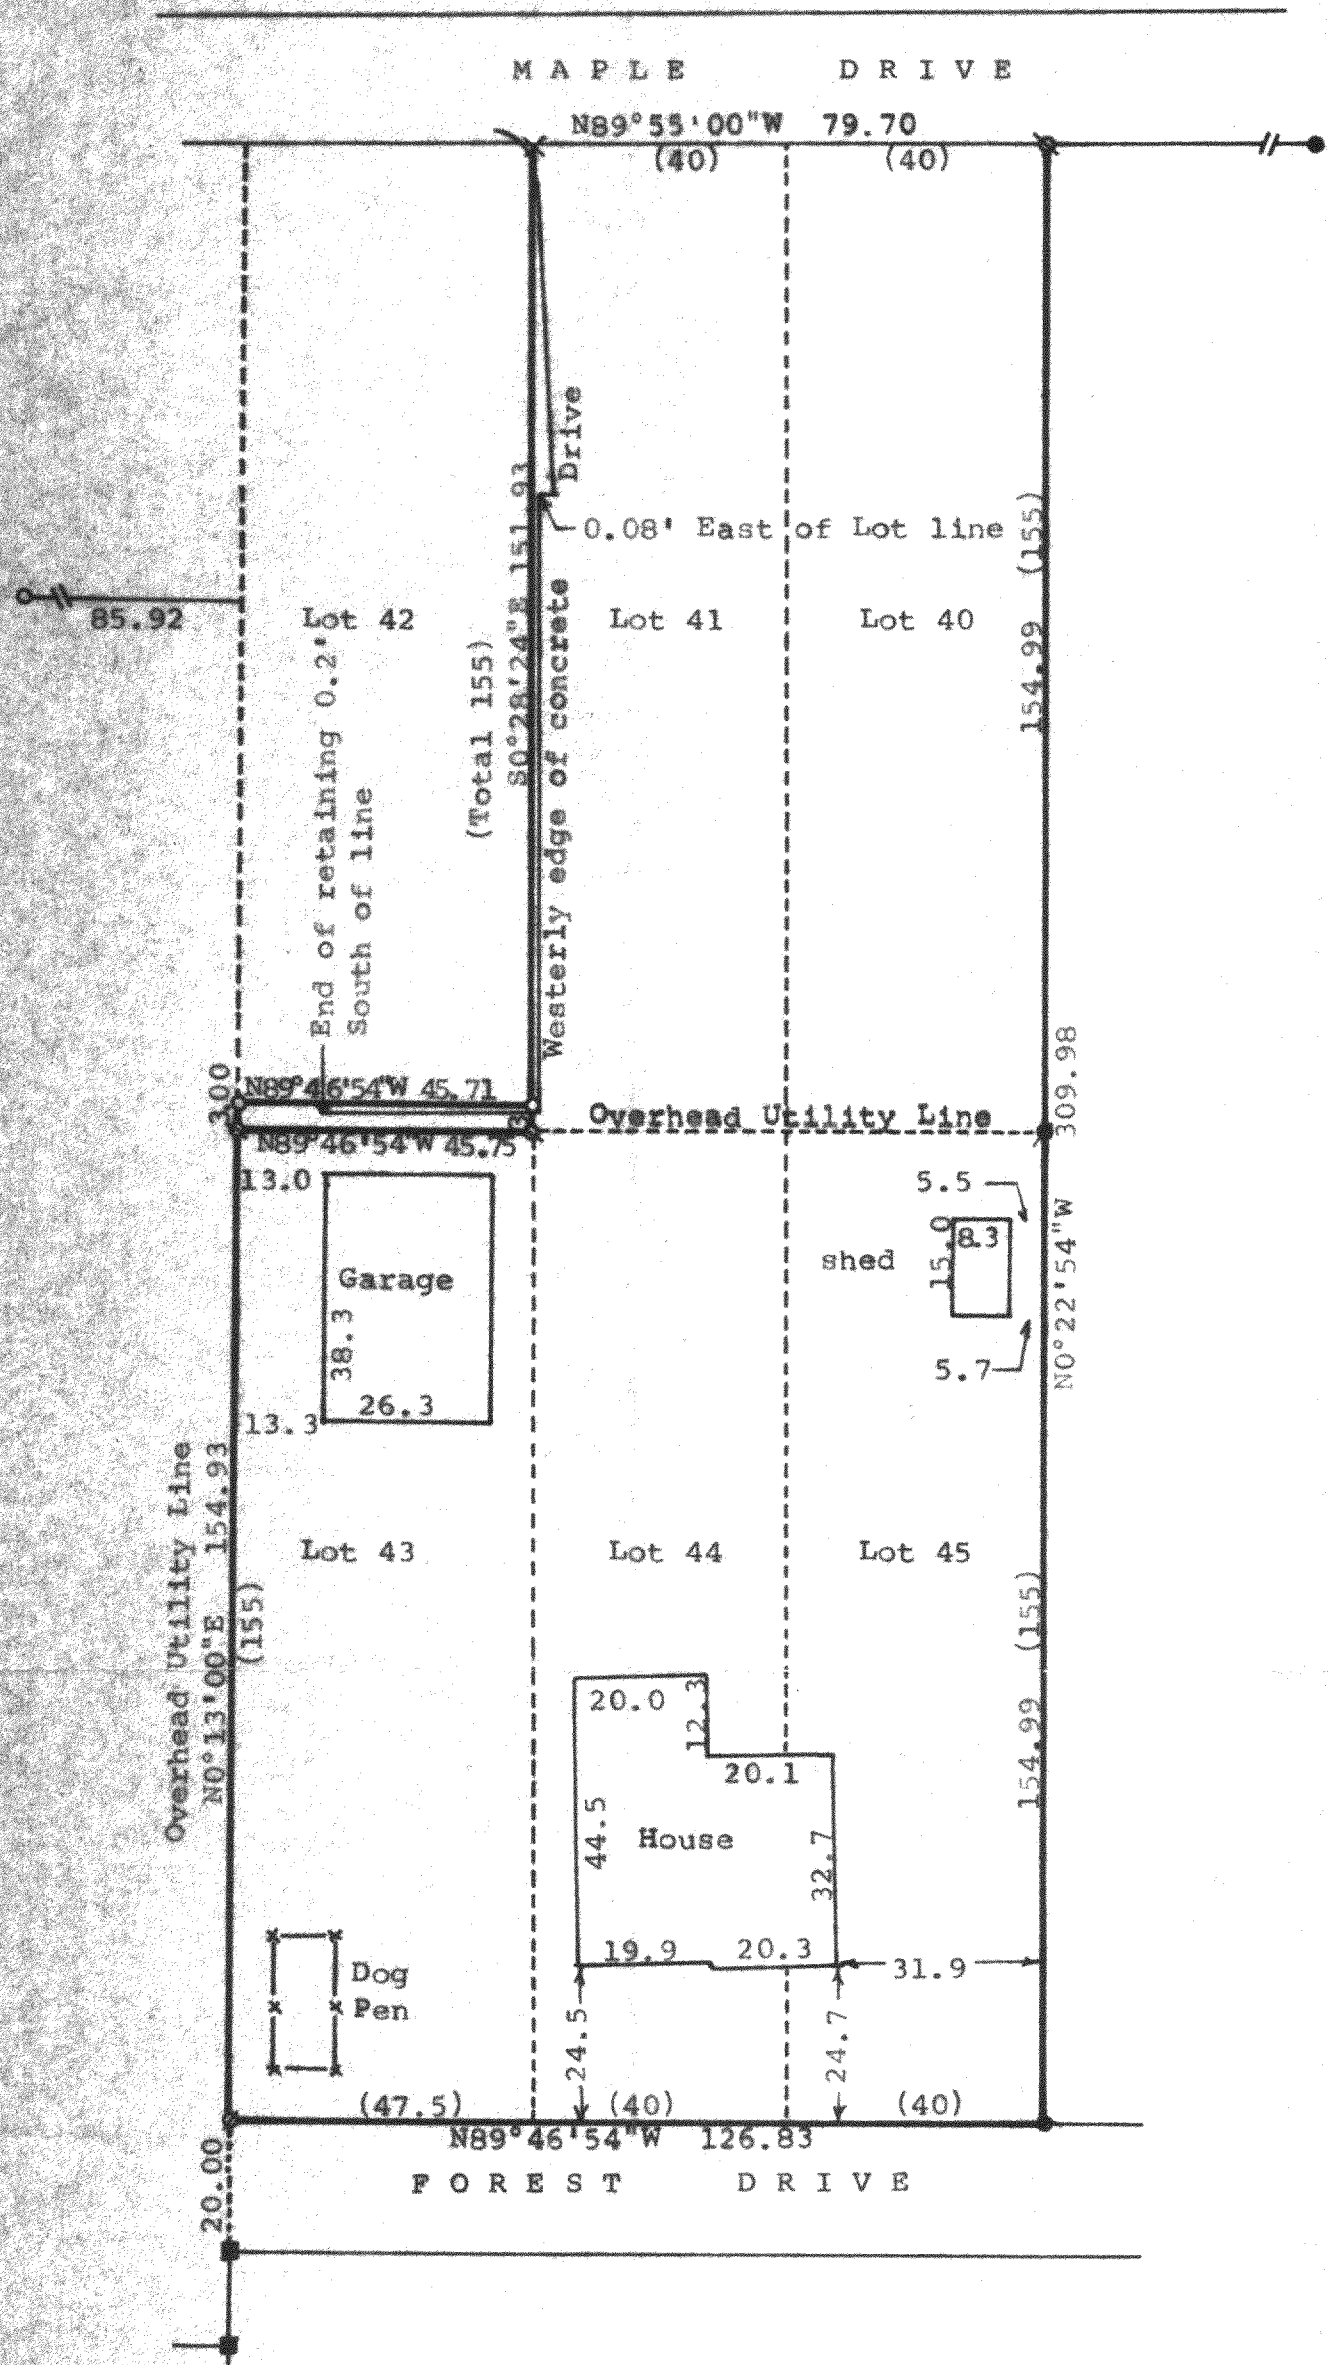

Scale - 1" = 30'

x = Cross in Concrete
● = 1/2" Iron Rod Found
= 1" Iron Pipe Found
■ = Concrete Monument Found
⊗ = 3/4" Iron Pipe Found
○ = 3/4" X 24" Iron Pipe Set
(0.00) = recorded distance

Survey ordered by: Century 21, Skandia Realty
312 South 7th Street
Delavan, WI 53115

Bearings referenced to the westerly line of Lot 43
Bearing of N0°13'E taken from those of record

Updating and recertification ordered by:
The Rauland Agency
Walworth, WI 53184

STATE OF WISCONSIN) SS
COUNTY OF WALWORTH)

I, George T. Dunham, Surveyor, certify that I have surveyed the property described as follows:

Lots 40, 41, 43, 44, 45, and the South 3.00 feet of Lot 42 of Krumhaar's Addition to Ravenswood, a subdivision located in Section 31, T 2 N, R 16 E, Walworth County, Wisconsin, and that the map shown hereon is a correct representation thereof and shows the size and location of the property, its exterior boundaries, the location of all visible structures and dimensions of all principal buildings thereon, boundary fences, apparent easements, roadways and visible encroachments, if any, and that I have surveyed the property hereon described according to the official records, to the best of my knowledge and belief.

April 28, 1987

Updated and recertified to this
31st day of March, 2001

George T. Dunham
George T. Dunham, Surveyor

