


GEORGE T. DUNHAM
SURVEYING & SUBDIVIDING
DELAVER, WISCONSIN

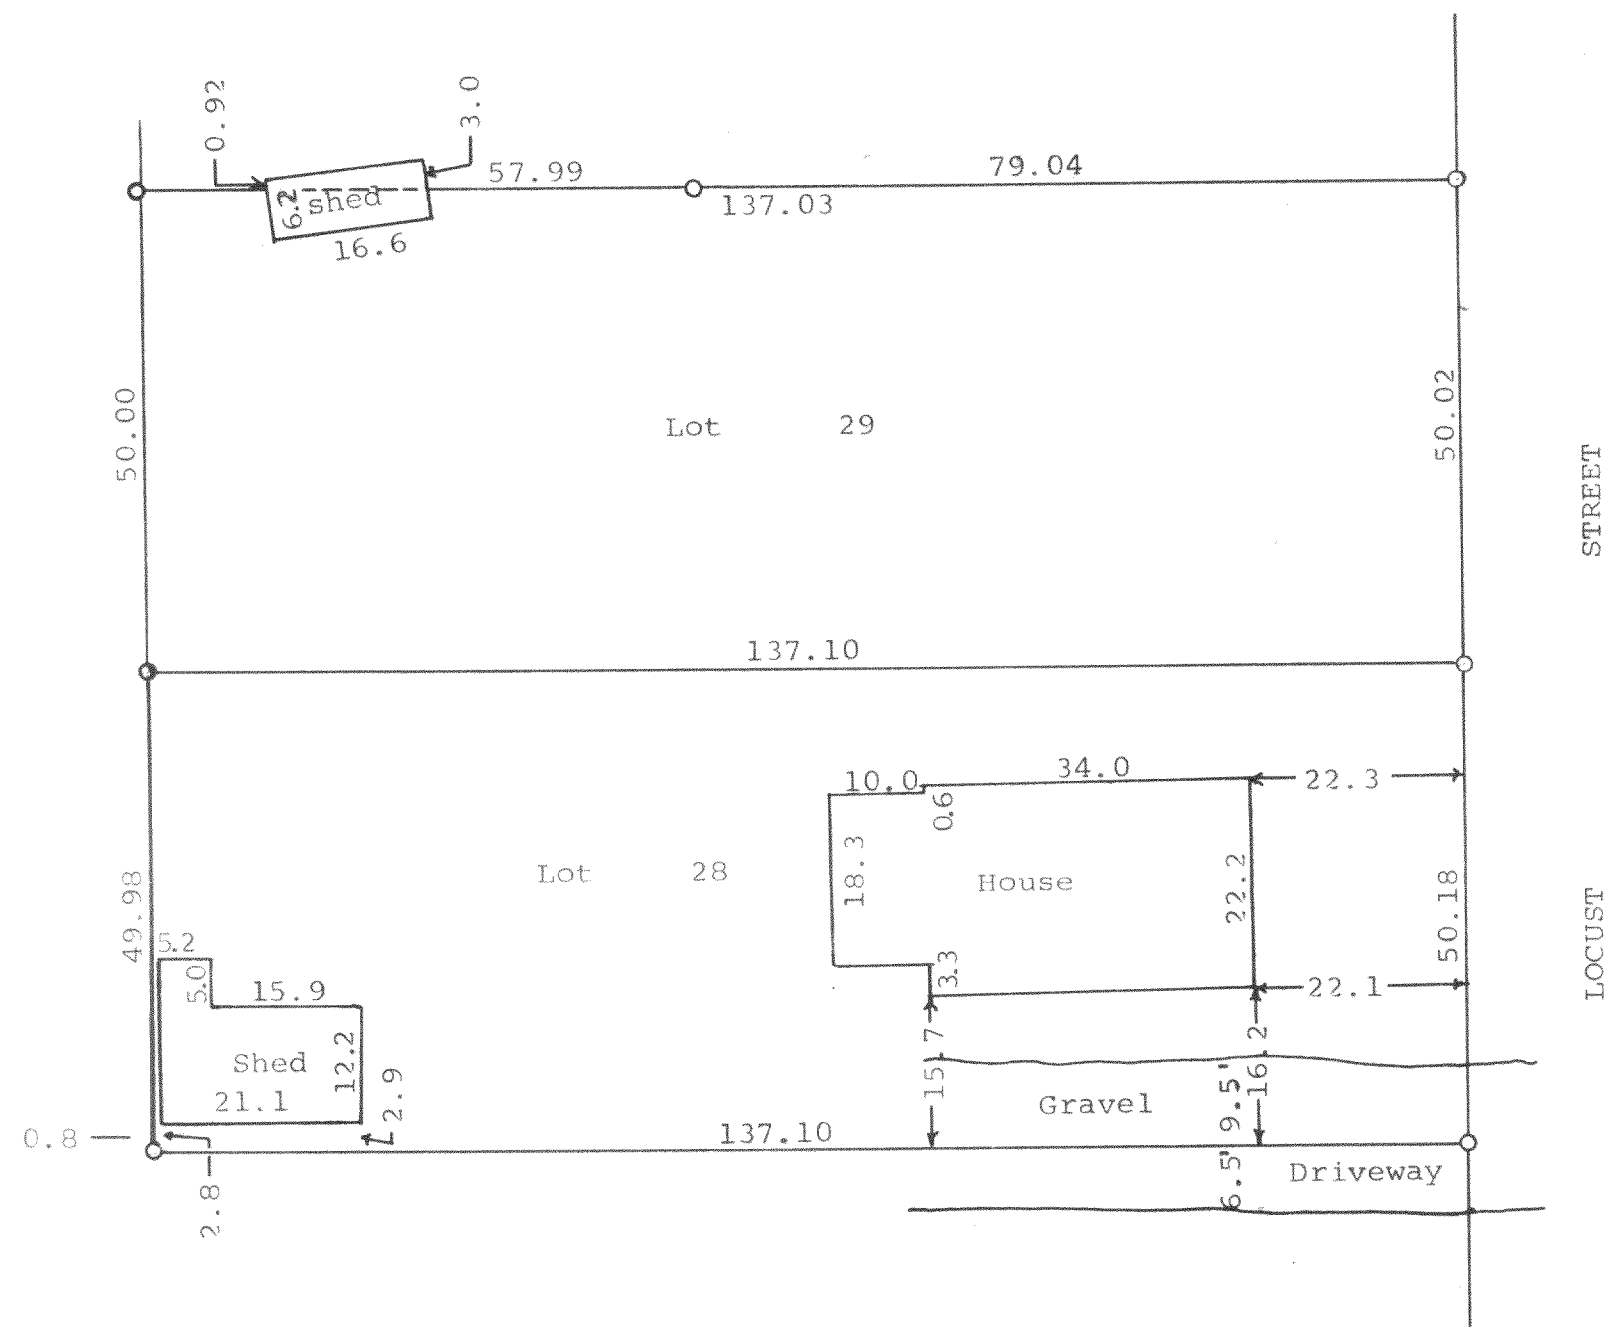

N

Scale - 1" = 20'
● = Iron Pipe

Plat of survey of Lots 28 and 29 in Lake View Subdivision,
in Section 32, T 2 N, R 16 E, Walworth County, Wisconsin,
as surveyed on October 9, 1969
January 17, 1970

George T. Dunham
George T. Dunham, Surveyor

216-350