


1140 SEQUOIA STREET • DELAVAN, WISCONSIN 53115
262-728-6737




LOT 13, BLOCK 10, DELMAR SUBDIVISION, LOCATED
IN T2N, R16E, WALWORTH COUNTY, WISCONSIN.

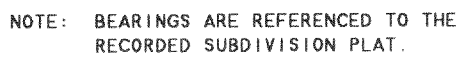

LEGEND

- Ø - IRON PIPE FOUND
 Δ - UTILITY POLE
 CS - CONCRETE STOOP
 () - RECORDED AS

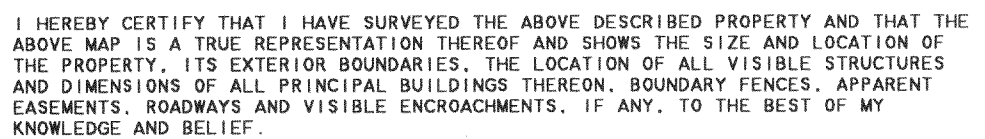

THIS SURVEY IS MADE FOR THE USE OF THE PRESENT OWNERS OF THE PROPERTY, AND ALSO THOSE WHO PURCHASE, MORTGAGE, OR GUARANTEE THE TITLE THERETO WITHIN ONE (1) YEAR FROM DATE HEREON.

ORDERED BY: THE RAULAND AGENCY
P.O. BOX 159
WALWORTH, WI. 53184

DAVID F. ABELL
WISCONSIN REGISTERED LAND SURVEYOR, S-1596

March 25, 2003

DATE _____ JOB NUMBER - 03034
NOTE: THIS IS NOT A CERTIFIED COPY UNLESS SEALED.

216-3540