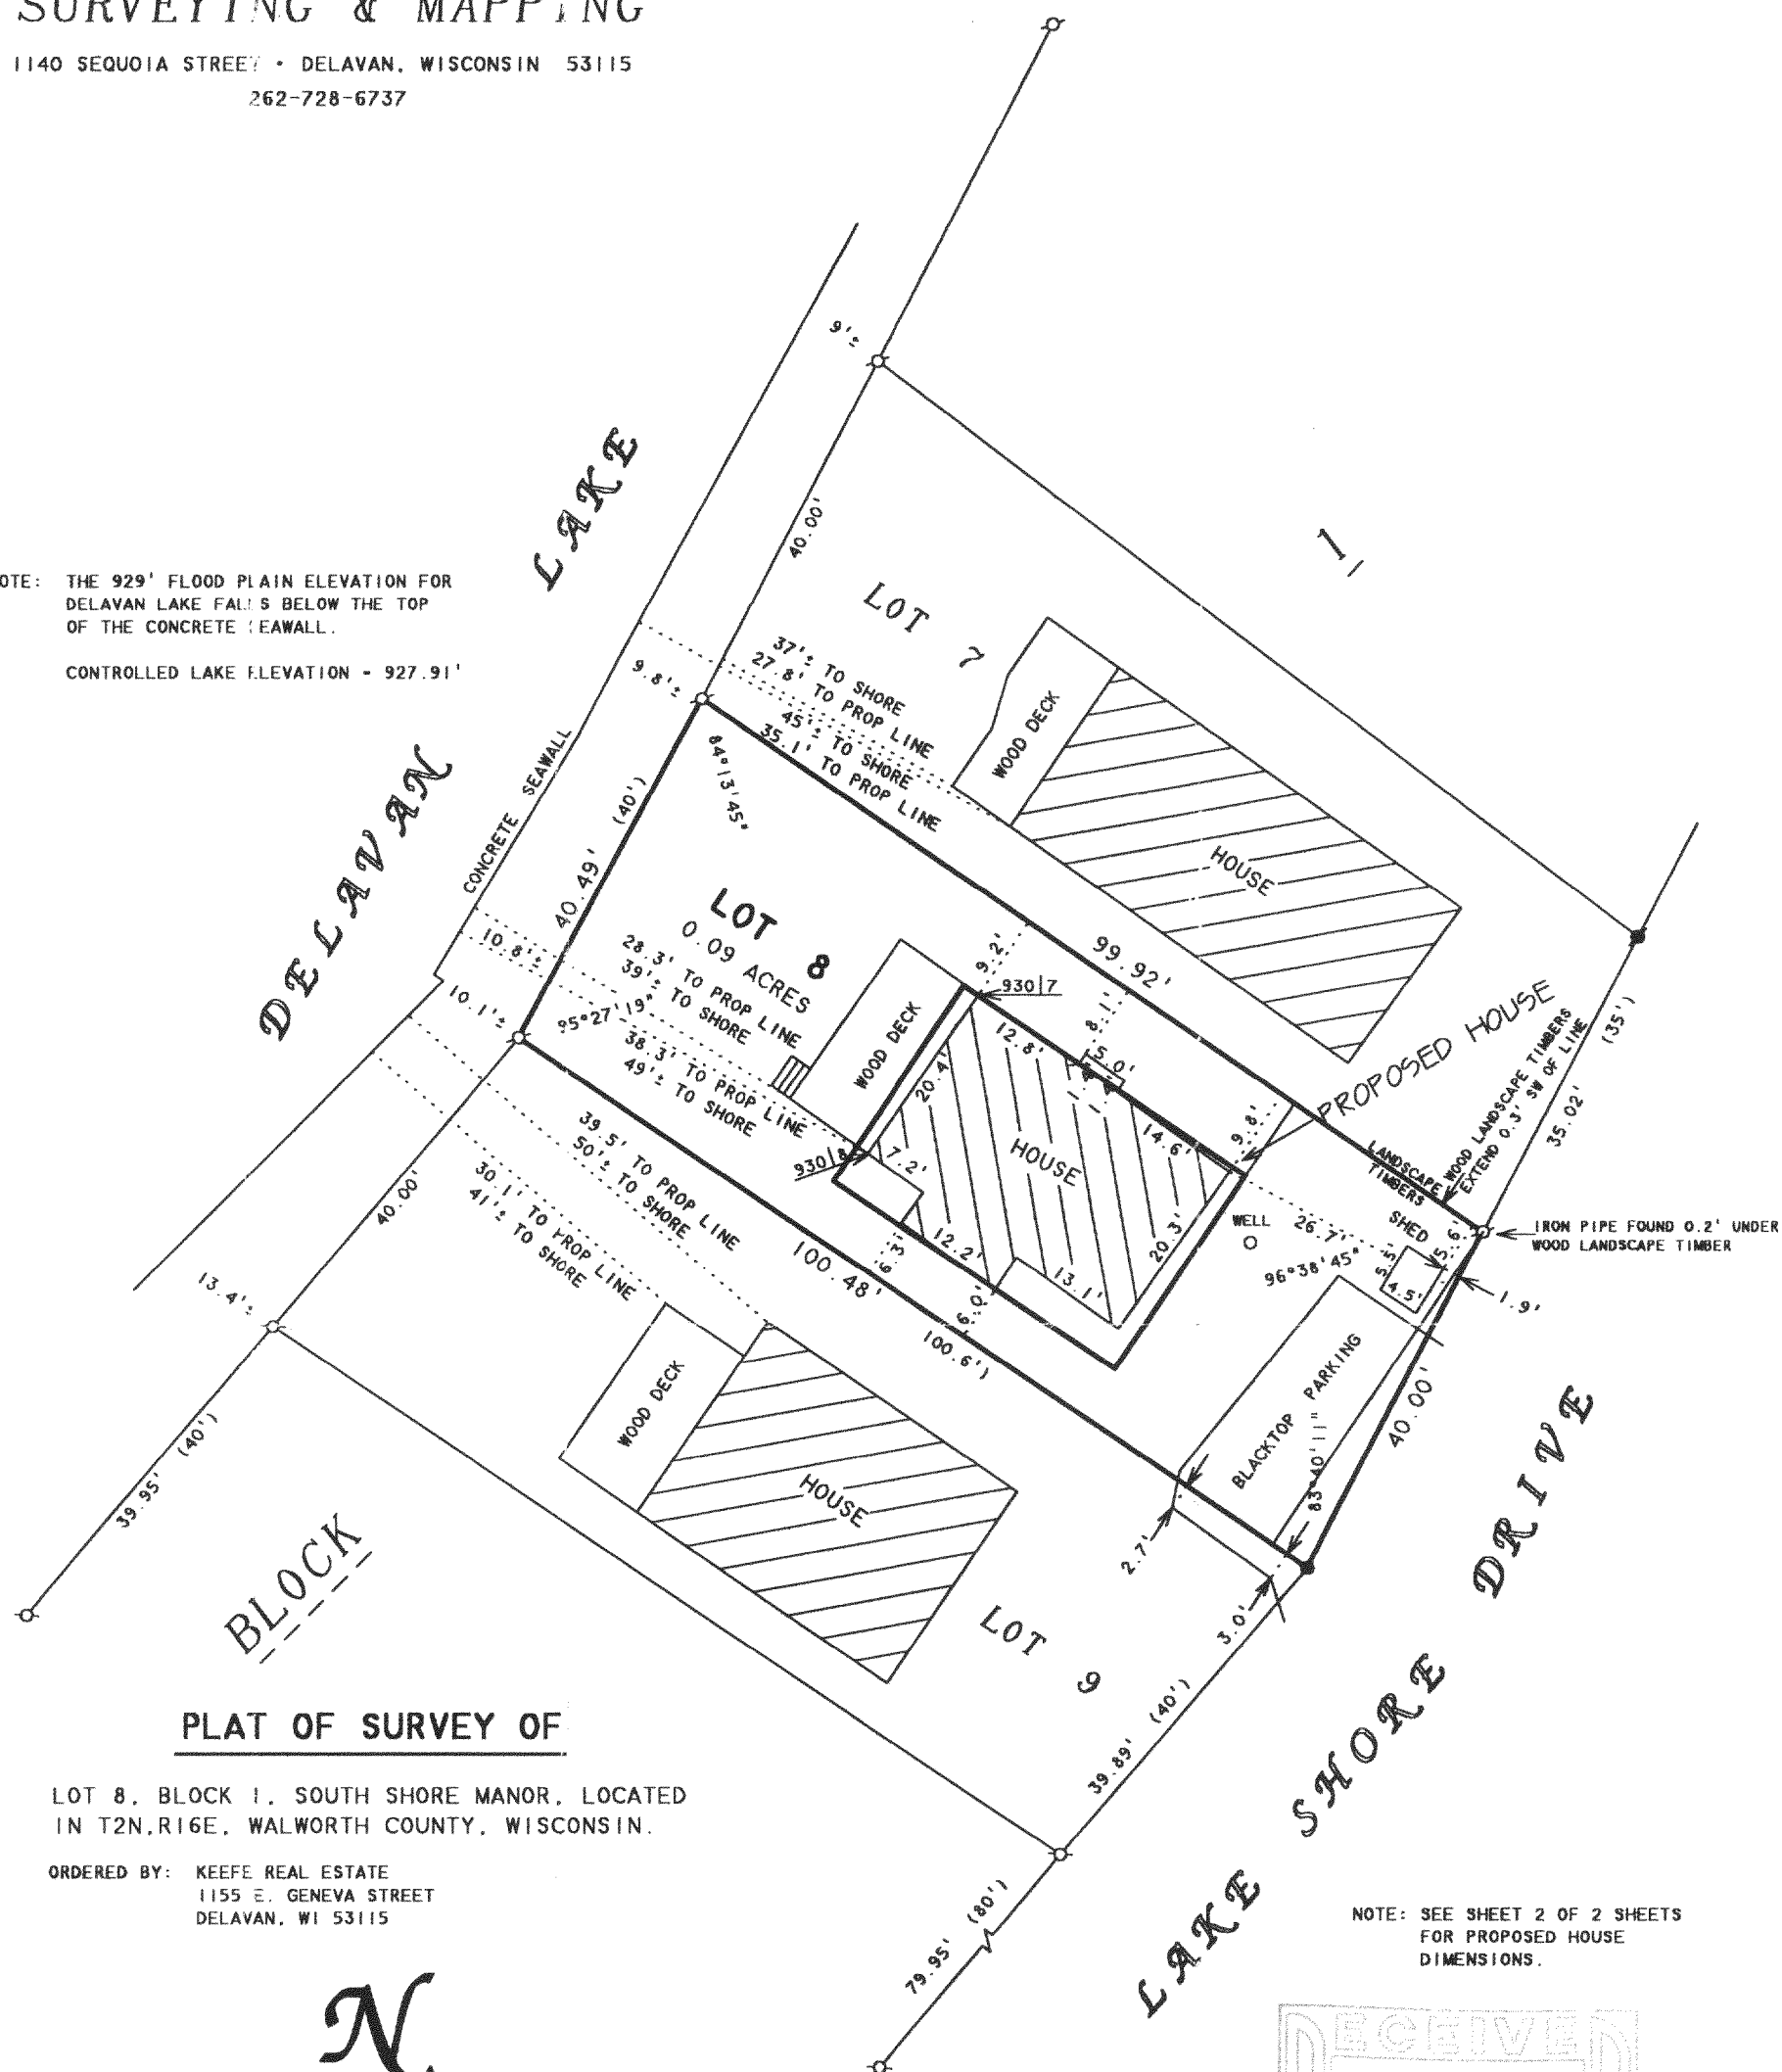


CONTROLLED LAKE ELEVATION - 927.91'

 $\mathcal{N}$

RECEIVED
JUL 11 2003
KW

DATE _____ JOB NUMBER - 03022B
NOTE: THIS IS NOT A CERTIFIED COPY UNLESS SEALED.


✓ FSS-7

216-3560

ABELL
SURVEYING & MAPPING

1140 SEQUOIA STREET • DELAVAN, WISCONSIN 53115
262-728-6737

SHEET 2 OF 2 SHEETS

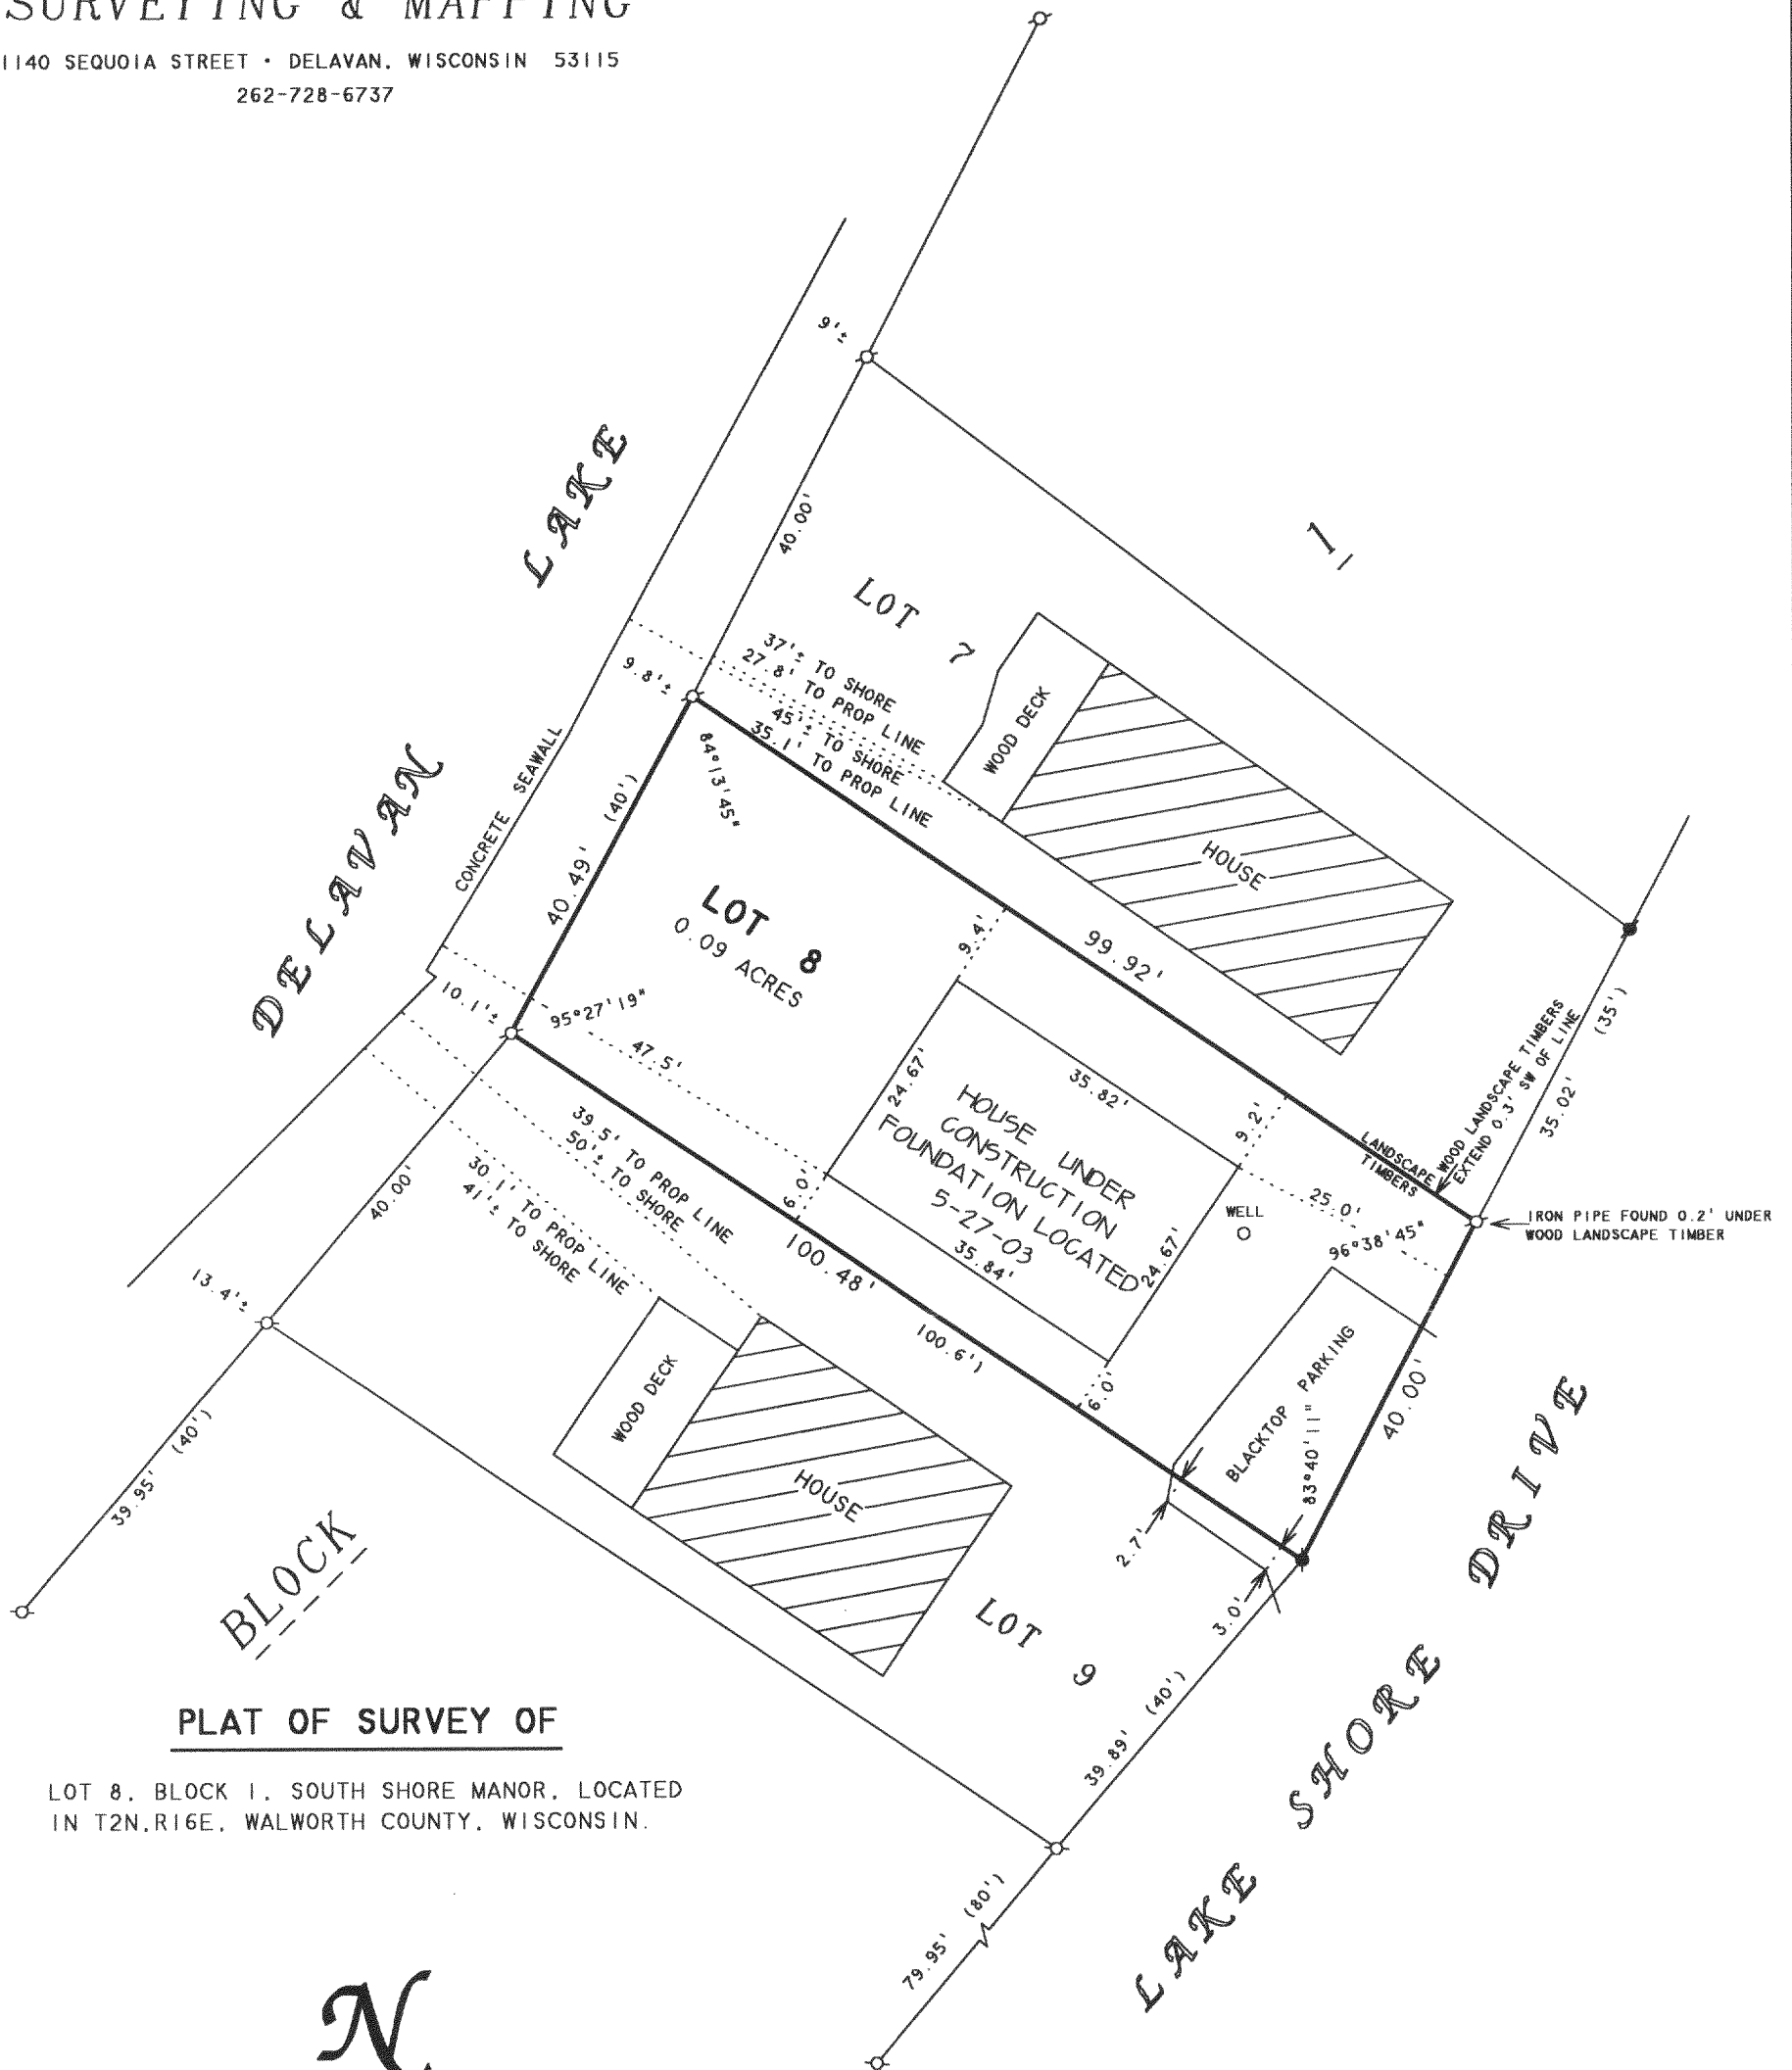

PLAT OF SURVEY OF

LOT 8, BLOCK 1, SOUTH SHORE MANOR, LOCATED
IN T2N.R16E, WALWORTH COUNTY, WISCONSIN.

N



SCALE 1"=20'

LEGEND

- - IRON PIPE FOUND
- - IRON ROD FOUND
- () - RECORDED AS

I HEREBY CERTIFY THAT I HAVE SURVEYED THE ABOVE DESCRIBED PROPERTY AND THAT THE ABOVE MAP IS A TRUE REPRESENTATION THEREOF AND SHOWS THE SIZE AND LOCATION OF THE PROPERTY, ITS EXTERIOR BOUNDARIES, THE LOCATION OF ALL VISIBLE STRUCTURES AND DIMENSIONS OF ALL PRINCIPAL BUILDINGS THEREON, BOUNDARY FENCES, APPARENT EASEMENTS, ROADWAYS AND VISIBLE ENCROACHMENTS, IF ANY, TO THE BEST OF MY KNOWLEDGE AND BELIEF.

THIS SURVEY IS MADE FOR THE USE OF THE PRESENT OWNERS OF THE PROPERTY, AND ALSO THOSE WHO PURCHASE, MORTGAGE, OR GUARANTEE THE TITLE THERETO WITHIN ONE (1) YEAR FROM DATE HEREON.

David F. Abell

DAVID F. ABELL
WISCONSIN REGISTERED LAND SURVEYOR, S-1596

ORDERED BY: MIKE MASCIOLA
API PLUMBING, INC.
3280 OAK KNOLL ROAD
CARPENTERSVILLE, IL 60110

May 27, 2003

DATE: May 27, 2003 JOB NUMBER - 03022C
NOTE: THIS IS NOT A CERTIFIED COPY UNLESS SEALED.