

ABERNATHY and ASSOCIATES


Kenneth B. Abernathy Jr.

Wisconsin Registered Land Surveyor S-1594

W4056 BRAY RD.
ELKHORN, WI. 53121
PHONE: (262) 723-4260 (OFFICE)
(262) 723-7209 (FAX)
Email: abernathy@elknet.net

PLAT OF SURVEY

LOT 4 OF MABIE WOOD, A SUBDIVISION LOCATED IN THE
SOUTHEAST 1/4 OF SECTION 21, TOWN 2 NORTH, RANGE 16 EAST,
DELAVER TOWNSHIP, WALWORTH COUNTY, WISCONSIN.

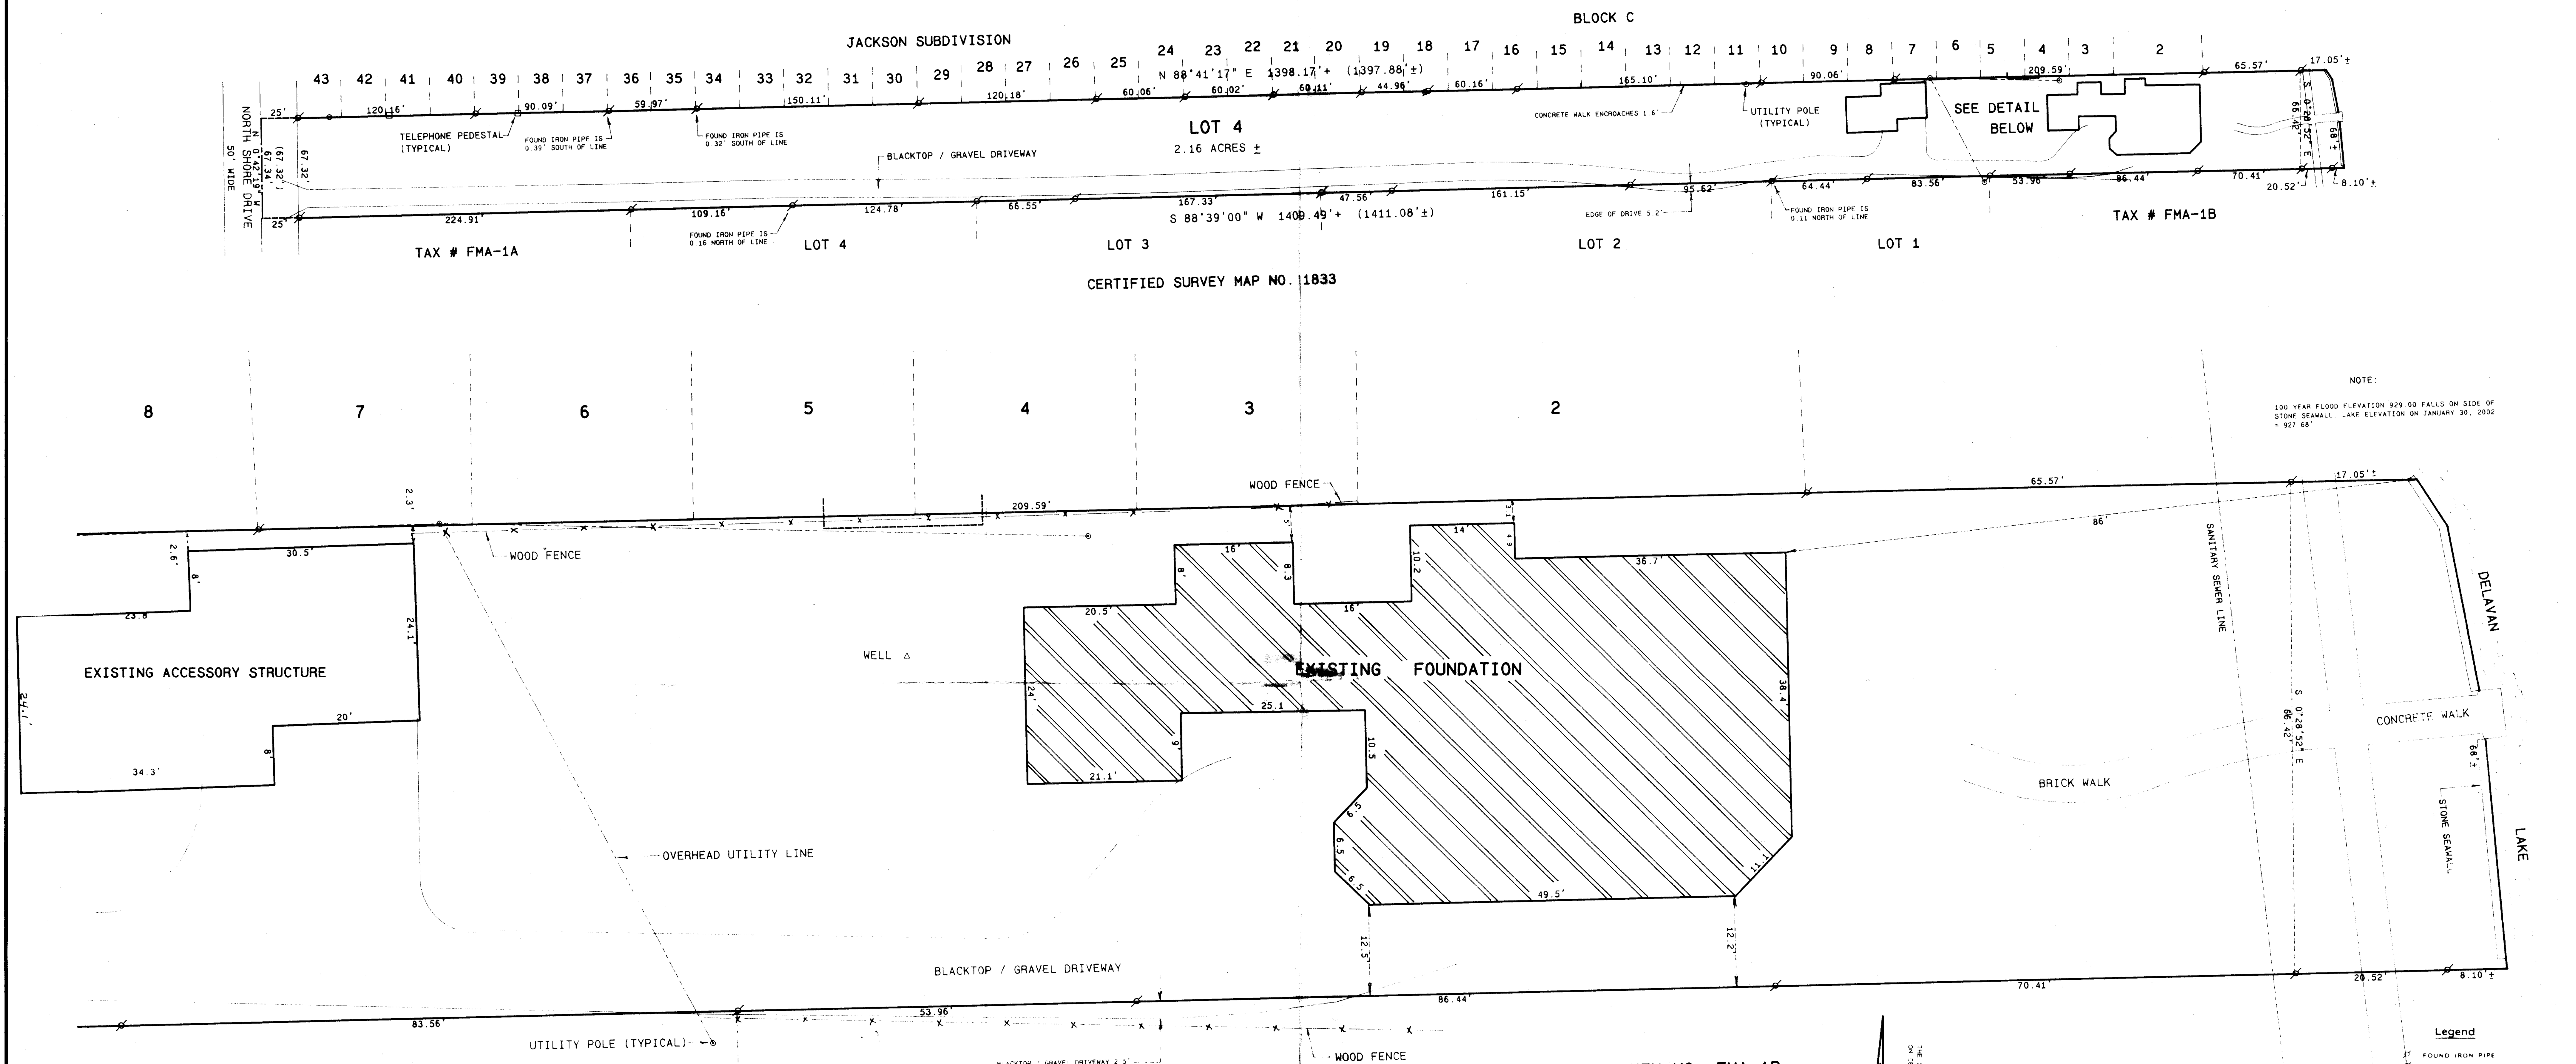

NOTE:
100 YEAR FLOOD ELEVATION 929.00 FALLS ON SIDE OF
STONE SEAWALL. LAKE ELEVATION ON JANUARY 30, 2002
= 927.68'


LOT 4, CERTIFIED SURVEY MAP NO. 1833

ORDERED BY: HOME DESIGN MANUFACTURING
N2002 HWY "67"
POST OFFICE BOX 527
FONTANA, WI 53125

OWNER: CHARLENE A. MEHLHAFF
P.O. BOX 22
DELAVER, WI 53115

TAX KEY NO. FMA-1B


- Legend
- FOUND IRON PIPE
 - FOUND IRON ROD
 - FOUND BRASS CAPPED MONUMENT
 - FOUND CONCRETE MONUMENT
 - CHISEL CUT IN CONCRETE
 - SET IRON ROD, 24" LONG, WEIGHING 1.5 LBS. LINEAL FT. 3/4" DIA.
 - SET IRON ROD, 36" LONG, WEIGHING 4.5 LBS. LINEAL FT. 1 1/4" DIA.
 - RECORDED AS DIMENSION
 - EXISTING FENCE

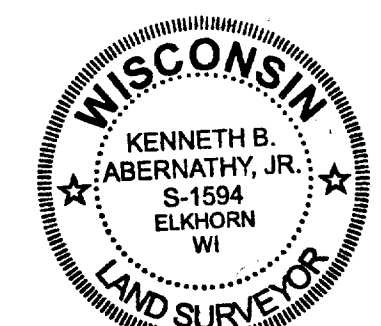

REVISED 7/10/02
REVISED NOV. 1, 2002 TO SHOW
THE ACCESSORY STRUCTURE "AS BUILT"

REVISED JUNE 25, 2003 TO
SHOW RESIDENCE FOUNDATION "AS BUILT"

SCALE: 1 INCH = 50 FEET
DETAIL: 1 INCH = 10 FEET

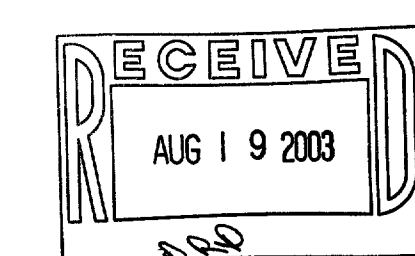

I hereby certify that the above described property has been surveyed
by me or under my direction and that the above map is a true
representation thereof and shows the size and location of the property
its exterior boundaries, the location of all visible structures and
dimensions of all principal buildings thereon, boundary fences, apparent
easements, roadways and visible encroachments, if any.
This survey is made for the use of the present owners of the property
and also those who purchase mortgage or guarantee title thereto
within one year from date hereof.

Kenneth B. Abernathy, Jr.
KENNETH B. ABERNATHY, JR.
WISCONSIN REGISTERED LAND SURVEYOR,
S-1594

Date: FEB. 8, 2002 Job No. 02-201

DESIGN PRODUCTS 151-2

FMA-2

216-3578