


PLAT OF SURVEY


-OF-

LOT 10 AND THE EAST 1/2 OF LOT 9, BLOCK 1, INLET OAKS SUBDIVISION NO. 4,
LOCATED IN SECTION 15, TOWNSHIP 2 NORTH, RANGE 16 EAST IN THE TOWN OF
DELAVAN, COUNTY OF WALWORTH AND STATE OF WISCONSIN.

SURVEY FOR: DONNA PEASE
SURVEY LOCATION: 509 DELAVAN DRIVE

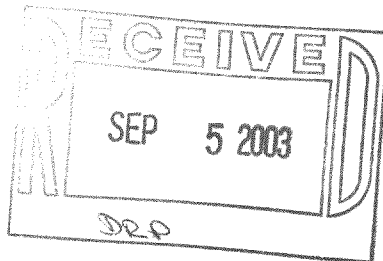


DELAVAN (40' WIDE) **DRIVE**

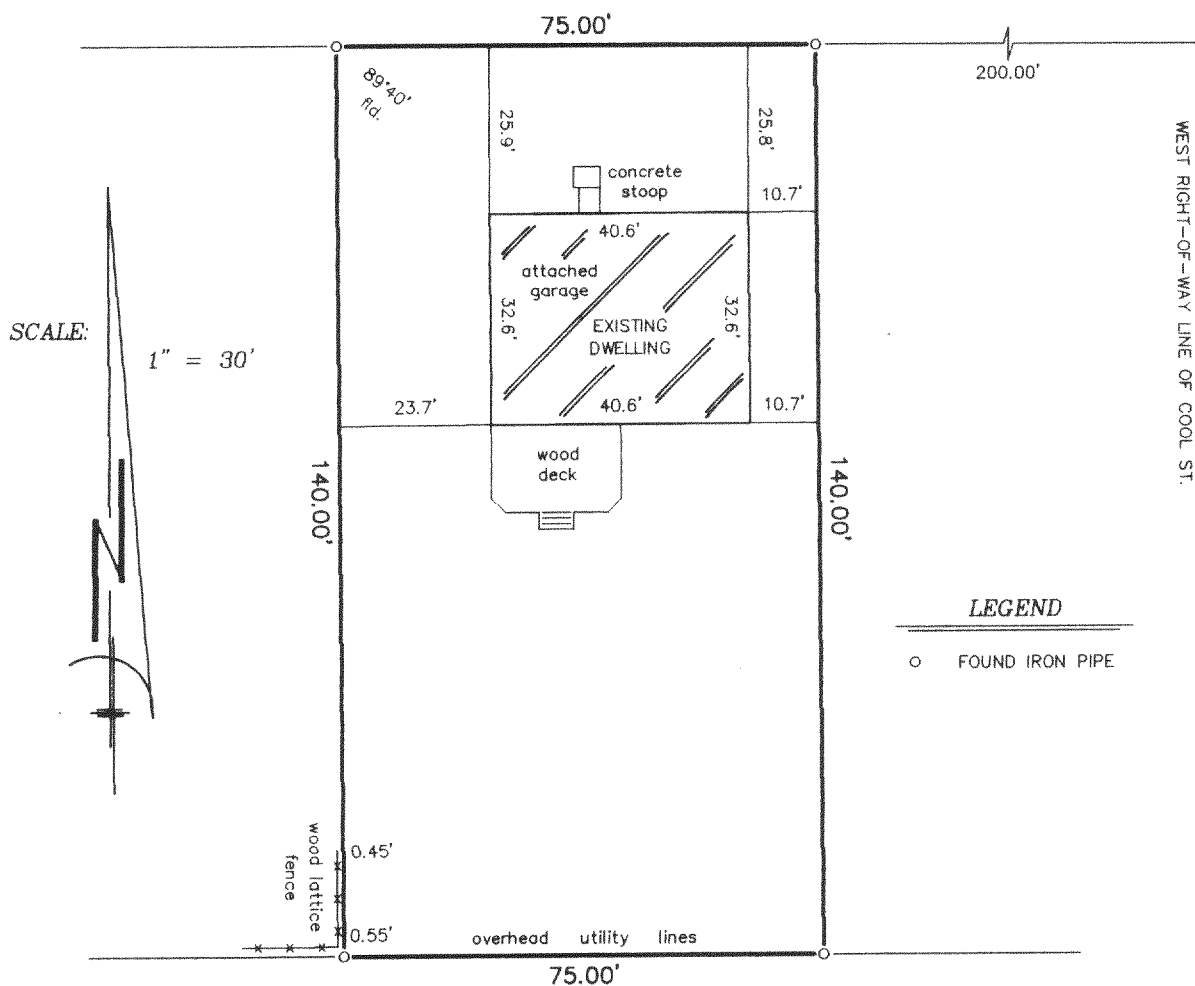

"I hereby certify that I have surveyed the above described property and that the above map is a correct representation thereof and shows the size and location of the property, its exterior boundaries, the location of all visible structures and dimensions of all principal buildings thereon, boundary fences, apparent easements, roadways and encroachments, if any."

"This survey is made for the use of the present owners of the property, and those who purchase, mortgage, or guarantee the title thereto within one year from date hereof."

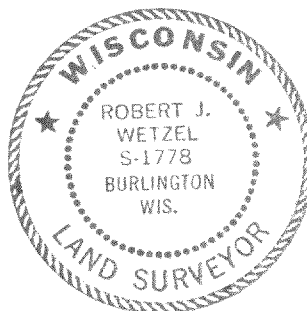

THIS IS NOT AN ORIGINAL PRINT
UNLESS THIS SEAL IS RED.



B.W. SURVEYING, INC.

412 N. PINE STREET
BURLINGTON, WI 53105
(262)-767-0225

Robert J. Wetzel
ROBERT J. WETZEL S-1778

JUNE 18, 2003
DATE

5919
JOB NUMBER

FIN4-3A1

216-3583