

REGISTERED PROFESSIONAL LAND SURVEYOR
LAKE GENLVA, WISCONSIN

PLAT OF SURVEY OF

Lots 14 & 15 of the Plat of Point Comfort, part of the PARKS of the Plat of Point Comfort, located in the Southeast 1/4 of Section 22, T 2 N, R 16 E, and part of the Northeast 1/4 of Section 27, T 2 N, R 16 E, Walworth County, Wisconsin.

State of Wisconsin } ss
County of Walworth }

I, Harold H. Kolb, do hereby certify that I have surveyed the property hereon described according to the official records, and that the plat hereon is a correct representation of the lot lines and the principal lines of the buildings thereon.

o - Iron Pipe Found
o - Iron Pipe Placed
-x- Fence

Scale 1"=20'

DELEVAN LAKE

128' Conc. Sea Wall

Stairs


Boat House

N5°17'E 127.96'

South line Section 22, T2N, R16E

North line Section 27, T2N, R16E

P A R K
(As shown on Plat of Point Comfort)

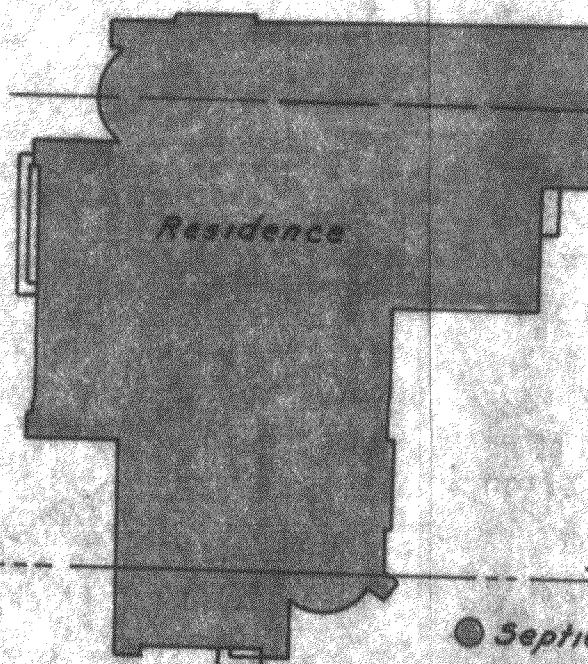

Residence

Lot 13

S89°56'E 317.88'

North line Lot 14

Lot 14

Lot 15

Septic Tank

Septic Tank

South line Lot 15

East 324.63'

62.36'

71.60'

Edges of Garage
Encroach 0.5'

Garage

Covered Pit

P A R K
(As shown on Plat of Point Comfort)

SOUTH SHORE DRIVE

N0°35'E 127.08'

FPC-11

January 1963

Harold H. Kolb

Harold H. Kolb, Wisconsin Surveyor, B-157

216-362