

FARRIS, HANSEN & ASSOCIATES, INC.


ENGINEERING — ARCHITECTURE — SURVEYING
7 RIDGWAY COURT — P.O. BOX 437 — ELKHORN, WISCONSIN 53121
PHONE: (262) 723-2098 FAX: (262) 723-5886

PLAT OF SURVEY

LOT 1 OF C.S.M. 1395, REC. IN VOL. 6,
PG. 259, AS DOC. NO. 108935
LOCATED IN SECTION 29, TOWN 2 NORTH,
RANGE 16 EAST, WALWORTH COUNTY, WISCONSIN

NORTH SHORE DRIVE

— WORK ORDERED BY —
PAM KURTZ — JK CONSTRUCTION
9117 DUSK DRIVE
ELKHORN, WI 53121

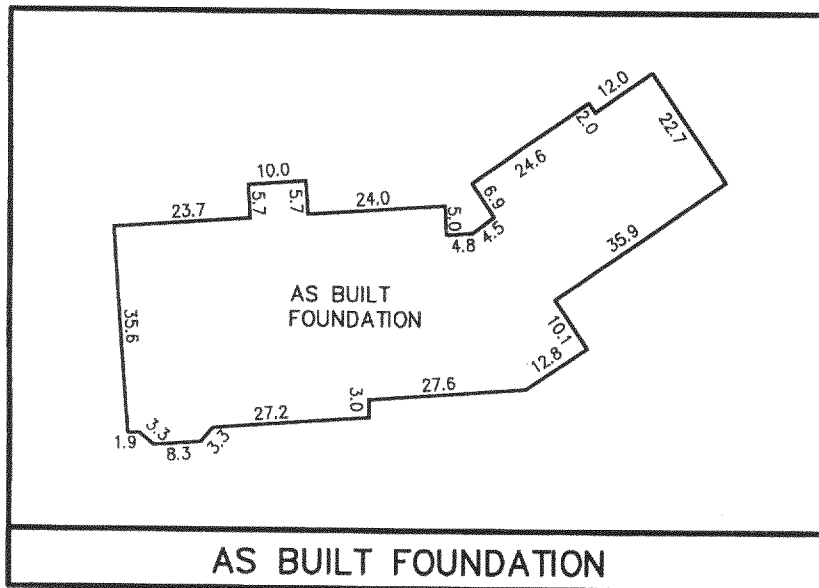

LEGEND

- = FOUND IRON PIPE STAKE
- (xxx) = RECORDED AS
- ⊗ = FOUND NAIL IN PAVEMENT

ASSIGNED WEST LINE OF OUTLOT 1
OF C.S.M. 1395 REC. IN VOL. 6,
PG. 259, AS DOC. NO. 108935
N 00°41'00" W

20 2003

KW


NOTE: COPIES OF THIS MAP TO WHICH THE FOLLOWING CERTIFICATE
WILL APPLY SHOW THE SURVEYOR'S ORIGINAL SEAL AND SIGNATURE
IN RED INK. COPIES BY ANY OTHER MEANS MAY HAVE ALTERATIONS
WHICH DO NOT REPRESENT THE SURVEYOR'S WORK PRODUCT.

I HEREBY CERTIFY THAT THE ABOVE DESCRIBED PROPERTY HAS BEEN
SURVEYED UNDER MY DIRECTION AND THAT THE ABOVE MAP IS A TRUE
REPRESENTATION THEREOF AND SHOWS THE SIZE AND LOCATION OF
THE PROPERTY AND ITS EXTERIOR BOUNDARIES. THIS SURVEY IS
MADE FOR THE USE OF THE PRESENT OWNERS OF THE PROPERTY, AND
ALSO THOSE WHO PURCHASE, MORTGAGE, OR GUARANTEE THE TITLE
THERETO WITHIN ONE YEAR FROM THE DATE HEREOF.

DATED: JULY 24, 2003

REVISED 10-28-03
TO SHOW SIZE & LOCATION OF
AS BUILT FOUNDATION

PETER S. GORDON R.L.S. 2101

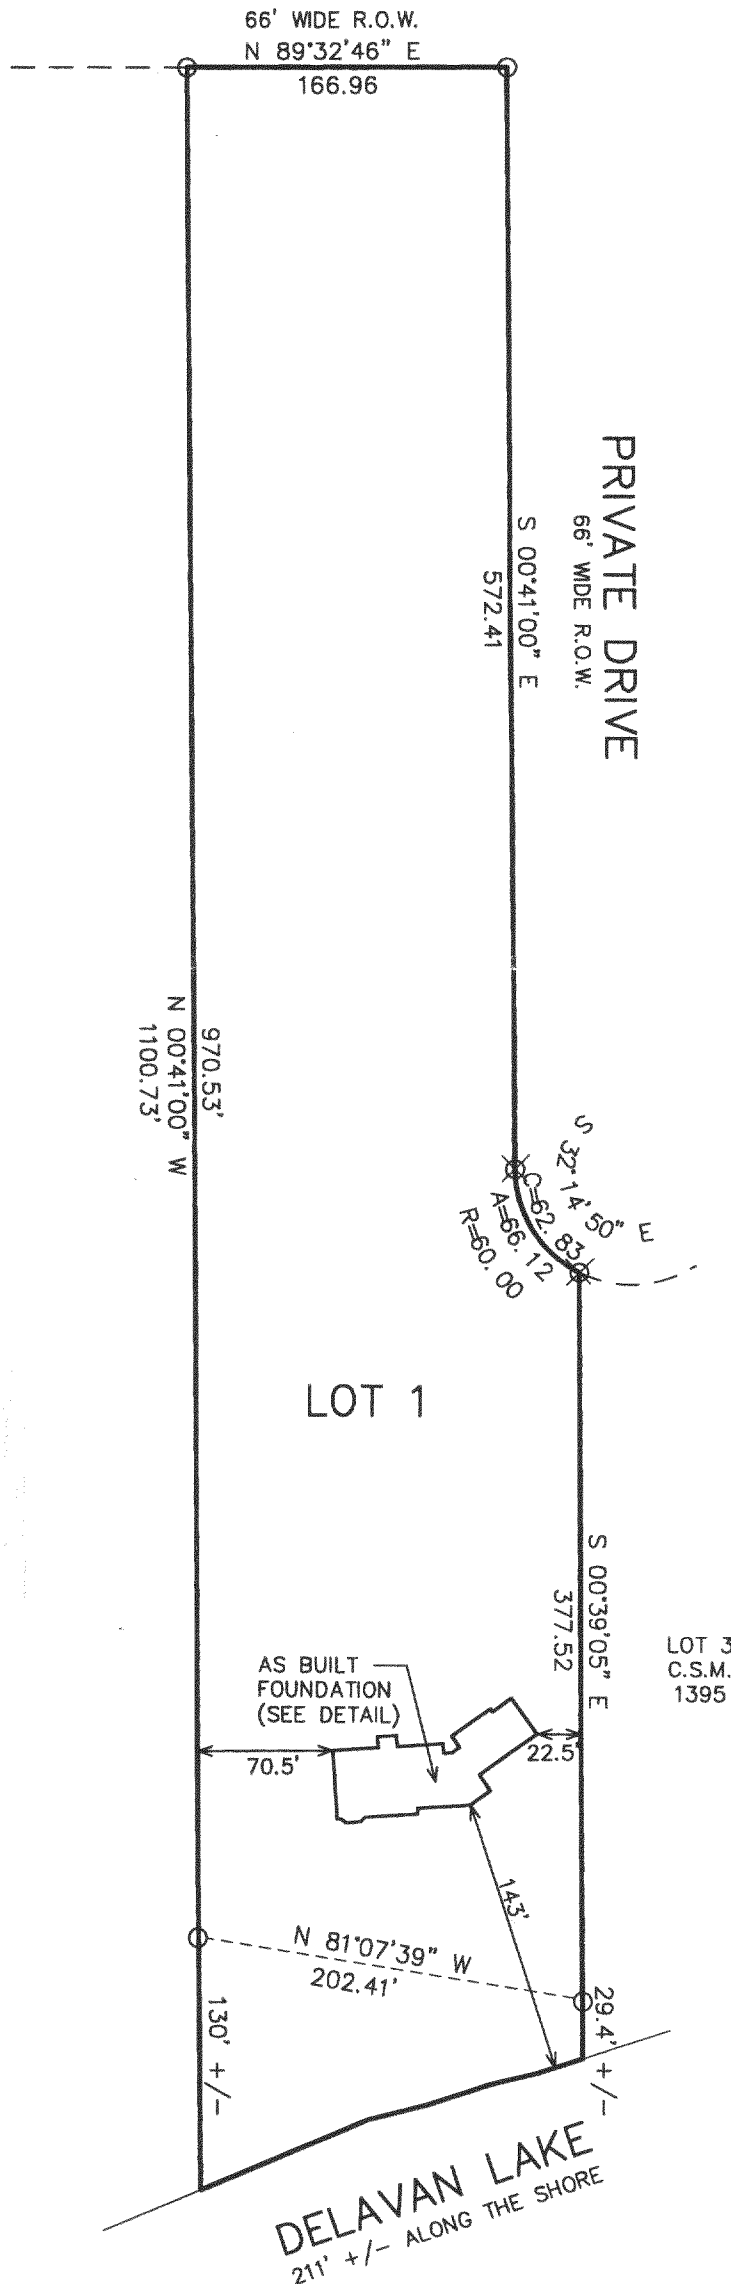

PROJECT: 6313
DATE: 07/24/2003
SHEET 1 OF 1

FA1395-1

216-3631