


HAROLD H. KOLB

REGISTERED PROFESSIONAL LAND SURVEYOR
LAKE GENEVA, WISCONSIN

Delavan Lake
Water Elevation
Feb. 2, 1965
94.46

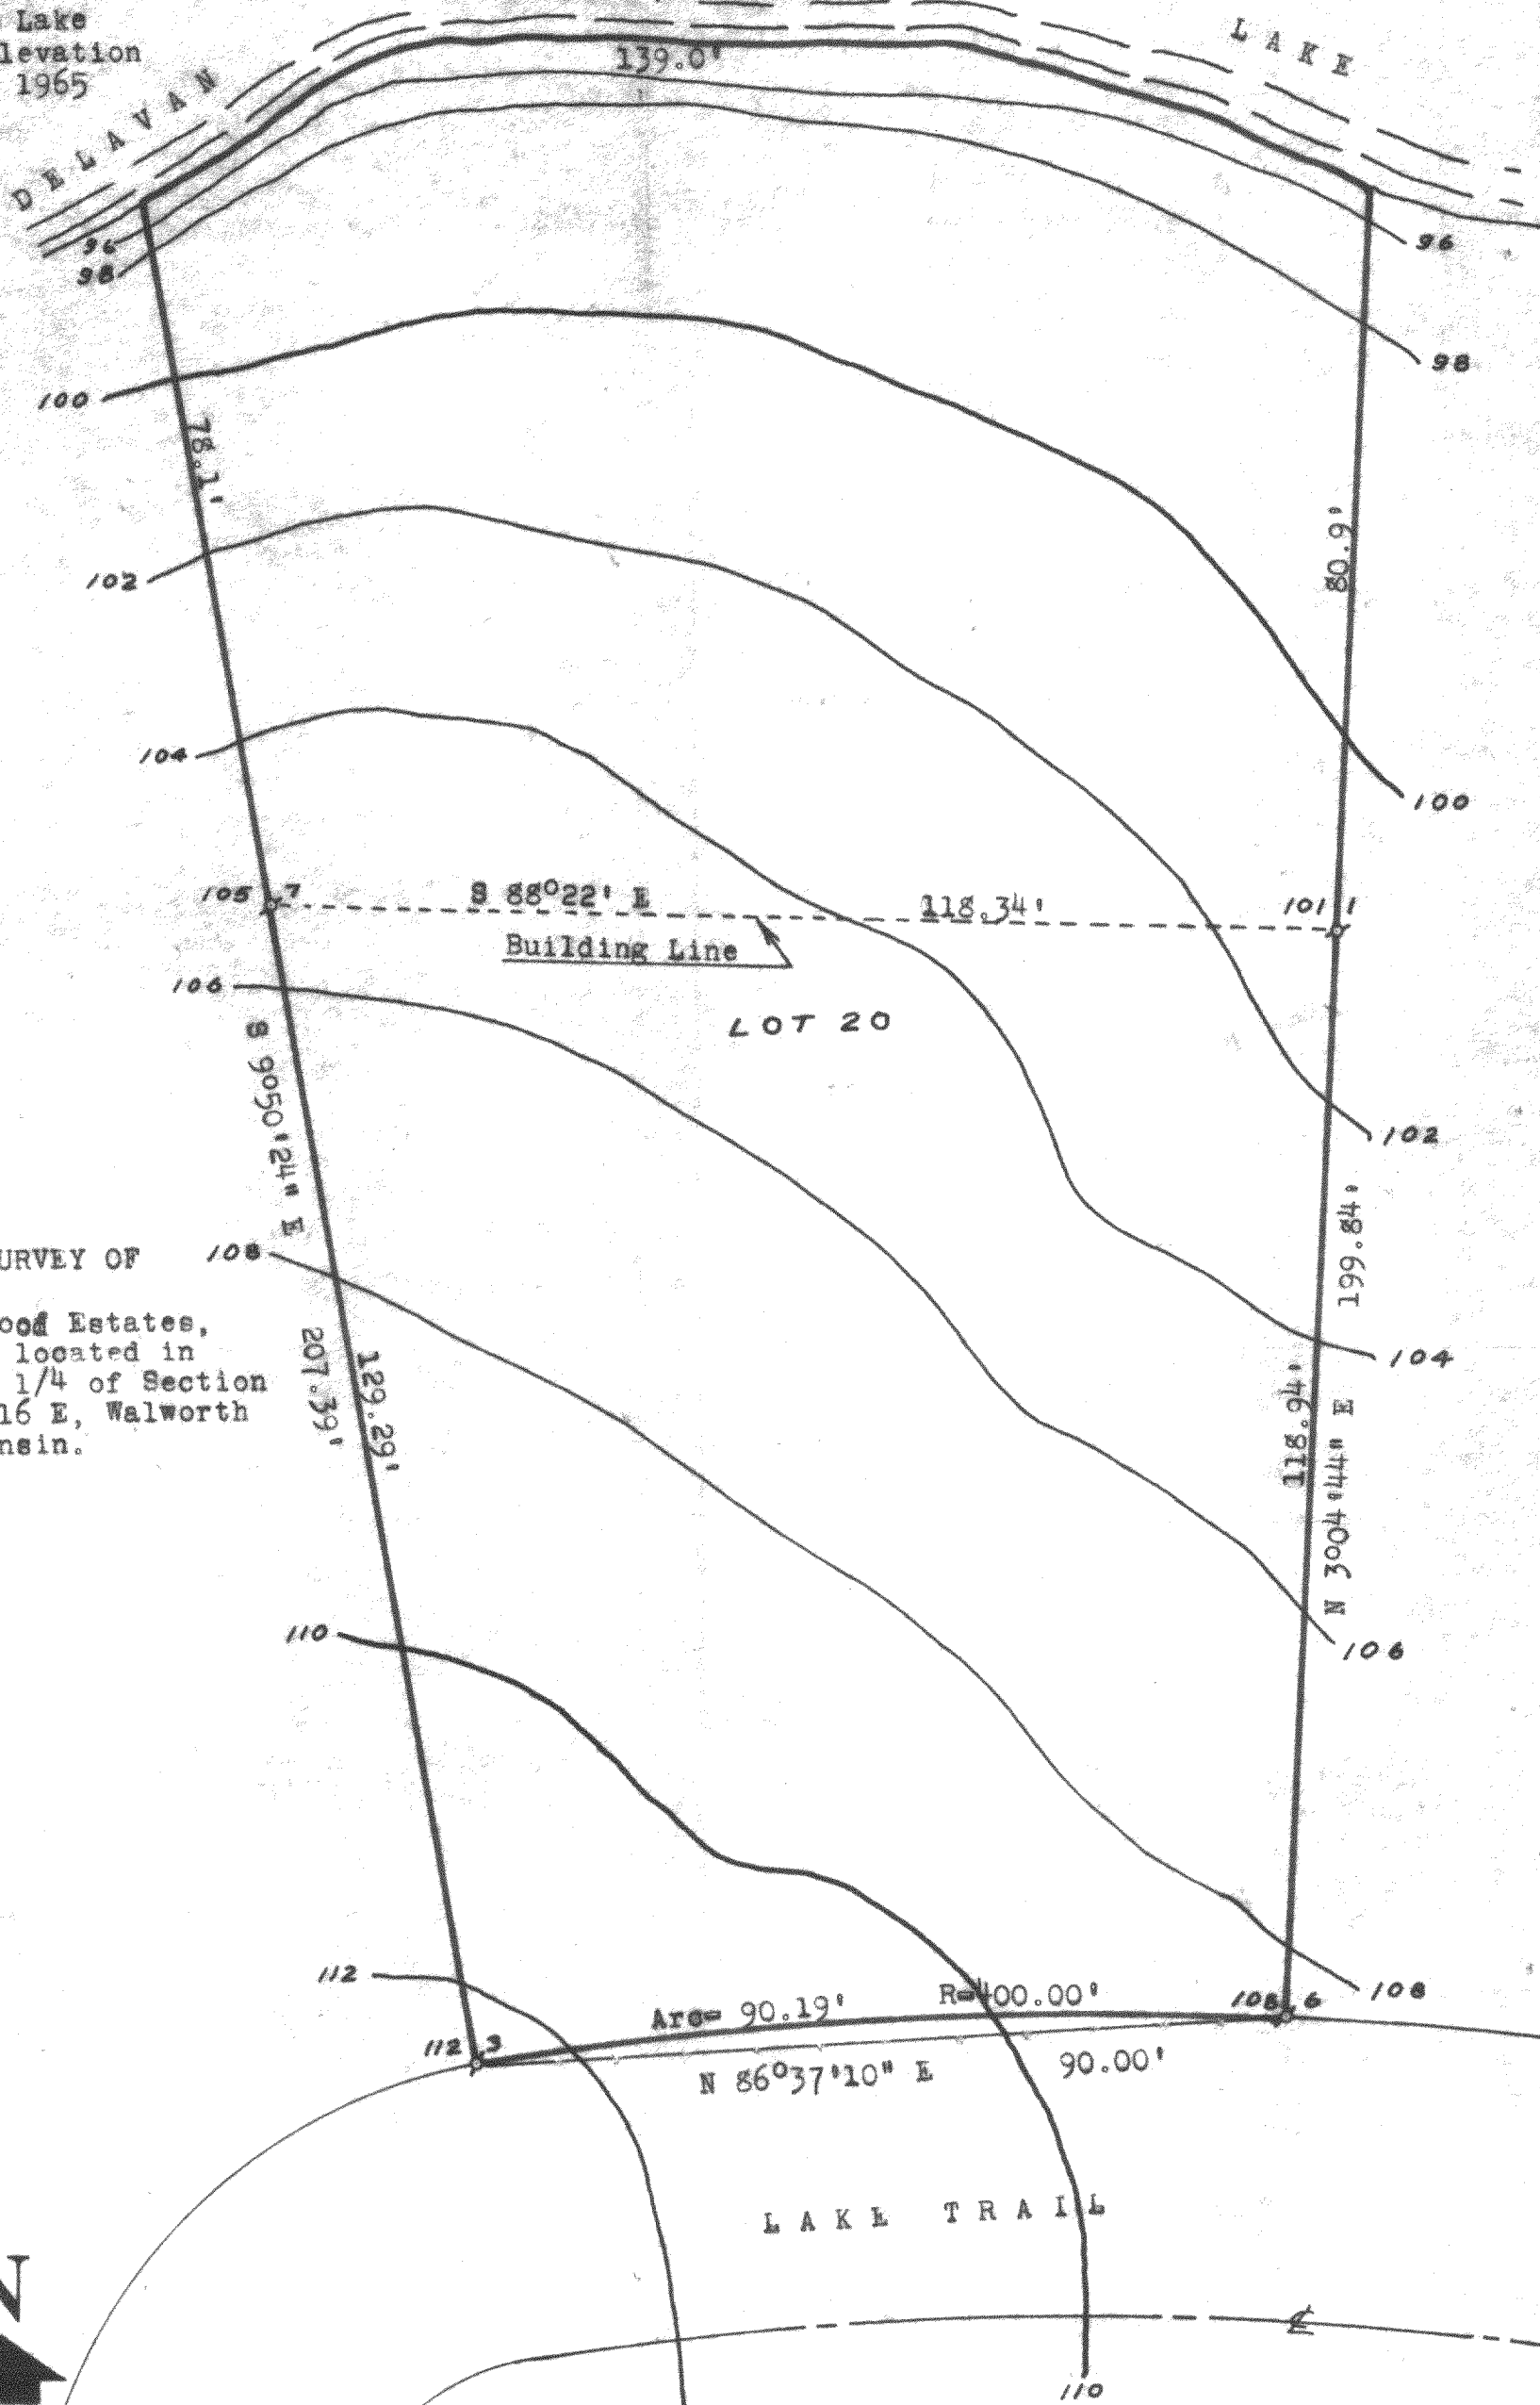

PLAT OF SURVEY OF

Lot 20, Lakewood Estates,
a subdivision located in
the Southwest 1/4 of Section
21, T 2 N, R 16 E, Walworth
County, Wisconsin.



LEGEND

- Ø - IRON PIPE FOUND
- O - IRON PIPE PLACED
- - CONCRETE MONUMENT
- X - SPIKE

I, HAROLD H. KOLB, DO HEREBY CERTIFY THAT I HAVE
SURVEYED THE PROPERTY HEREON DESCRIBED ACCORDING
TO THE OFFICIAL RECORDS, AND THAT THE PLAT HEREON
IS A CORRECT REPRESENTATION OF THE LOT LINES.

Harold H. Kolb
HAROLD H. KOLB

WISCONSIN REGISTERED LAND SURVEYOR, S-187
DATE February 8, 1965

FLE-20

216-364