



**HAROLD H. KOLB**  
REGISTERED PROFESSIONAL LAND SURVEYOR  
LAKE GENEVA, WISCONSIN

PLAT OF SURVEY OF  
Lots 4,5,6,7,8,9, Inlet  
Oaks, a subdivision loc-  
ated in T 2 N, R 16 E,  
Walworth County, Wiscon-  
sin.

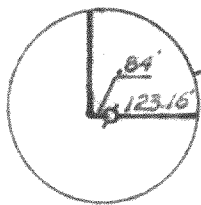

HIGHWAY 50

STATE TRUNK

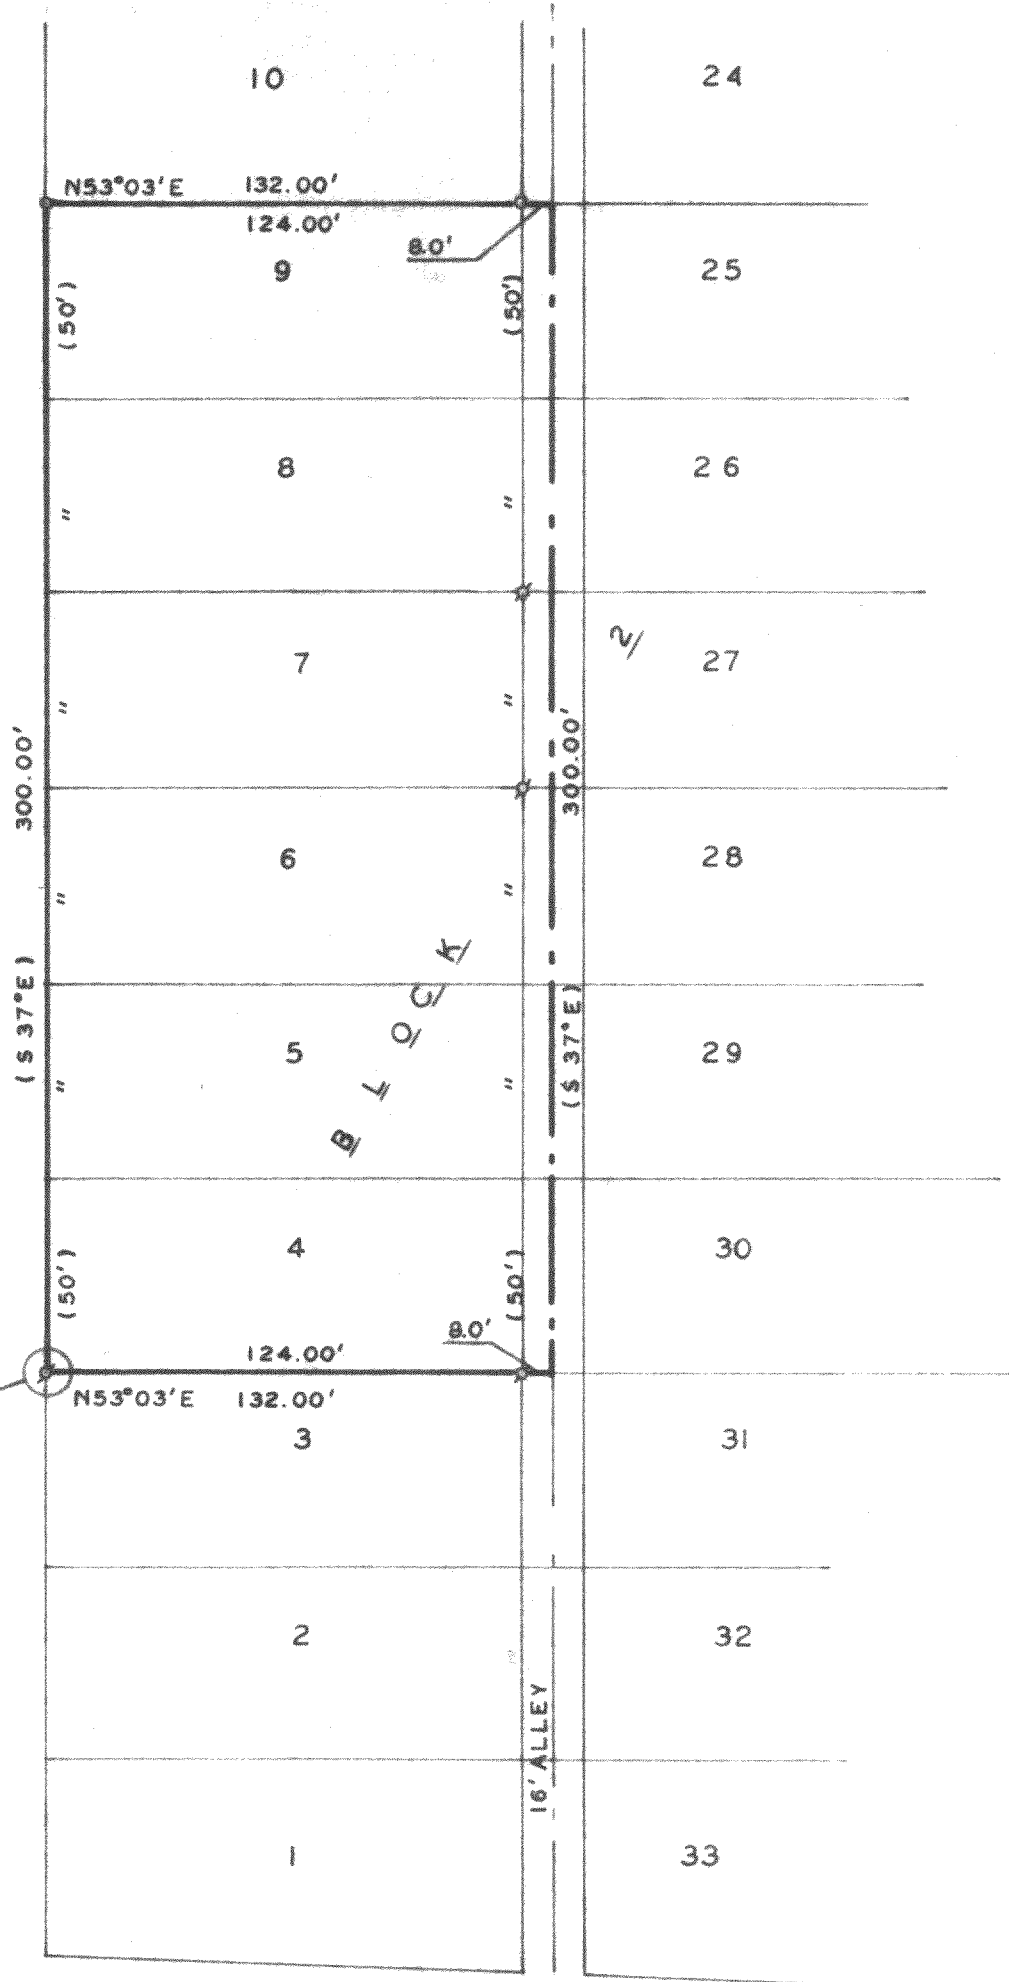

BLOCK 1

SCALE: 1"=50'

**LEGEND**

- - IRON PIPE FOUND
- - IRON PIPE PLACED
- - CONCRETE MONUMENT
- x - SPIKE

( ) - AS PLATTED



I, HAROLD H. KOLB, DO HEREBY CERTIFY THAT I HAVE  
SURVEYED THE PROPERTY HEREON DESCRIBED ACCORDING  
TO THE OFFICIAL RECORDS, AND THAT THE PLAT HEREON  
IS A CORRECT REPRESENTATION OF THE LOT LINES.

*Harold H. Kolb*

HAROLD H. KOLB

WISCONSIN REGISTERED LAND SURVEYOR, S-187

DATE March 26, 1968

FIN-13  
"-14

216-312