

# PLAT OF SURVEY


MIRACLE HOMES  
Meersman

**LOCATION:** 7958 Windmill Way, Delavan, Wisconsin


**LEGAL DESCRIPTION:** Lot 22 in **DUTCH MEADOWS SUBDIVISION**, located in the Northwest 1/4, Southwest 1/4 and Southeast 1/4 of the Northwest 1/4 of Section 31, Town 2 North, Range 16 East, Walworth County, Wisconsin.

April 19, 2004

Survey No. 97242

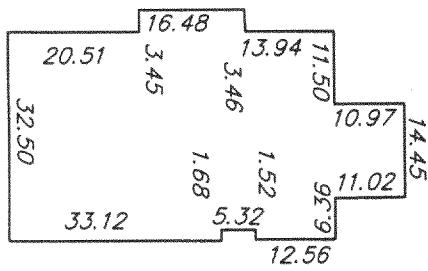

*House Detail*  
1"=30'

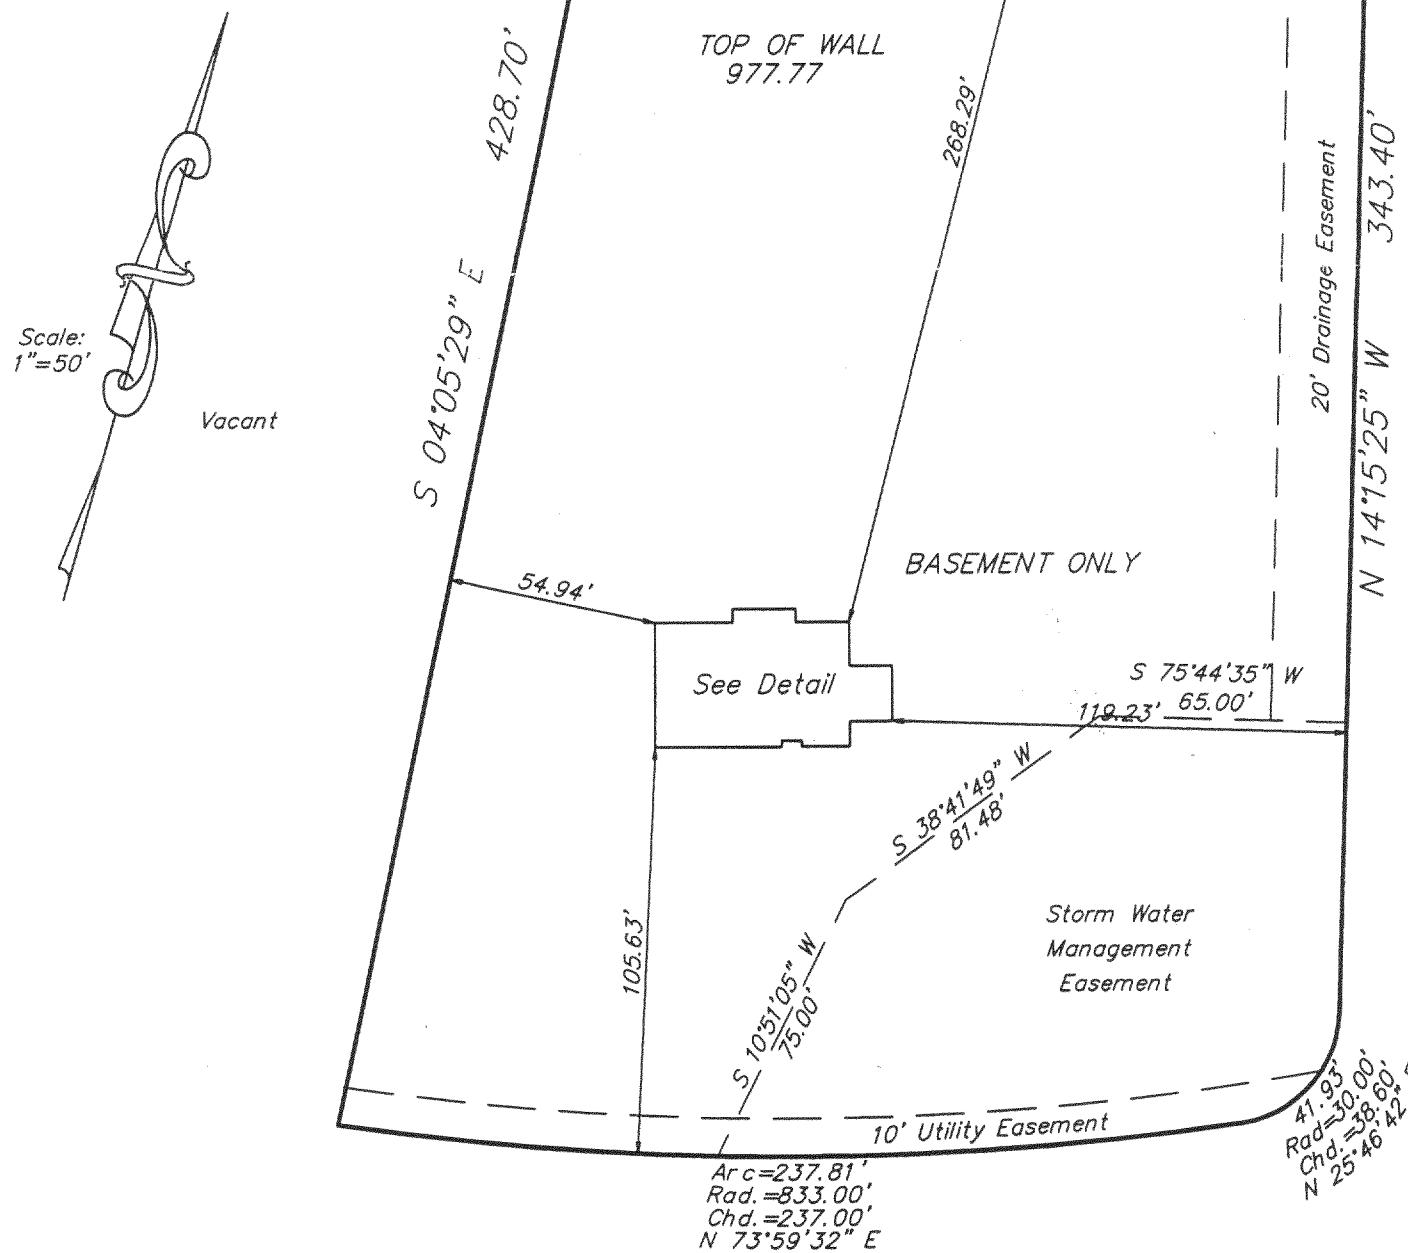


## Windmill Way

( 66' R.O.W. )

**METROPOLITAN SURVEY SERVICE, INC.**

REGISTERED LAND SURVEYORS AND CIVIL ENGINEERS  
5200 W. LOOMIS ROAD GREENDALE, WI 53129


PH. (414) 529-5380 FAX (414) 529-9787  
email address [survey@execpc.com](mailto:survey@execpc.com)

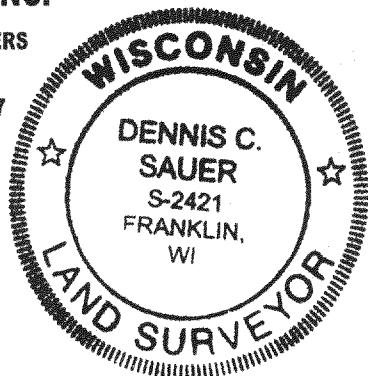

I HEREBY CERTIFY THAT I HAVE SURVEYED THE ABOVE DESCRIBED PROPERTY AND THAT THE ABOVE MAP IS A TRUE REPRESENTATION THEREOF AND SHOWS THE SIZE AND LOCATION OF THE PROPERTY, ITS EXTERIOR BOUNDARIES, THE LOCATION OF ALL VISIBLE STRUCTURES AND DIMENSIONS OF ALL PRINCIPAL BUILDINGS THEREON, BOUNDARY FENCES, APPARENT EASEMENTS AND ROADWAYS AND VISIBLE ENCROACHMENT, IF ANY.

THIS SURVEY IS MADE FOR THE EXCLUSIVE USE OF THE PRESENT OWNERS OF THE PROPERTY, AND ALSO THOSE WHO PURCHASE, MORTGAGE, OR GUARANTEE THE TITLE THERETO WITHIN ONE (1) YEAR FROM THE DATE HEREOF.

SIGNED \_\_\_\_\_

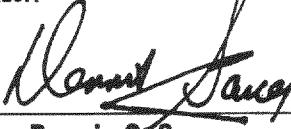  
Dennis C. Sauer  
Registered Land Surveyor S-2421

FDUT 00022

216-3725