


ABELL
SURVEYING & MAPPING
1140 SEQUOIA STREET • DELAVAN, WISCONSIN 53115
262-728-6737

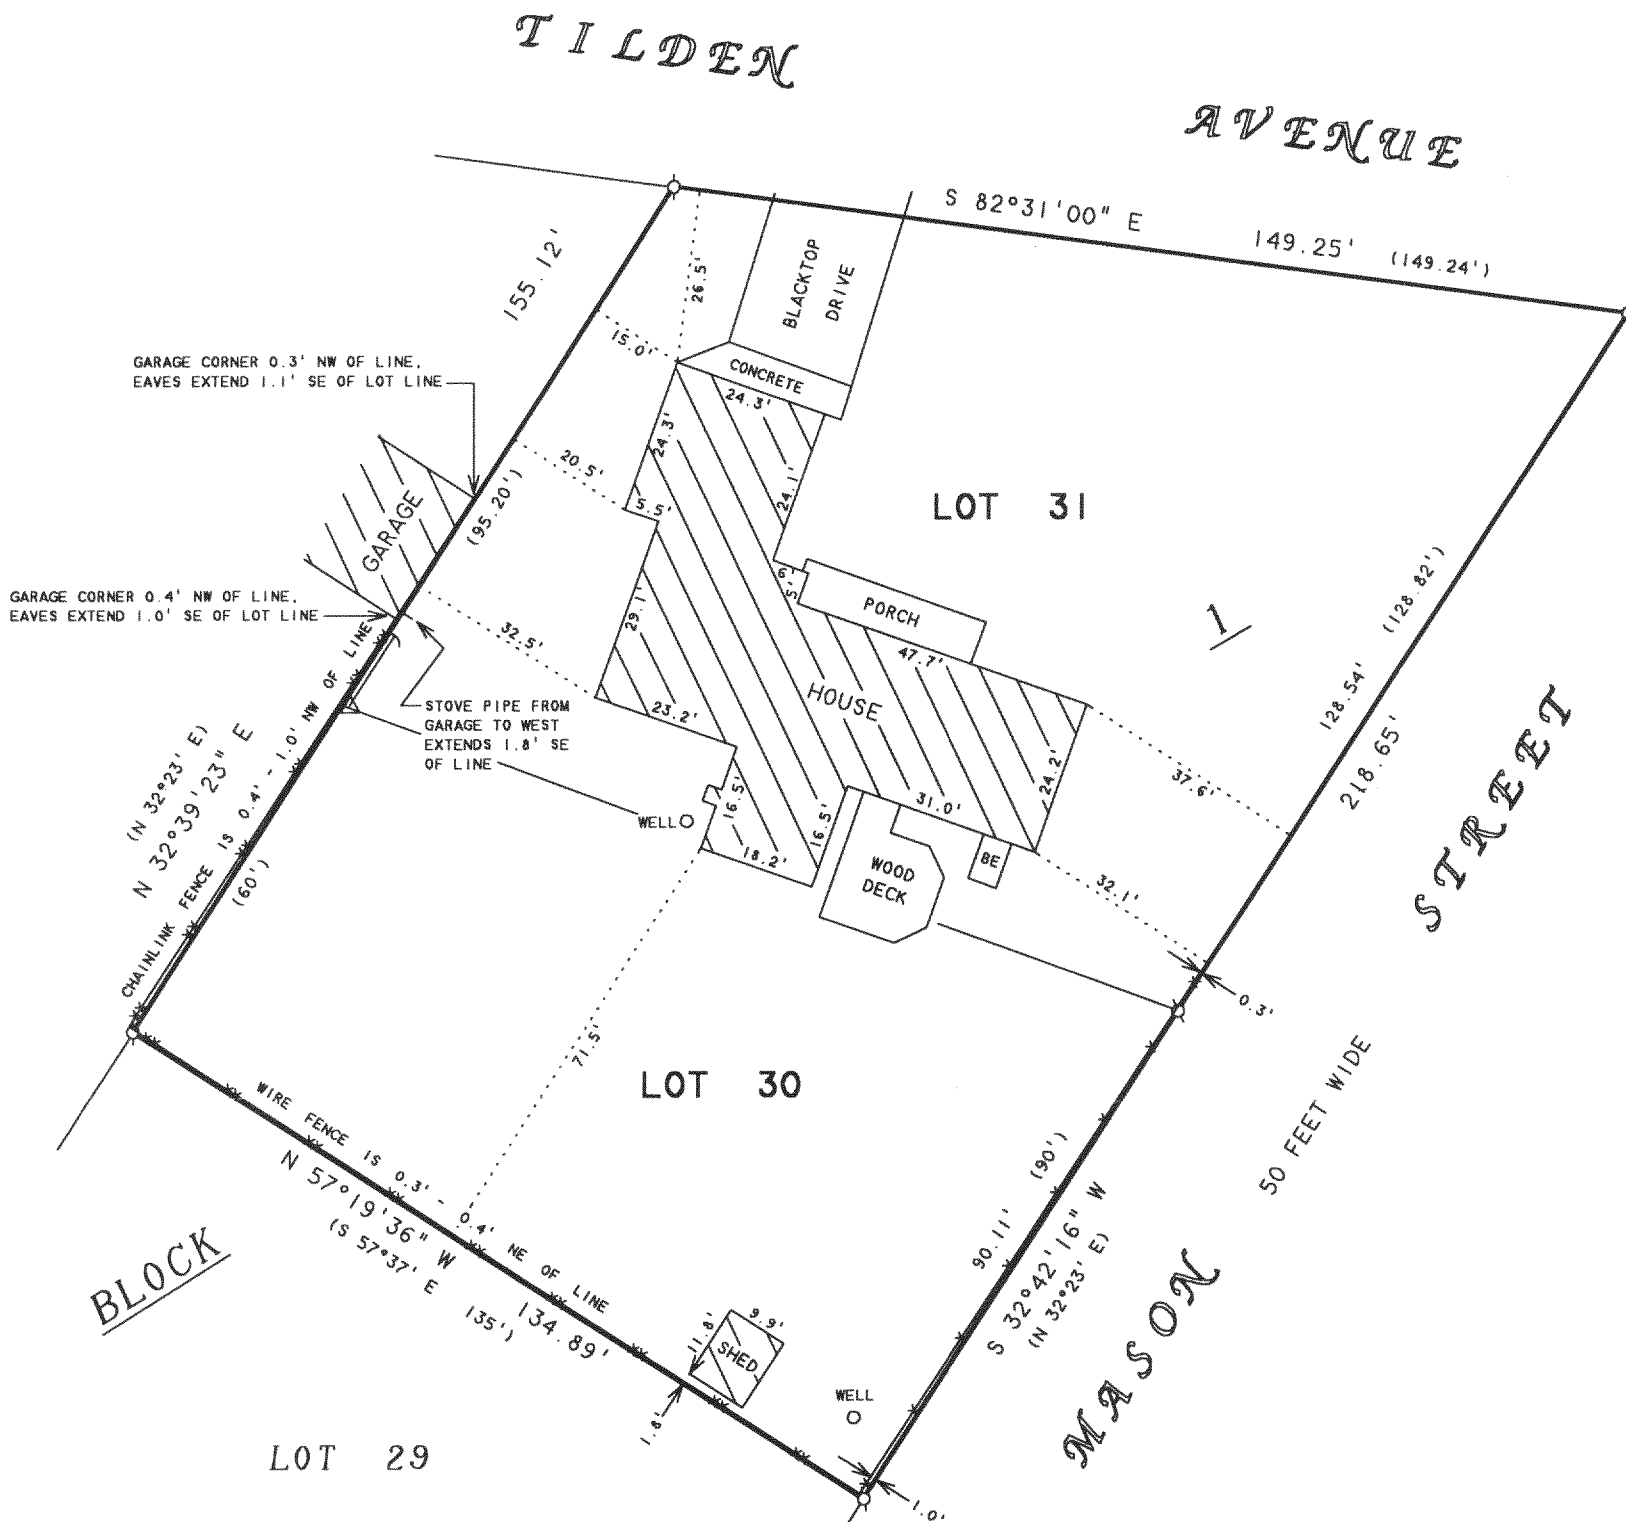

PLAT OF SURVEY OF

LOTS 30 AND 31, BLOCK 1, DELMAR SUBDIVISION,
T2N, R16E, WALWORTH COUNTY, WISCONSIN,
CONTAINING 0.58 ACRES.

ORDERED BY: RUSS HENDERSON
2509 TILDEN AVENUE
DELAVAN, WI 53115

REVISED: FEBRUARY 17, 2004 TO SHOW
THE NEW GARAGE.

I HEREBY CERTIFY THAT I HAVE SURVEYED THE ABOVE DESCRIBED PROPERTY AND THAT THE ABOVE MAP IS A TRUE REPRESENTATION THEREOF AND SHOWS THE SIZE AND LOCATION OF THE PROPERTY, ITS EXTERIOR BOUNDARIES, THE LOCATION OF ALL VISIBLE STRUCTURES AND DIMENSIONS OF ALL PRINCIPAL BUILDINGS THEREON, BOUNDARY FENCES, APPARENT EASEMENTS, ROADWAYS AND VISIBLE ENCROACHMENTS, IF ANY, TO THE BEST OF MY KNOWLEDGE AND BELIEF.

THIS SURVEY IS MADE FOR THE USE OF THE PRESENT OWNERS OF THE PROPERTY, AND ALSO THOSE WHO PURCHASE, MORTGAGE, OR GUARANTEE THE TITLE THERETO WITHIN ONE (1) YEAR FROM DATE HEREON.

David F. Abell

DAVID F. ABELL
WISCONSIN REGISTERED LAND SURVEYOR, S-1596

March 21, 2003

DATE JOB NUMBER - 03030A
NOTE: THIS IS NOT A CERTIFIED COPY UNLESS SEALED.

FDM 00008

216-3744