

**PLAT OF SURVEY**

**LOCATION:** 7960 Windmill Way, Delavan, Wisconsin


**LEGAL DESCRIPTION:** Lot 21 in DUTCH MEADOWS SUBDIVISION, located in the Northwest 1/4, Southwest 1/4 and Southeast 1/4 of the Northwest 1/4 of Section 31, Town 2 North, Range 16 East, in the Town of Delavan, Walworth County, Wisconsin.

July 30, 2004  
Revised Legal Description 8/04/04


Survey No. 97617



Scale:  
1"=50'

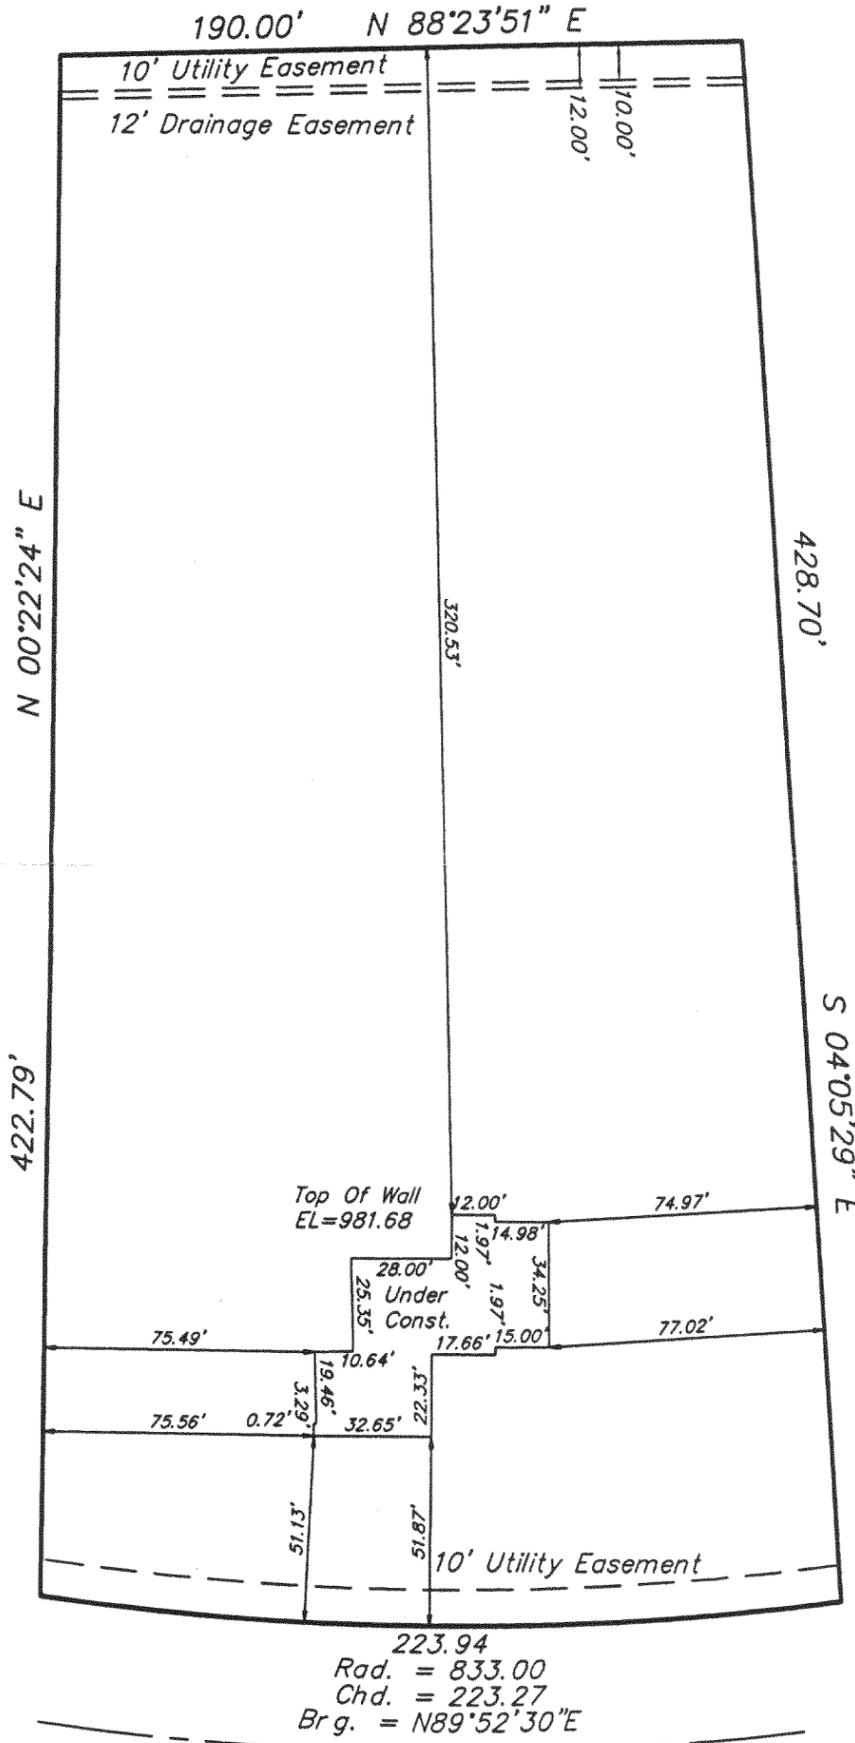

*Windmill Way*  
( 66' R.O.W. )

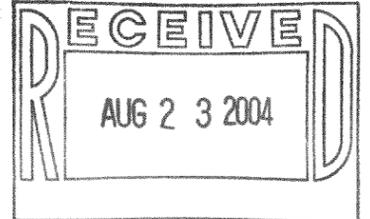

**METROPOLITAN SURVEY SERVICE, INC.**  
REGISTERED LAND SURVEYORS AND CIVIL ENGINEERS  
5200 W. LOOMIS ROAD GREENDALE, WI 53129  
PH. (414) 529-5380 FAX (414) 529-8787  
email address survey@execpc.com

I HEREBY CERTIFY THAT I HAVE SURVEYED THE ABOVE DESCRIBED PROPERTY AND THAT THE ABOVE MAP IS A TRUE REPRESENTATION THEREOF AND SHOWS THE SIZE AND LOCATION OF THE PROPERTY, ITS EXTERIOR BOUNDARIES, THE LOCATION OF ALL VISIBLE STRUCTURES AND DIMENSIONS OF ALL PRINCIPAL BUILDINGS THEREON, BOUNDARY FENCES, APPARENT EASEMENTS AND ROADWAYS AND VISIBLE ENCROACHMENT, IF ANY.

THIS SURVEY IS MADE FOR THE EXCLUSIVE USE OF THE PRESENT OWNERS OF THE PROPERTY, AND ALSO THOSE WHO PURCHASE, MORTGAGE, OR GUARANTEE THE TITLE THERETO WITHIN ONE (1) YEAR FROM THE DATE HEREOF.

SIGNED Dennis C. Sauer

FDUT-21

216-3811