

1000 JOURNAL OF POST KEYNESIAN ECONOMICS

FARRIS, HANSEN & ASSOCIATES, INC.
ENGINEERING — ARCHITECTURE — SURVEYING
7 RIDGWAY COURT P.O. BOX 437
ELKHORN, WISCONSIN 53121
OFFICE: (262) 723-2098 FAX: (262) 723-5886

PROJECT NO.	6133.01
DATE:	03/05/2004
SHEET NO.	1 OF 1




PETER S. GORDON R.L.S. 2101

GRID NORTH
WISCONSIN COORDINATE SYSTEM
SOUTH ZONE

ASSIGNED SOUTH LINE OF THE SW 1/4
SECTION 29--02--16
S 89°03'04" W

LEGEND

- = FOUND IRON PIPE STAKE, 1 1/8" O.D.
- = FOUND IRON REBAR STAKE, 3/4" DIA.
- = FOUND CONCRETE COUNTY MONUMENT
W/ BRASS CAP
- ⦿ = SET IRON REBAR STAKE 3/4" DIA. x
24" x 1.5 LBS./FT.
- (XXX) = RECORDED AS

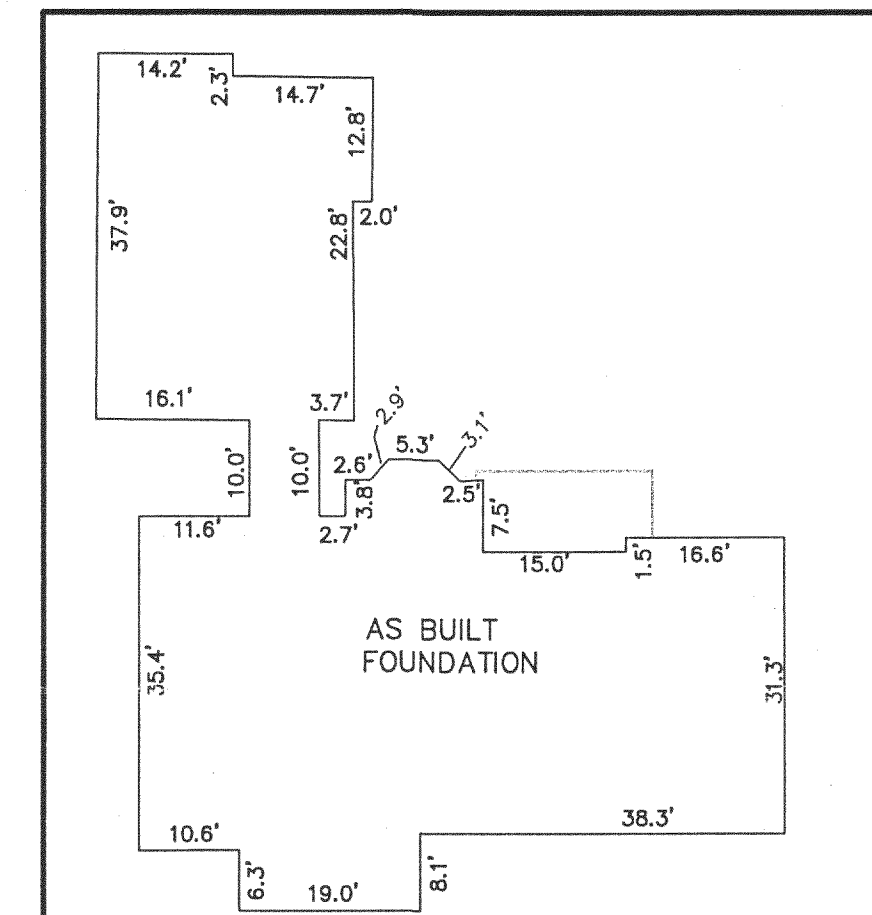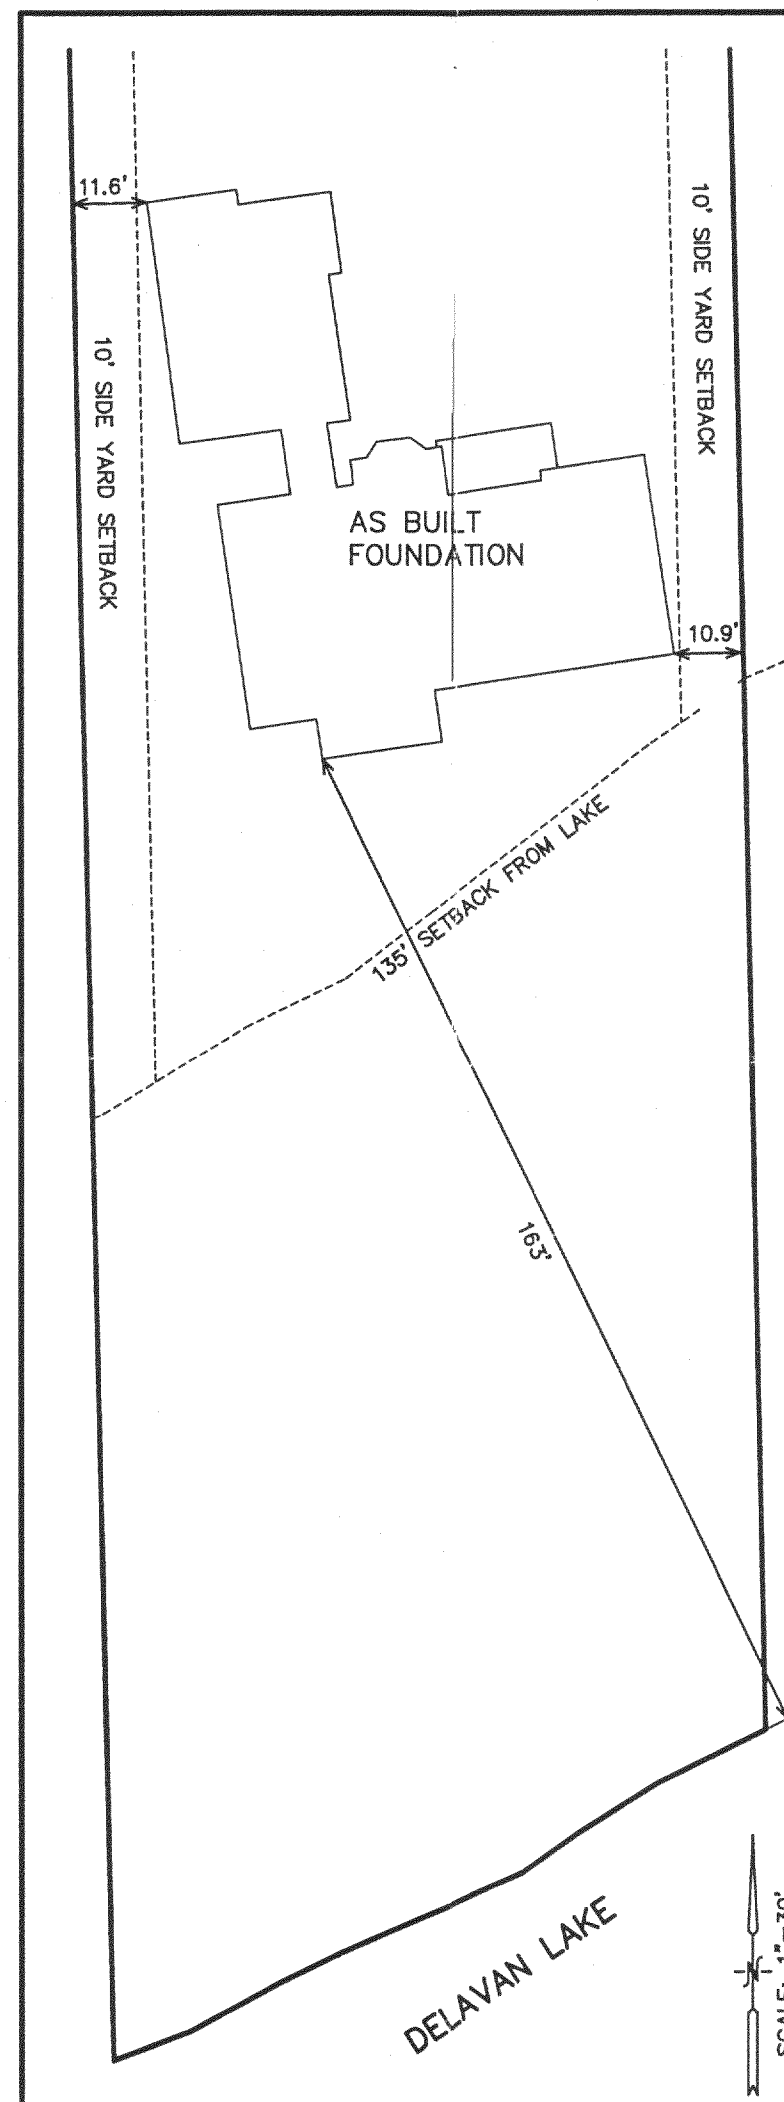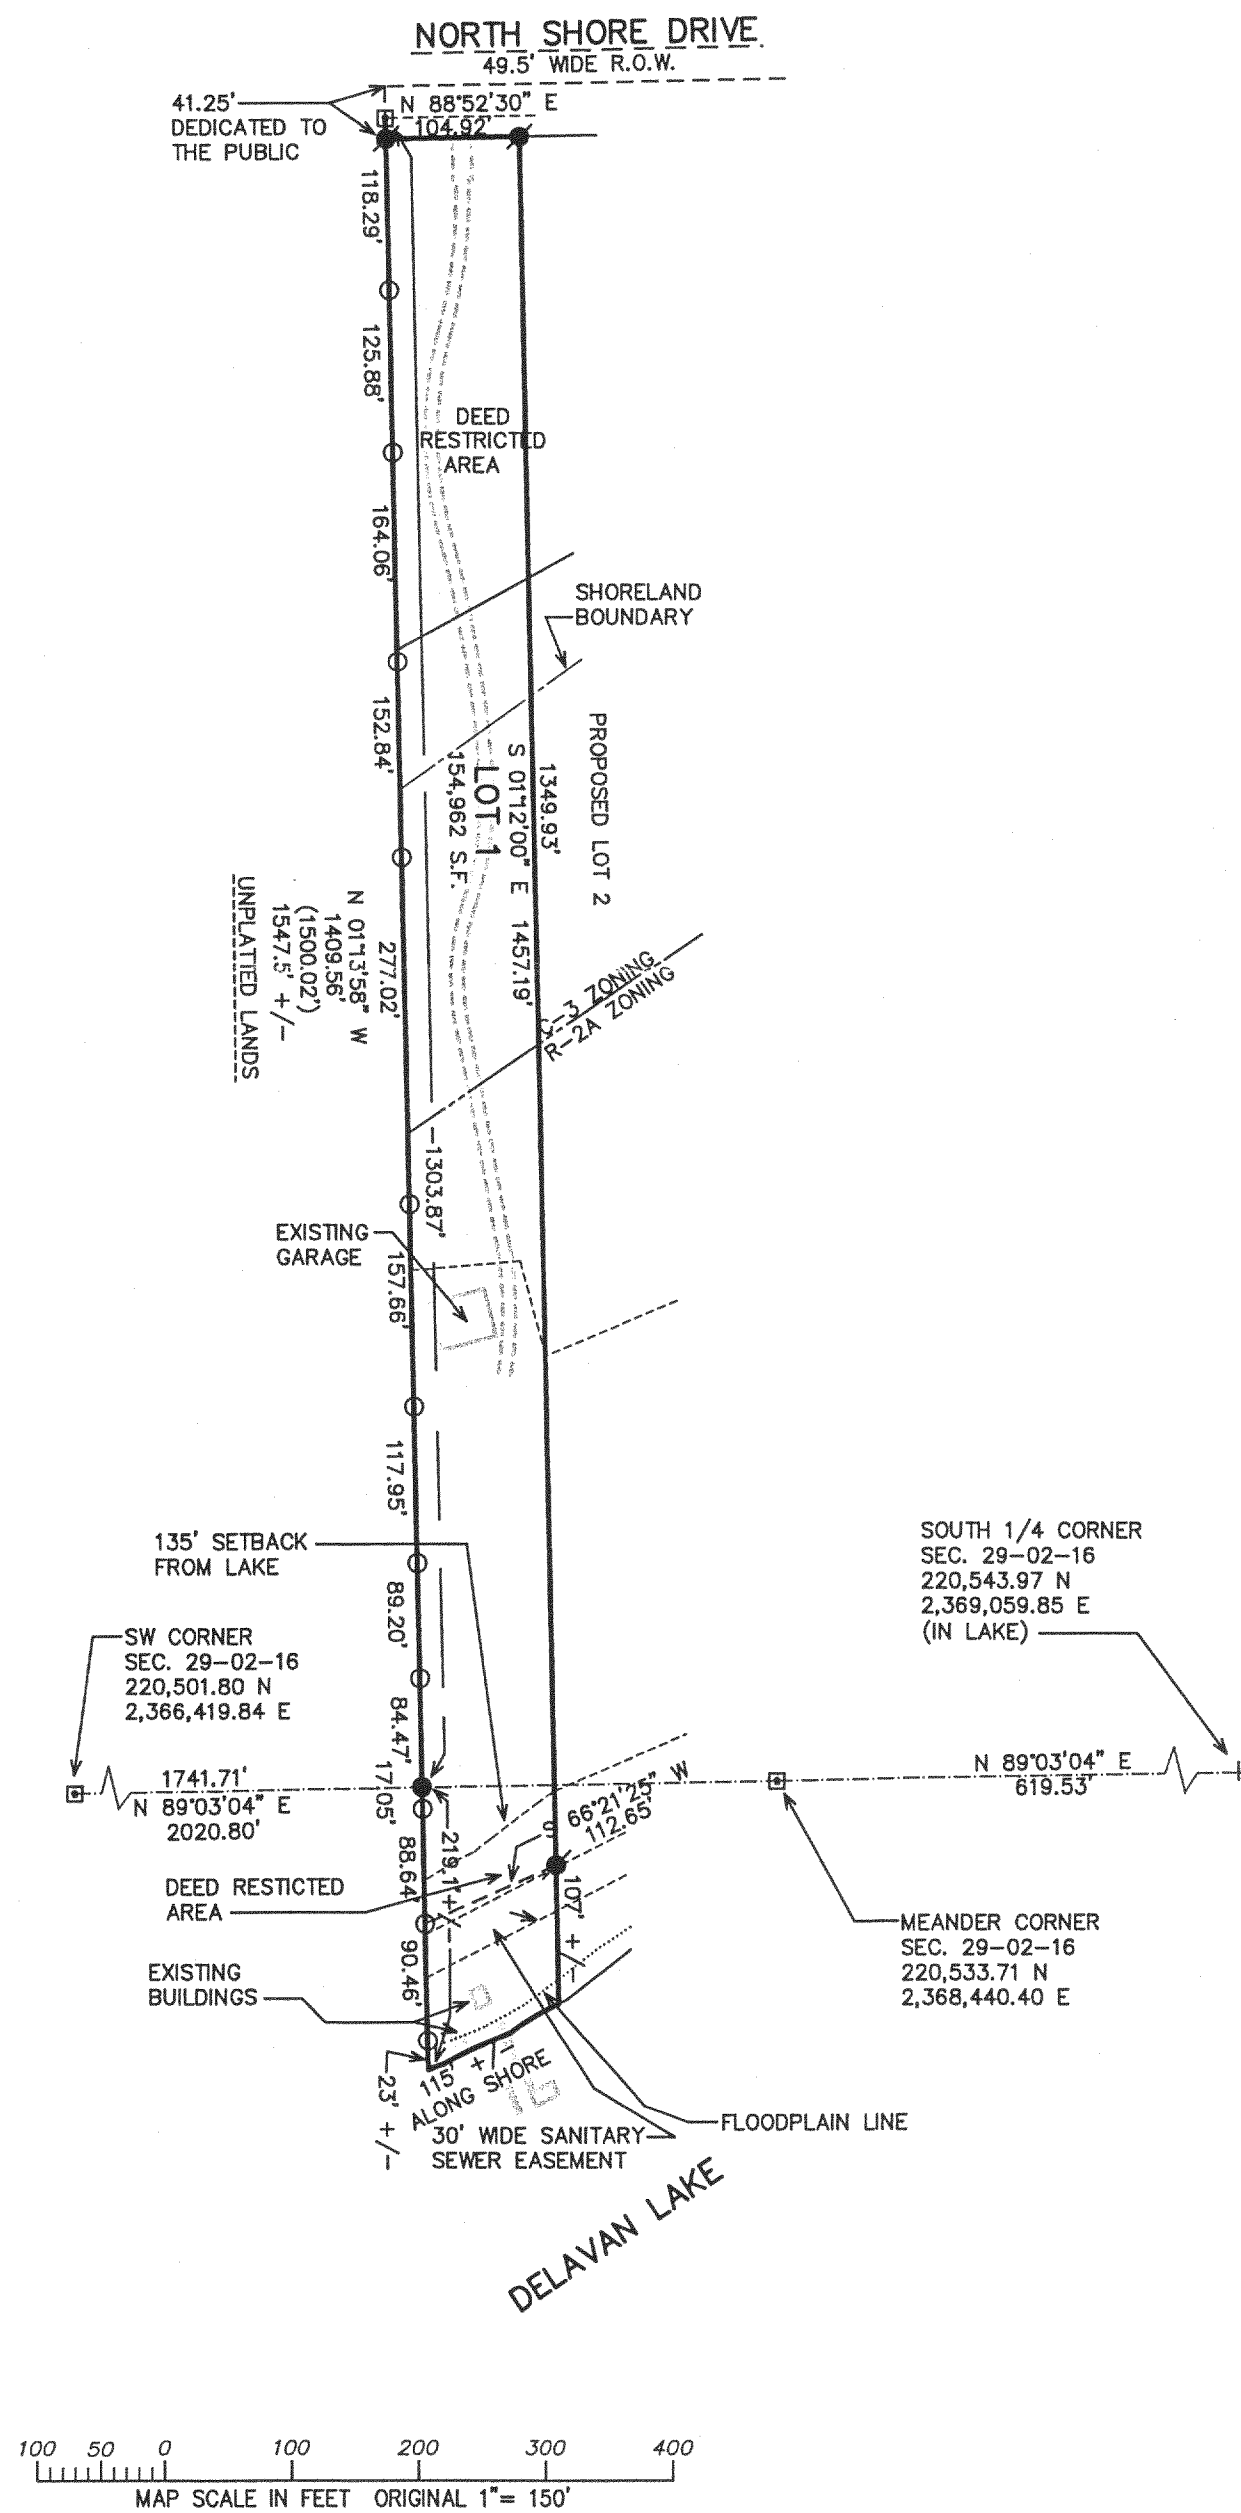

RECEIVED
AUG 24 2004

FA361600001