
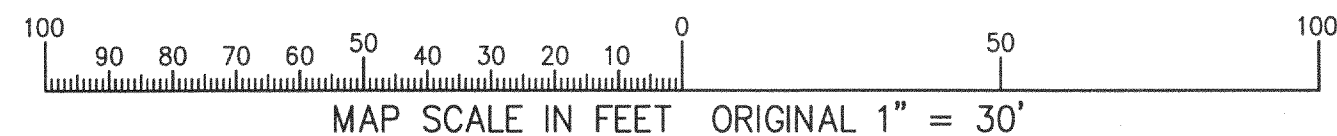


PLAT OF SURVEY

LOT 14 OF DUTCH MEADOWS SUBDIVISION

LOCATED IN THE NW 1/4, SW 1/4 OF THE NW 1/4 OF SECTION
31, TOWN 2 NORTH, RANGE 16 EAST, WALWORTH COUNTY, WISCONSIN

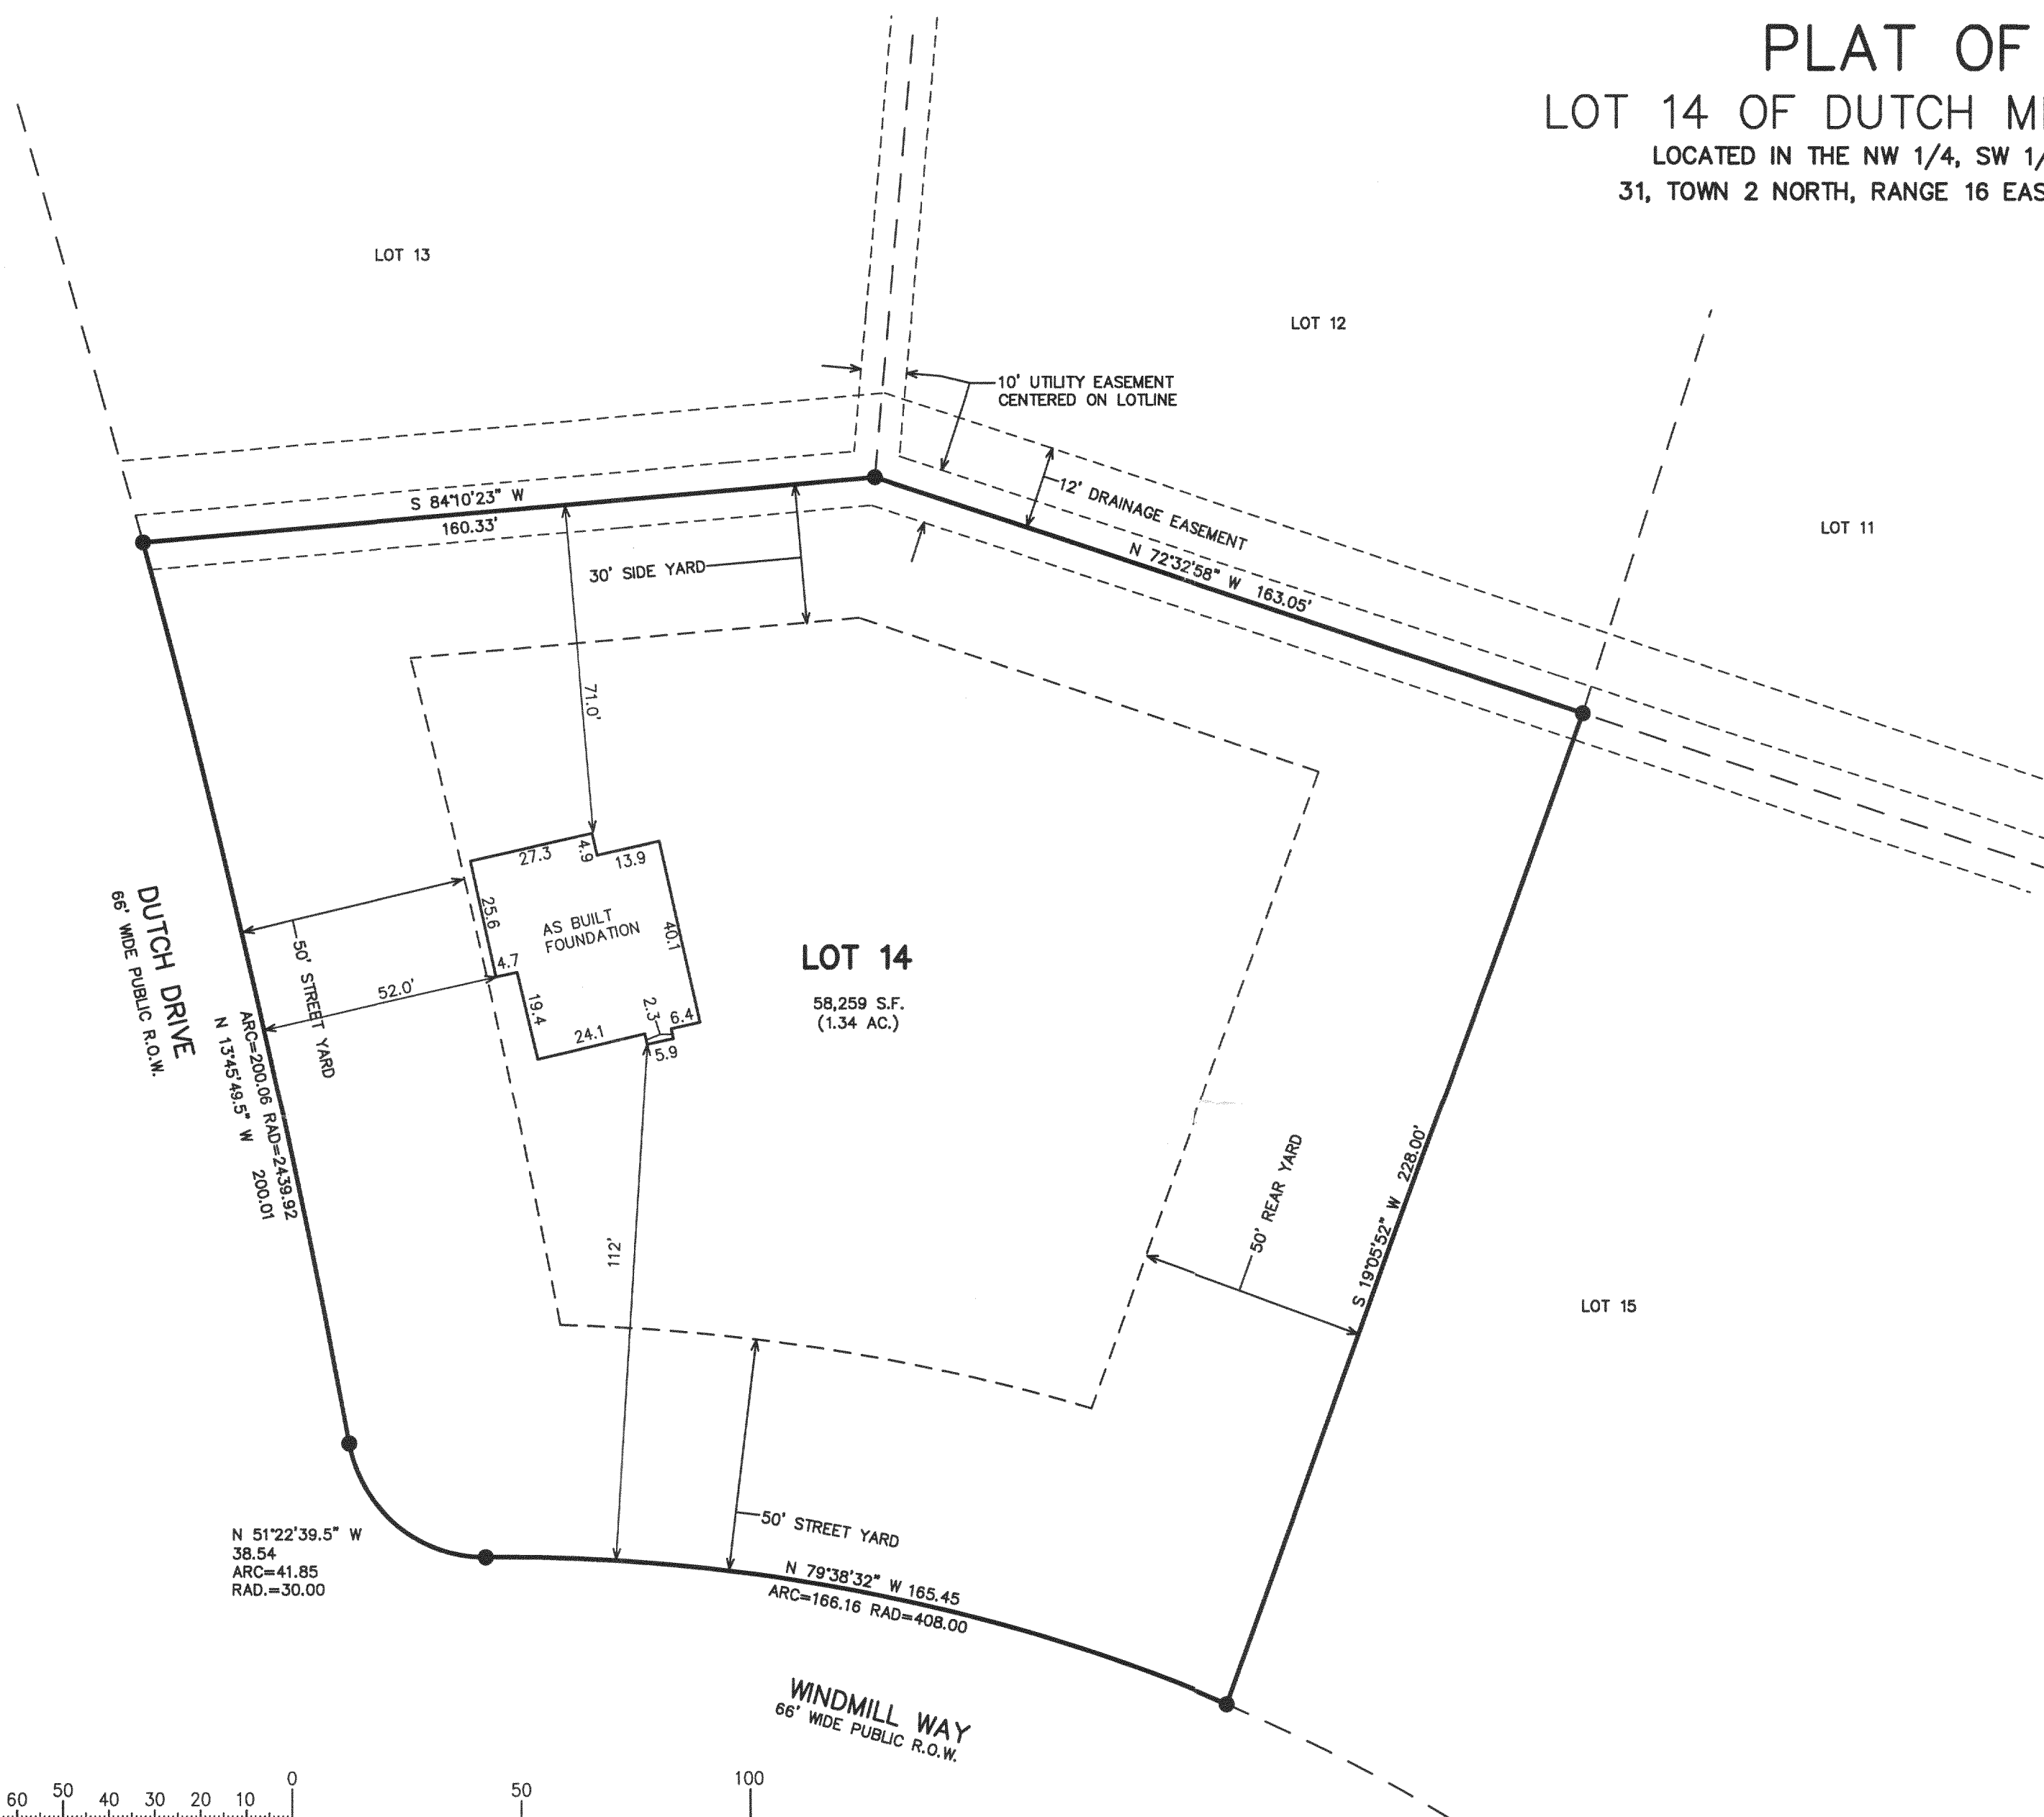

NOTE: COPIES OF THIS MAP TO WHICH THE FOLLOWING CERTIFICATE WILL APPLY SHOW SURVEYOR'S ORIGINAL SEAL AND SIGNATURE IN RED INK. COPIES BY ANY OTHER MEANS MAY HAVE ALTERATIONS WHICH DO NOT REPRESENT THE SURVEYOR'S WORK PRODUCT.


I HEREBY CERTIFY THAT THE ABOVE DESCRIBED PROPERTY HAS BEEN SURVEYED UNDER MY DIRECTION AND THAT THE ABOVE MAP IS A TRUE REPRESENTATION THEREOF AND SHOWS THE SIZE AND LOCATION OF THE PROPERTY AND ITS EXTERIOR BOUNDARIES. THIS SURVEY IS MADE FOR THE USE OF THE PRESENT OWNERS OF THE PROPERTY, AND ALSO THOSE WHO PURCHASE, MORTGAGE, OR GUARANTEE THE TITLE THERETO WITHIN ONE YEAR FROM THE DATE HEREOF.

DATED: 02-18-2002



Peter S. Gordon
PETER S. GORDON R.L.S. 2101

REVISED 05-12-2004
TO SHOW SIZE & LOCATION OF
PROPOSED RESIDENCE

REVISED 06-14-2004
TO SHOW SIZE & LOCATION OF
AS BUILT FOUNDATION

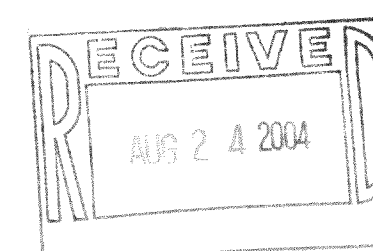

- = SET IRON REBAR STAKE
- (xxx) = RECORDED AS
- ⊕ = HYDRANT
- Ⓜ = SANITARY MANHOLE

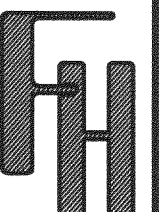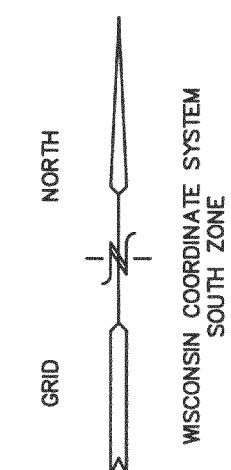

DUTCH MEADOWS SUBDIVISION
PLAT OF SURVEY - LOT 14

WORK ORDERED FOR CHRIS HEMBROOK
BY CHRIS RHYNER
2019 ALMOND DRIVE
DELANAN, WI. 53115

FARRIS, HANSEN & ASSOCIATES, INC.
Engineering, Architecture, Surveying
7 Ridgway Court P.O. Box 437
ELKHORN, WISCONSIN 53121
Office: (262) 723-2098
Fax: (262) 723-5886

REVISIONS

PROJECT NO.
5139.14
DATE:
02/08/2002
SHEET NO.
1 OF 1