


PLAT OF SURVEY

LOT 30 OF DUTCH MEADOWS SUBDIVISION

LOCATED IN THE NW 1/4, SW 1/4 OF THE NW 1/4 OF SECTION
31, TOWN 2 NORTH, RANGE 16 EAST, WALWORTH COUNTY, WISCONSIN

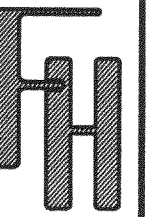


DUTCH MEADOWS SUBDIVISION
PLAT OF SURVEY - LOT 30

WORK ORDERED BY -
KRIS RHYNER
2019 ALMOND DRIVE
DELANAV, WI. 53115

FARRIS, HANSEN & ASSOCIATES, INC.
Engineering, Architecture, Surveying
7 Ridgway Court P.O. Box 437
ELKHORN, WISCONSIN 53121
Office: (262) 723-2098
Fax: (262) 723-5886

REVISIONS
06-16-2004
TO SHOW SIZE
& LOCATION
OF PRO. RES.

PROJECT NO.
5139.30
DATE:
02/08/2002
SHEET NO.
1 OF 1


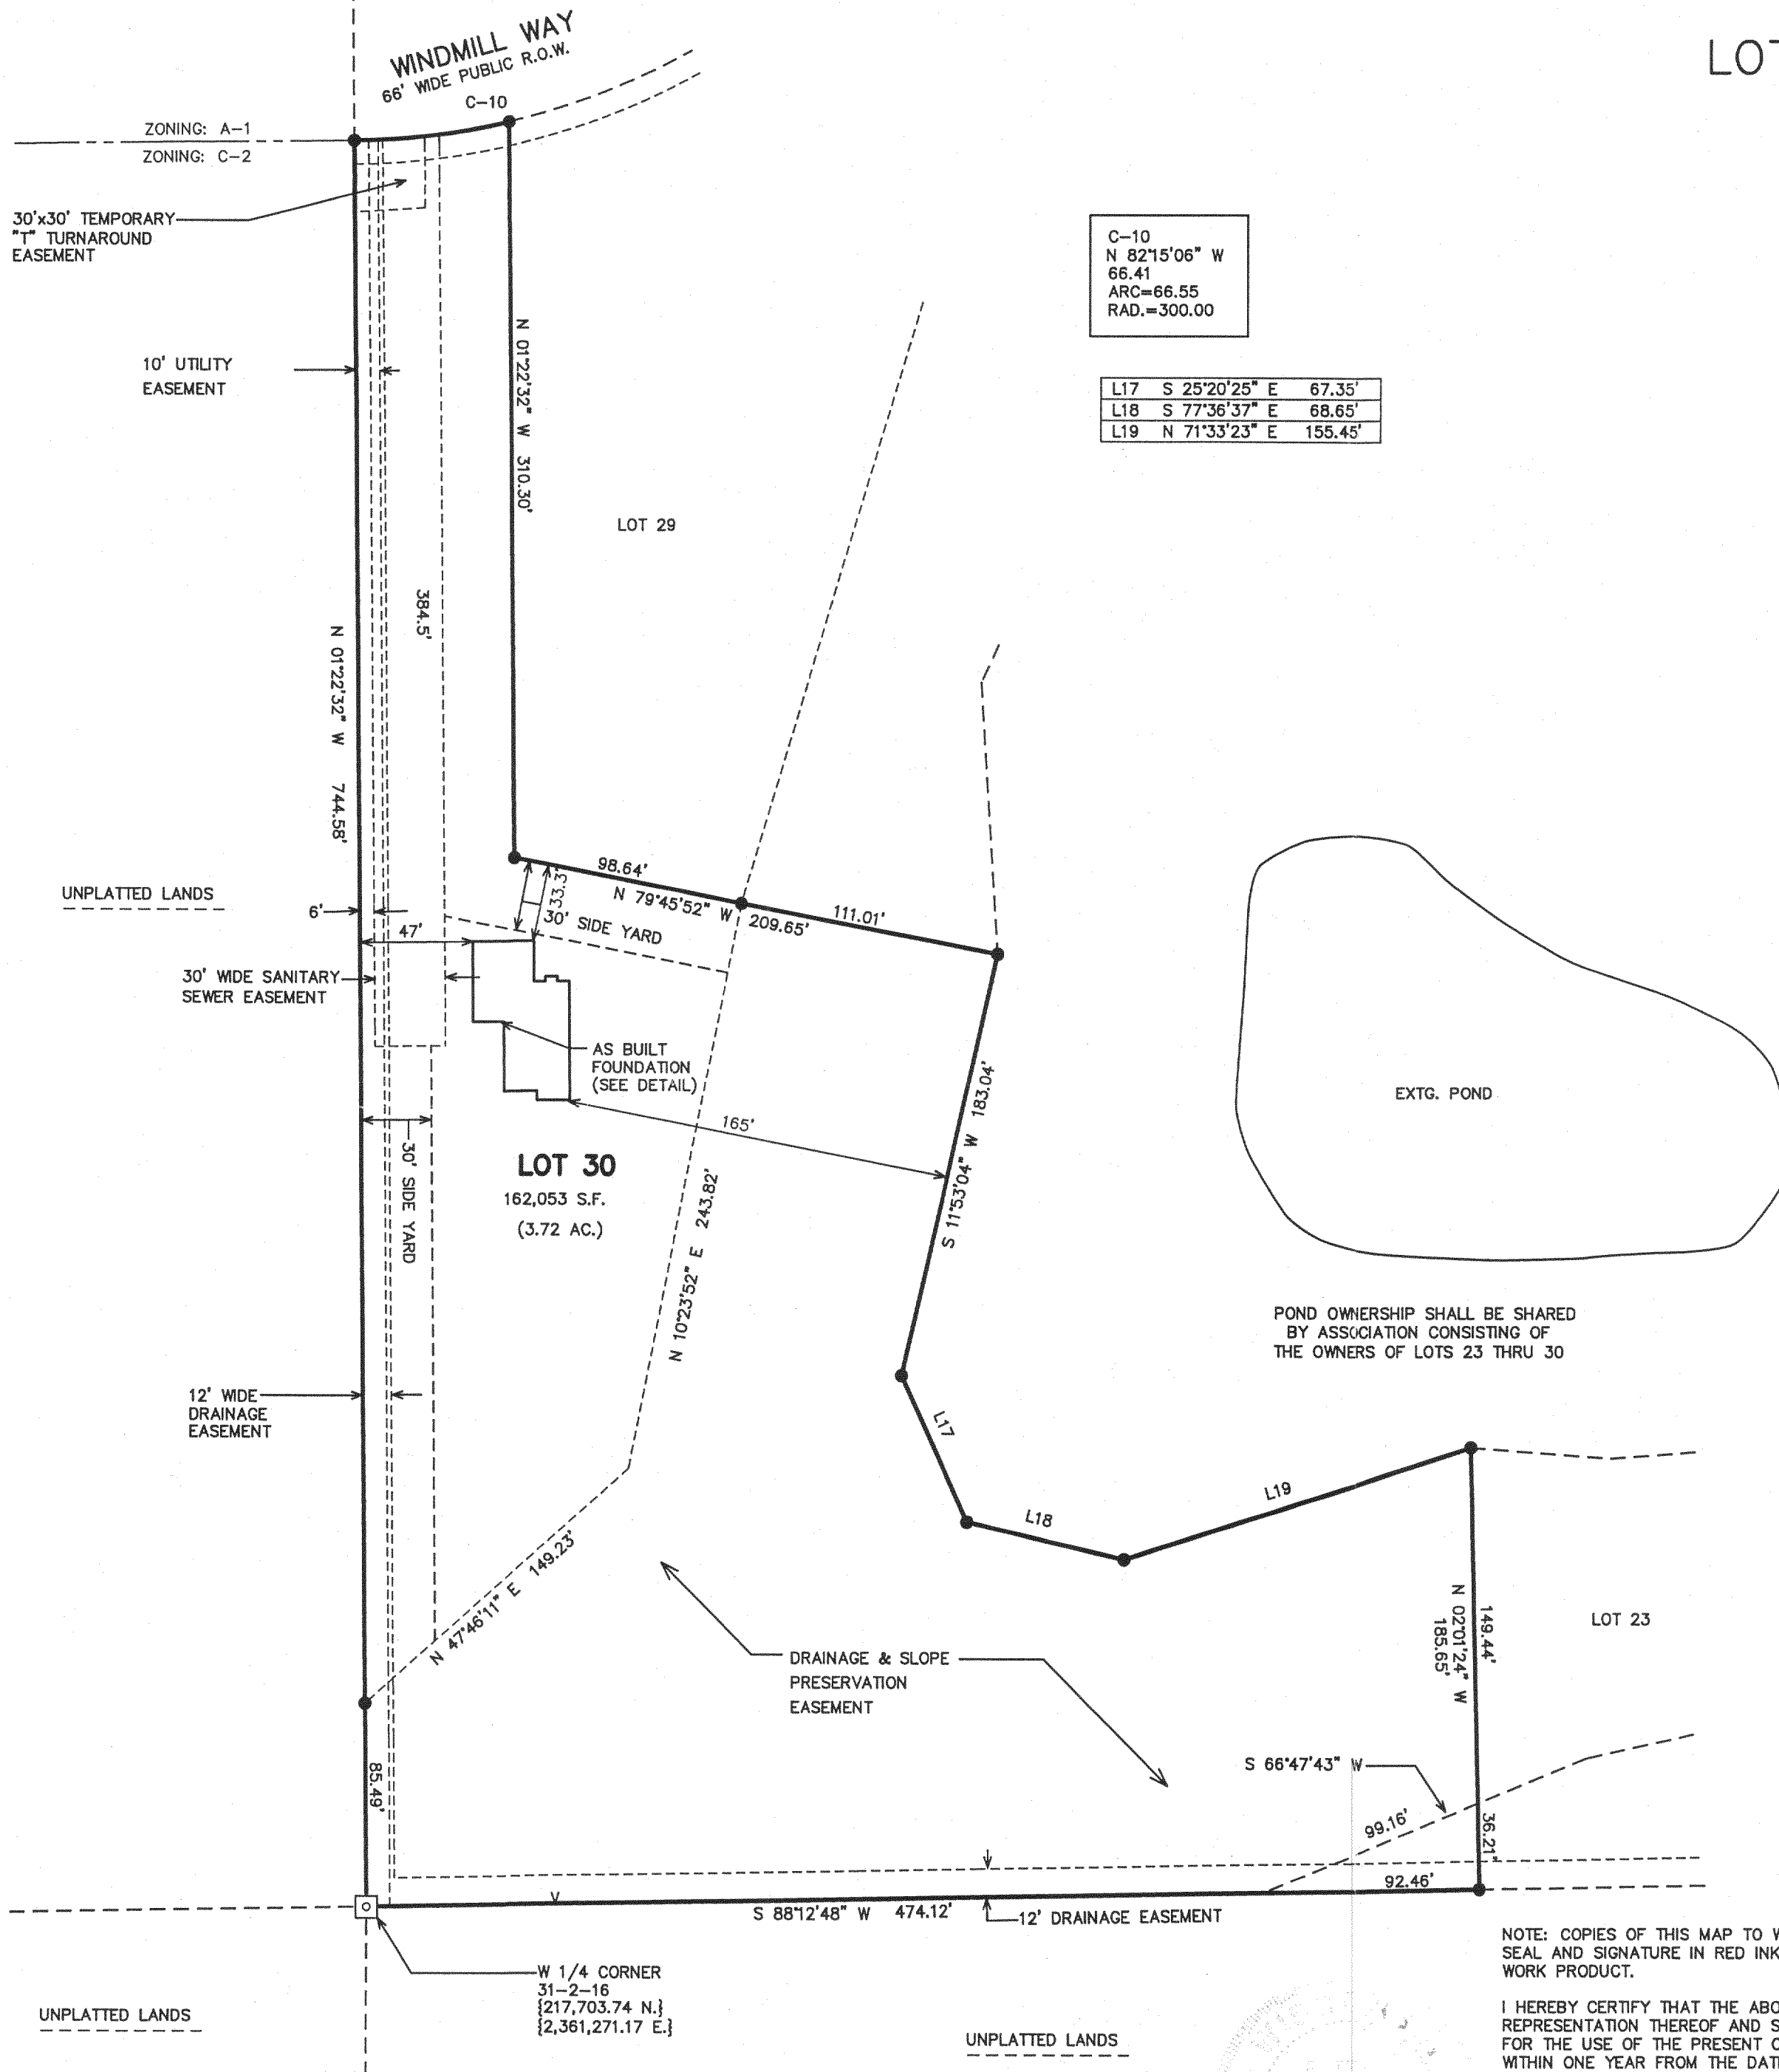


C-10
N 82°15'06" W
68.41
ARC=66.55
RAD.=300.00

L17 S 25°20'25" E 67.35'
L18 S 77°36'37" E 68.65'
L19 N 71°33'23" E 155.45'

- FOUND IRON REBAR STAKE
- SET IRON REBAR STAKE
RECORDED AS
- HYDRANT
- SANITARY MANHOLE

W. LINE OF THE NW 1/4 BEARS N 01° 32'42" W
NAD 1927 ADJ.

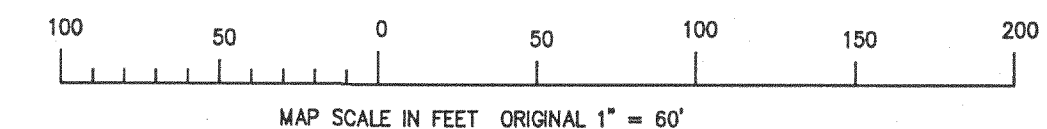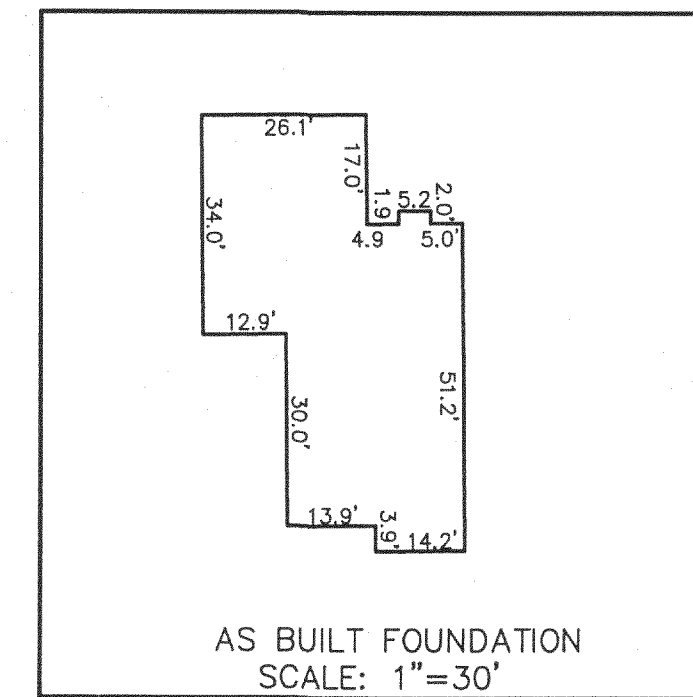


NOTE: COPIES OF THIS MAP TO WHICH THE FOLLOWING CERTIFICATE WILL APPLY SHOW SURVEYOR'S ORIGINAL SEAL AND SIGNATURE IN RED INK. COPIES BY ANY OTHER MEANS MAY HAVE ALTERATIONS WHICH DO NOT REPRESENT THE SURVEYOR'S WORK PRODUCT.

I HEREBY CERTIFY THAT THE ABOVE DESCRIBED PROPERTY HAS BEEN SURVEYED UNDER MY DIRECTION AND THAT THE ABOVE MAP IS A TRUE REPRESENTATION THEREOF AND SHOWS THE SIZE AND LOCATION OF THE PROPERTY AND ITS EXTERIOR BOUNDARIES. THIS SURVEY IS MADE FOR THE USE OF THE PRESENT OWNERS OF THE PROPERTY, AND ALSO THOSE WHO PURCHASE, MORTGAGE, OR GUARANTEE THE TITLE THERETO WITHIN ONE YEAR FROM THE DATE HEREOF.

DATED: APRIL 18, 2003

REVISED 08-03-2004
TO SHOW SIZE & LOCATION OF
AS BUILT FOUNDATION

PETER S. GORDON R.L.S. 2101

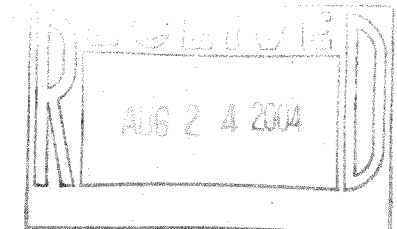

FDUT 00030

216-3825