


PLAT OF SURVEY

LOTS 13 AND 14 OF SAINT MARY'S OF DELAVAN LAKE, A SUBDIVISION
LOCATED IN SECTION 28, TOWN 2 NORTH, RANGE 16 EAST, WALWORTH
COUNTY, WISCONSIN.

ORDERED BY: HOME DESIGN MFG. CORP.
N2002 HWY 67
FONTANA, WI 53125

OWNER: DIANE K. STAVROS TRUST

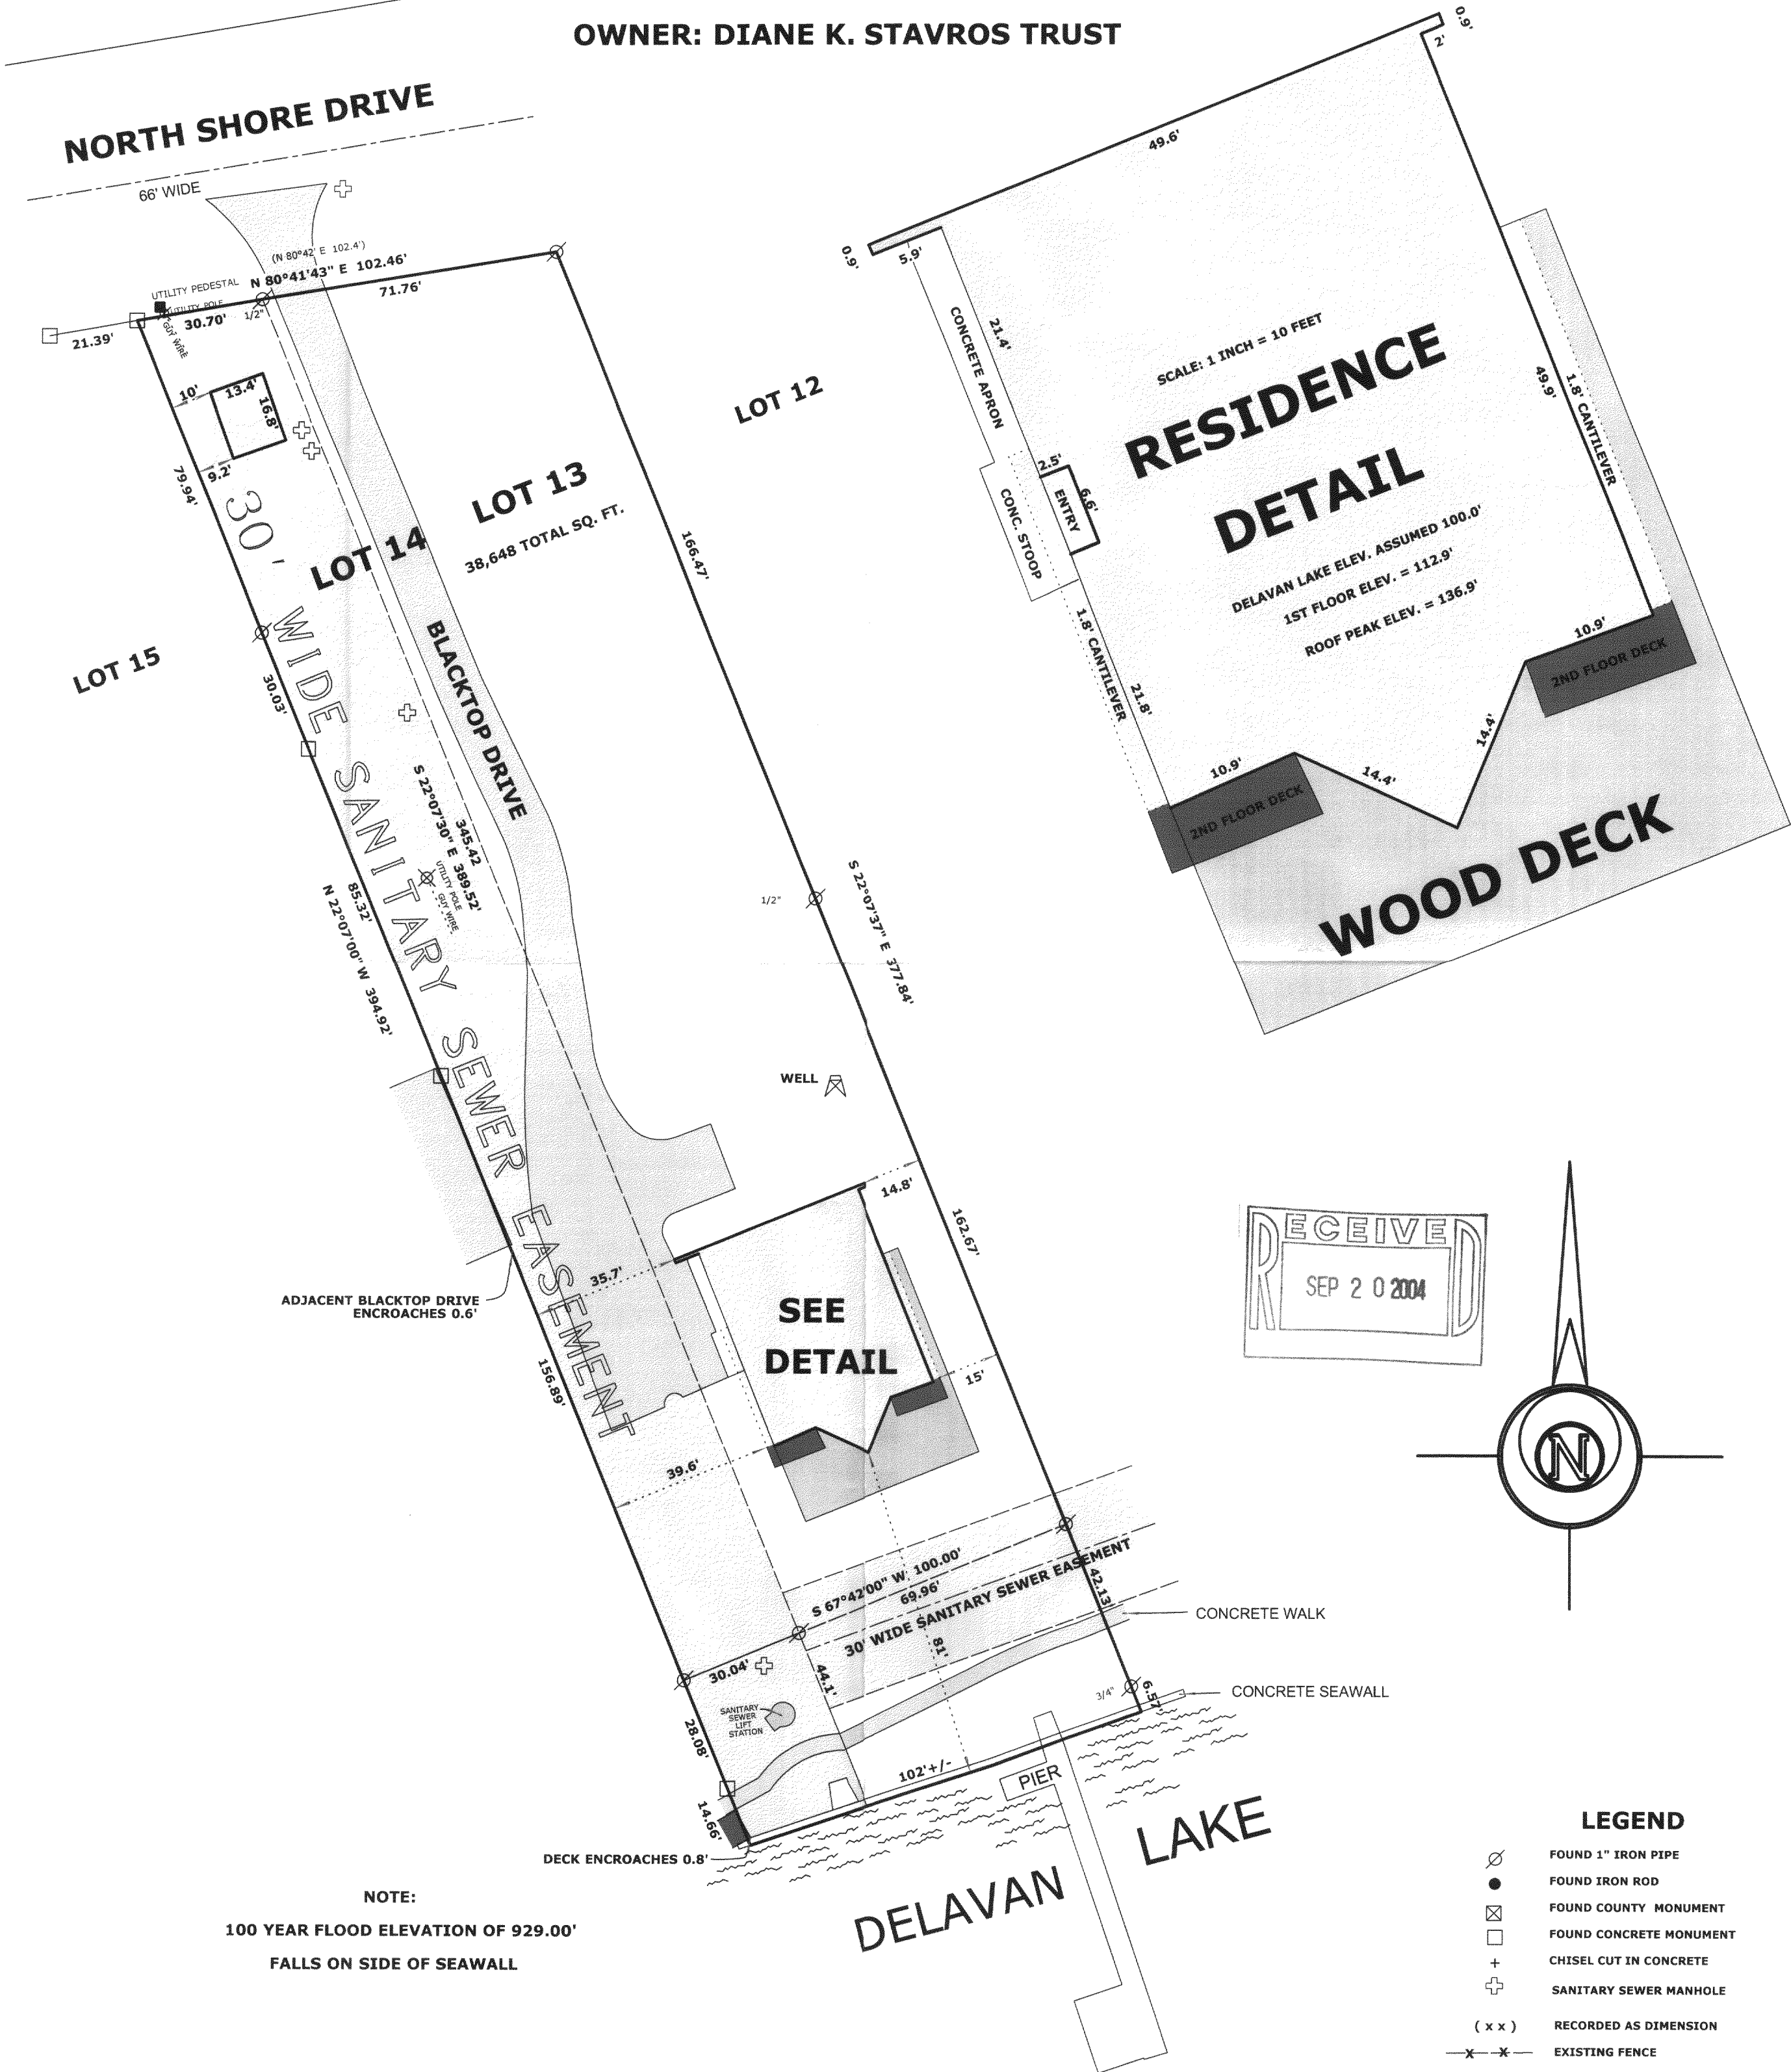

LEGEND

- FOUND 1" IRON PIPE
- FOUND IRON ROD
- FOUND COUNTY MONUMENT
- FOUND CONCRETE MONUMENT
- CHISEL CUT IN CONCRETE
- SANITARY SEWER MANHOLE
- RECORDED AS DIMENSION
- EXISTING FENCE

SCALE: 1" = 30 FEET

"I hereby certify that the above described property has been surveyed by me or under my direction and that the above map is a true representation thereof and shows the size and location of the property, its exterior boundaries, the location of all visible structures and dimensions of all principal buildings thereon, boundary fences, apparent easements, roadways and visible encroachments, if any." "This survey is made for the use of the present owners of the property, and also those who purchase, mortgage, or guarantee the title thereto within one year from date hereof."

Mark L. Miritz
MARK L. MIRITZ
WISCONSIN REGISTERED
LAND SURVEYOR S-2582

REVISED AUGUST 25, 2004

DATE: AUGUST 20, 2004 JOB NO. 04.805