

LAND-MARK SURVEYING
Mark L. Miritz

Wisconsin Registered Land Surveyor S-2582



N9330 Knuteson Drive
Whitewater, WI 53190
Phone: (262) 495-3284
FAX : (262) 495-8421
LAND-MARKSURVEYING.COM

PLAT OF SURVEY

LOT 2 OF BLOCK 1, SOUTH SHORE MANOR,
LOCATED IN SECTION 32 TOWN 2 NORTH,
RANGE 16 EAST, WALWORTH COUNTY,
WISCONSIN.

OWNER: DANIEL R. VOORHEES
2300 LAKE SHORE DR.
DELAVER, WI. 53115

BUYER: ANN BARNARD

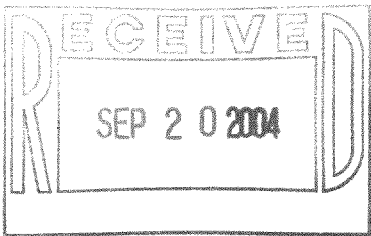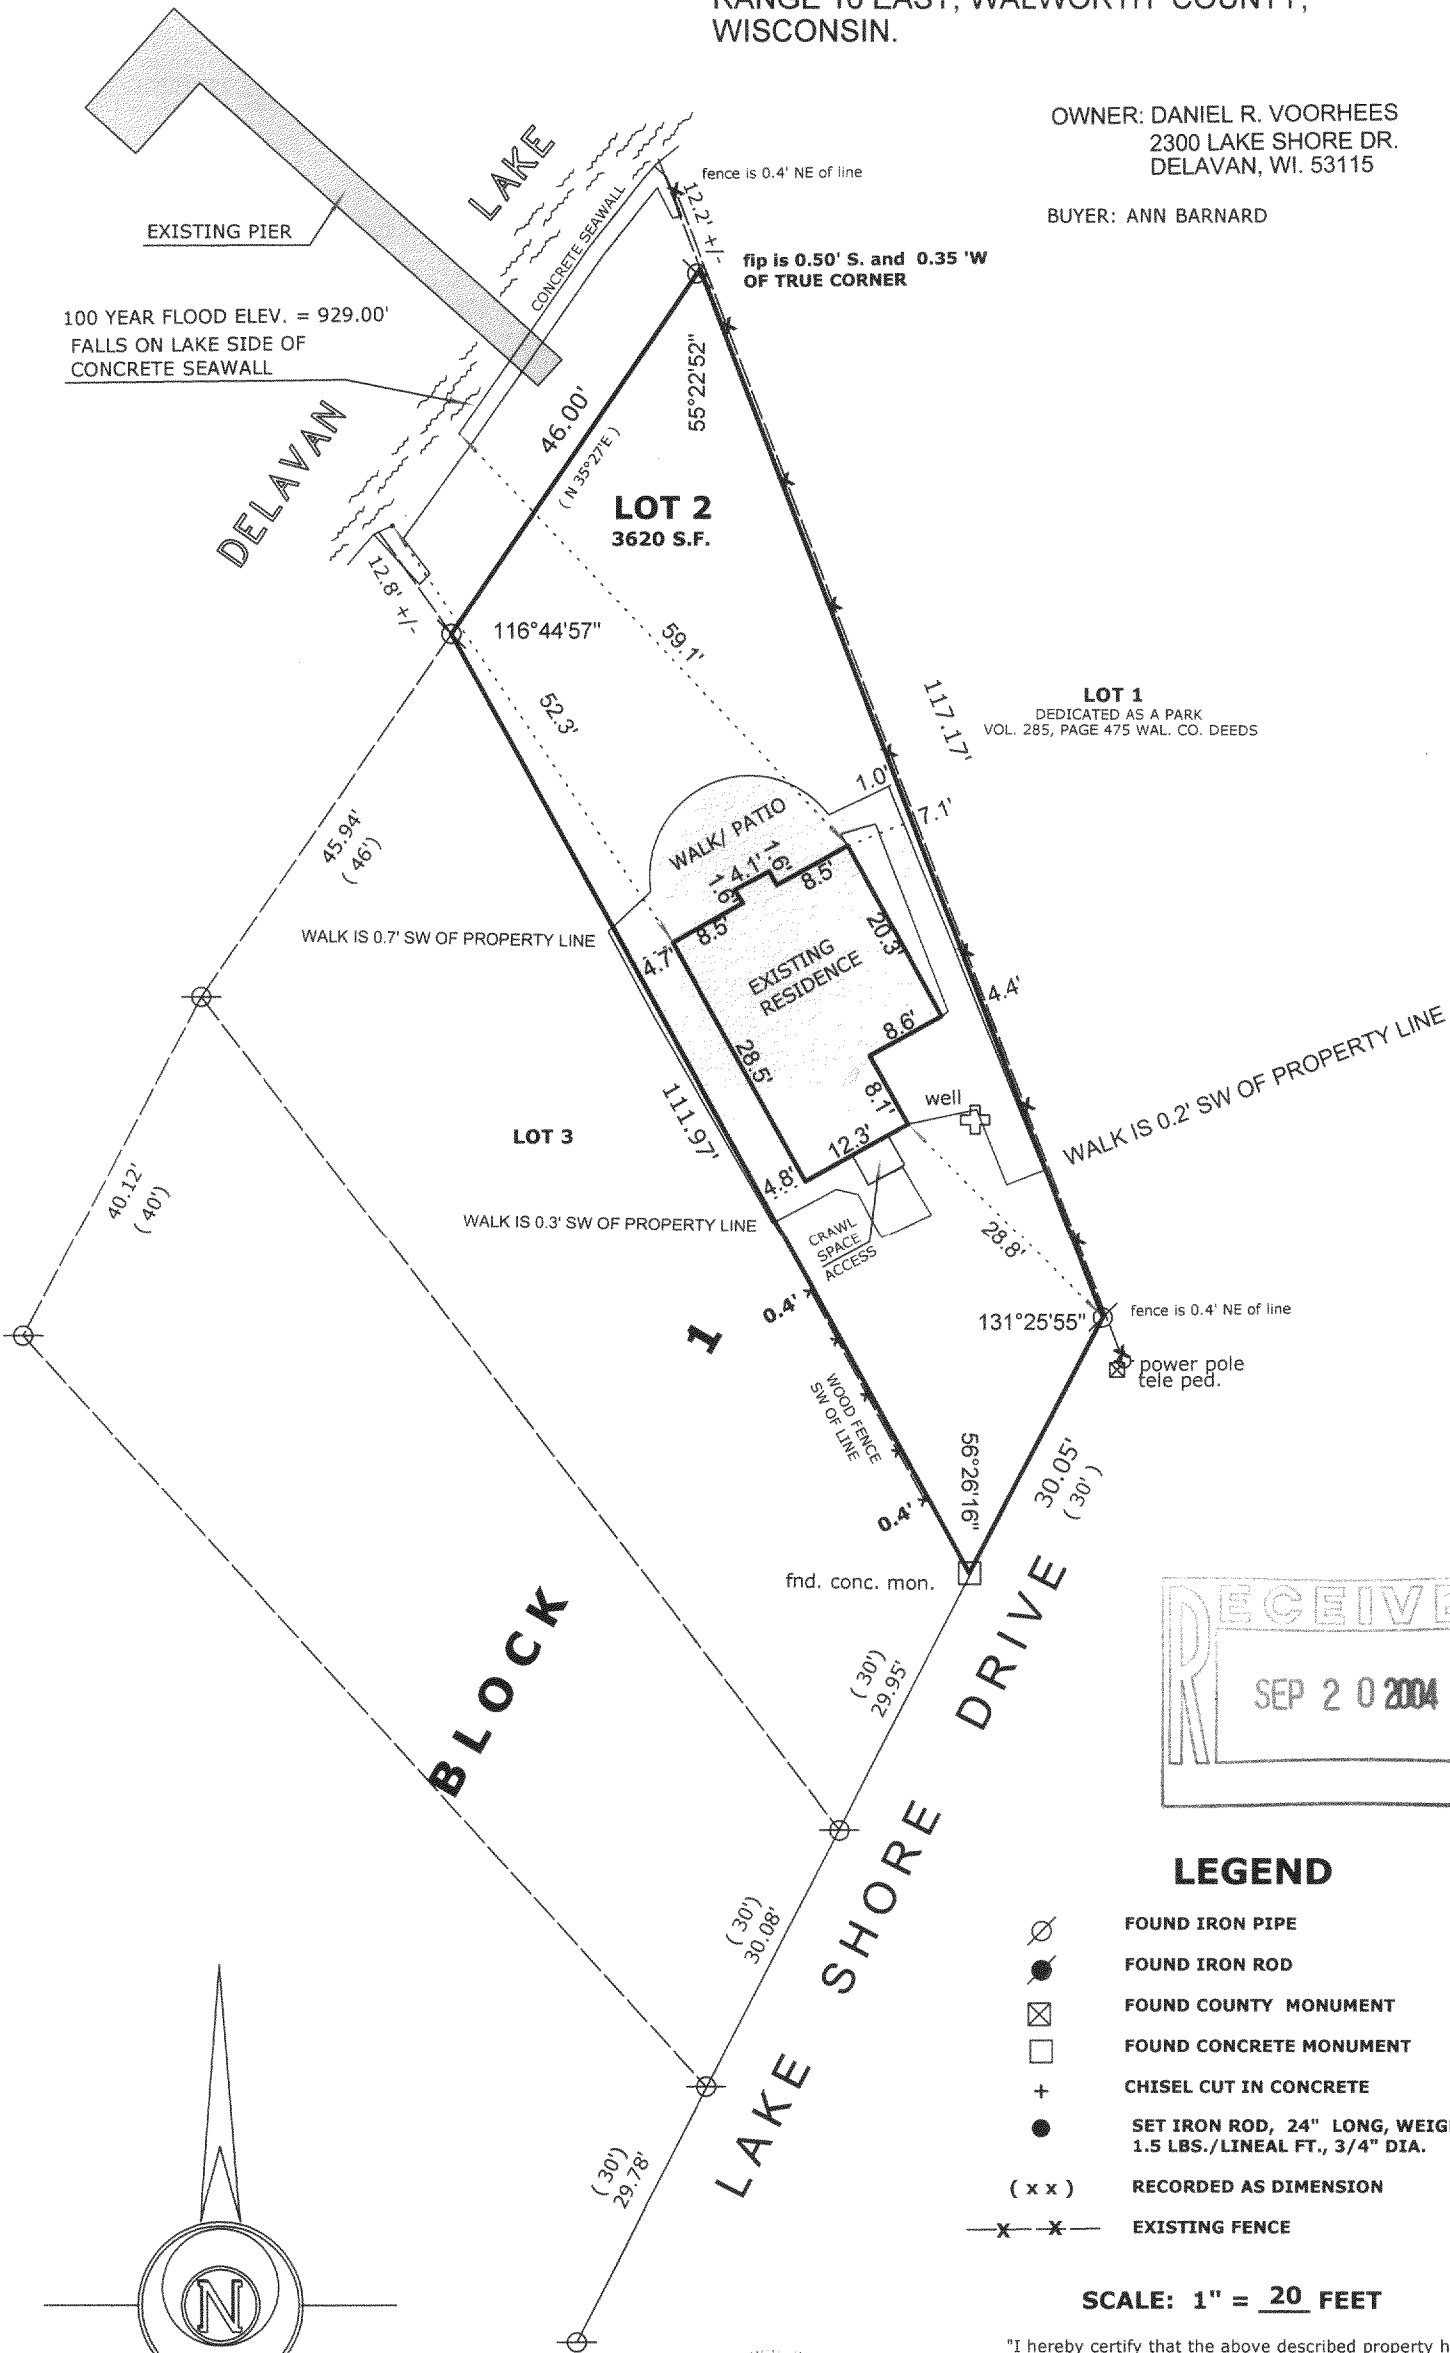

"I hereby certify that the above described property has been surveyed by me or under my direction and that the above map is a true representation thereof and shows the size and location of the property, its exterior boundaries, the location of all visible structures and dimensions of all principal buildings thereon, boundary fences, apparent easements, roadways and visible encroachments, if any."

"This survey is made for the use of the present owners of the property, and also those who purchase, mortgage, or guarantee the title thereto within one year from date hereof."

Mark L. Miritz
MARK L. MIRITZ
WISCONSIN REGISTERED
LAND SURVEYOR S-2582

DATE: Sept. 2, 2004 JOB NO. 04.816

FSS 00002

216-3829