


GEORGE T. DUNHAM
SURVEYING & SUBDIVIDING
DELAVER, WISCONSIN

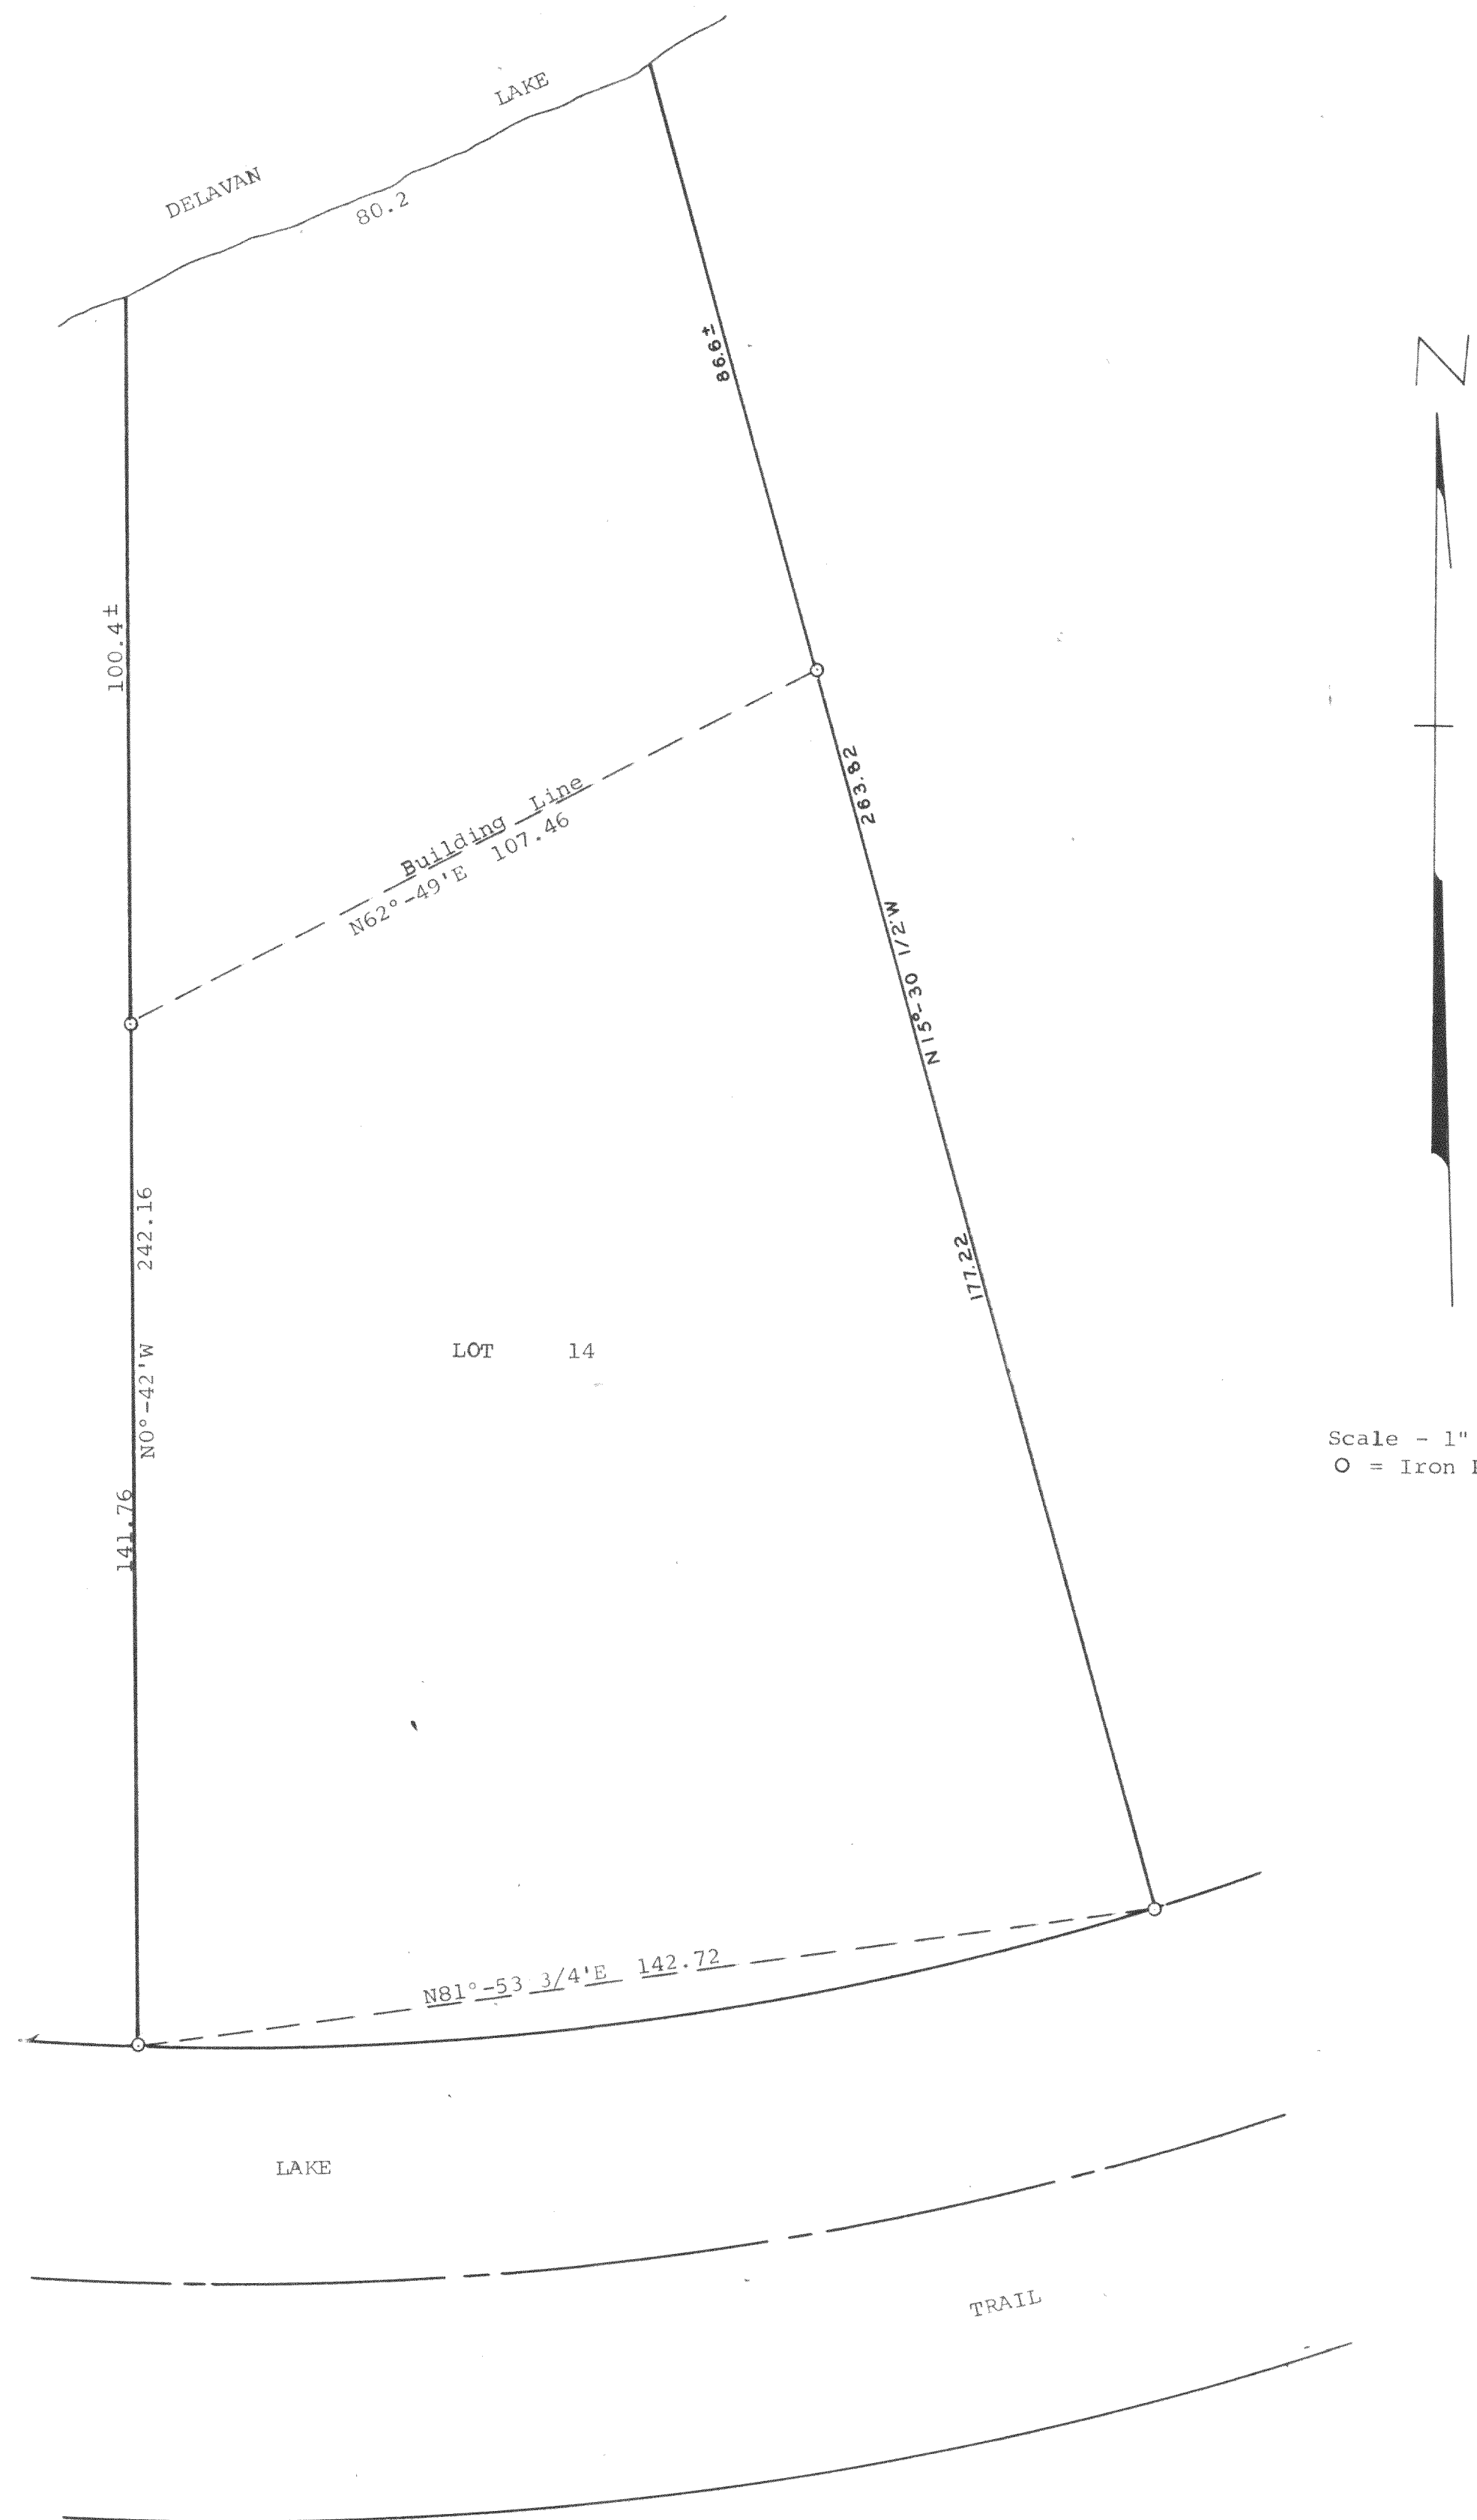

Plat of survey of Lot 14 in Lakewood Estates, a subdivision
located in Section 21, T 2 N, R 16 E, Walworth County, Wisconsin.
September 24, 1970

George T. Dunham
George T. Dunham, Surveyor