

LAND-MARK SURVEYING

Mark L. Miritz

Wisconsin Registered Land Surveyor S-2582

N9330 Knuteson Drive
Whitewater, WI 53190
Phone: (262) 495-3284
FAX: (262) 495-8421



LAND-MARKSURVEYING.COM

PLAT OF SURVEY

**LOTS 17 - 20 BLOCK 5, SOUTH SHORE MANOR
LOCATED IN T2N, R16E, WALWORTH COUNTY,
WISCONSIN.**

ORDERED BY: **SCHAUDER BUILDING, INC.**
4115 NORTH U.S. HIGHWAY 51
JANESVILLE, WI 53545-9674

Owner: Patricia Clifford

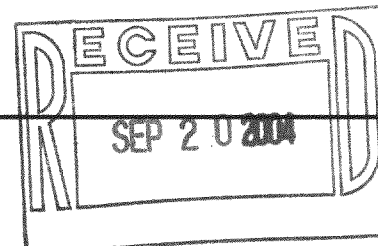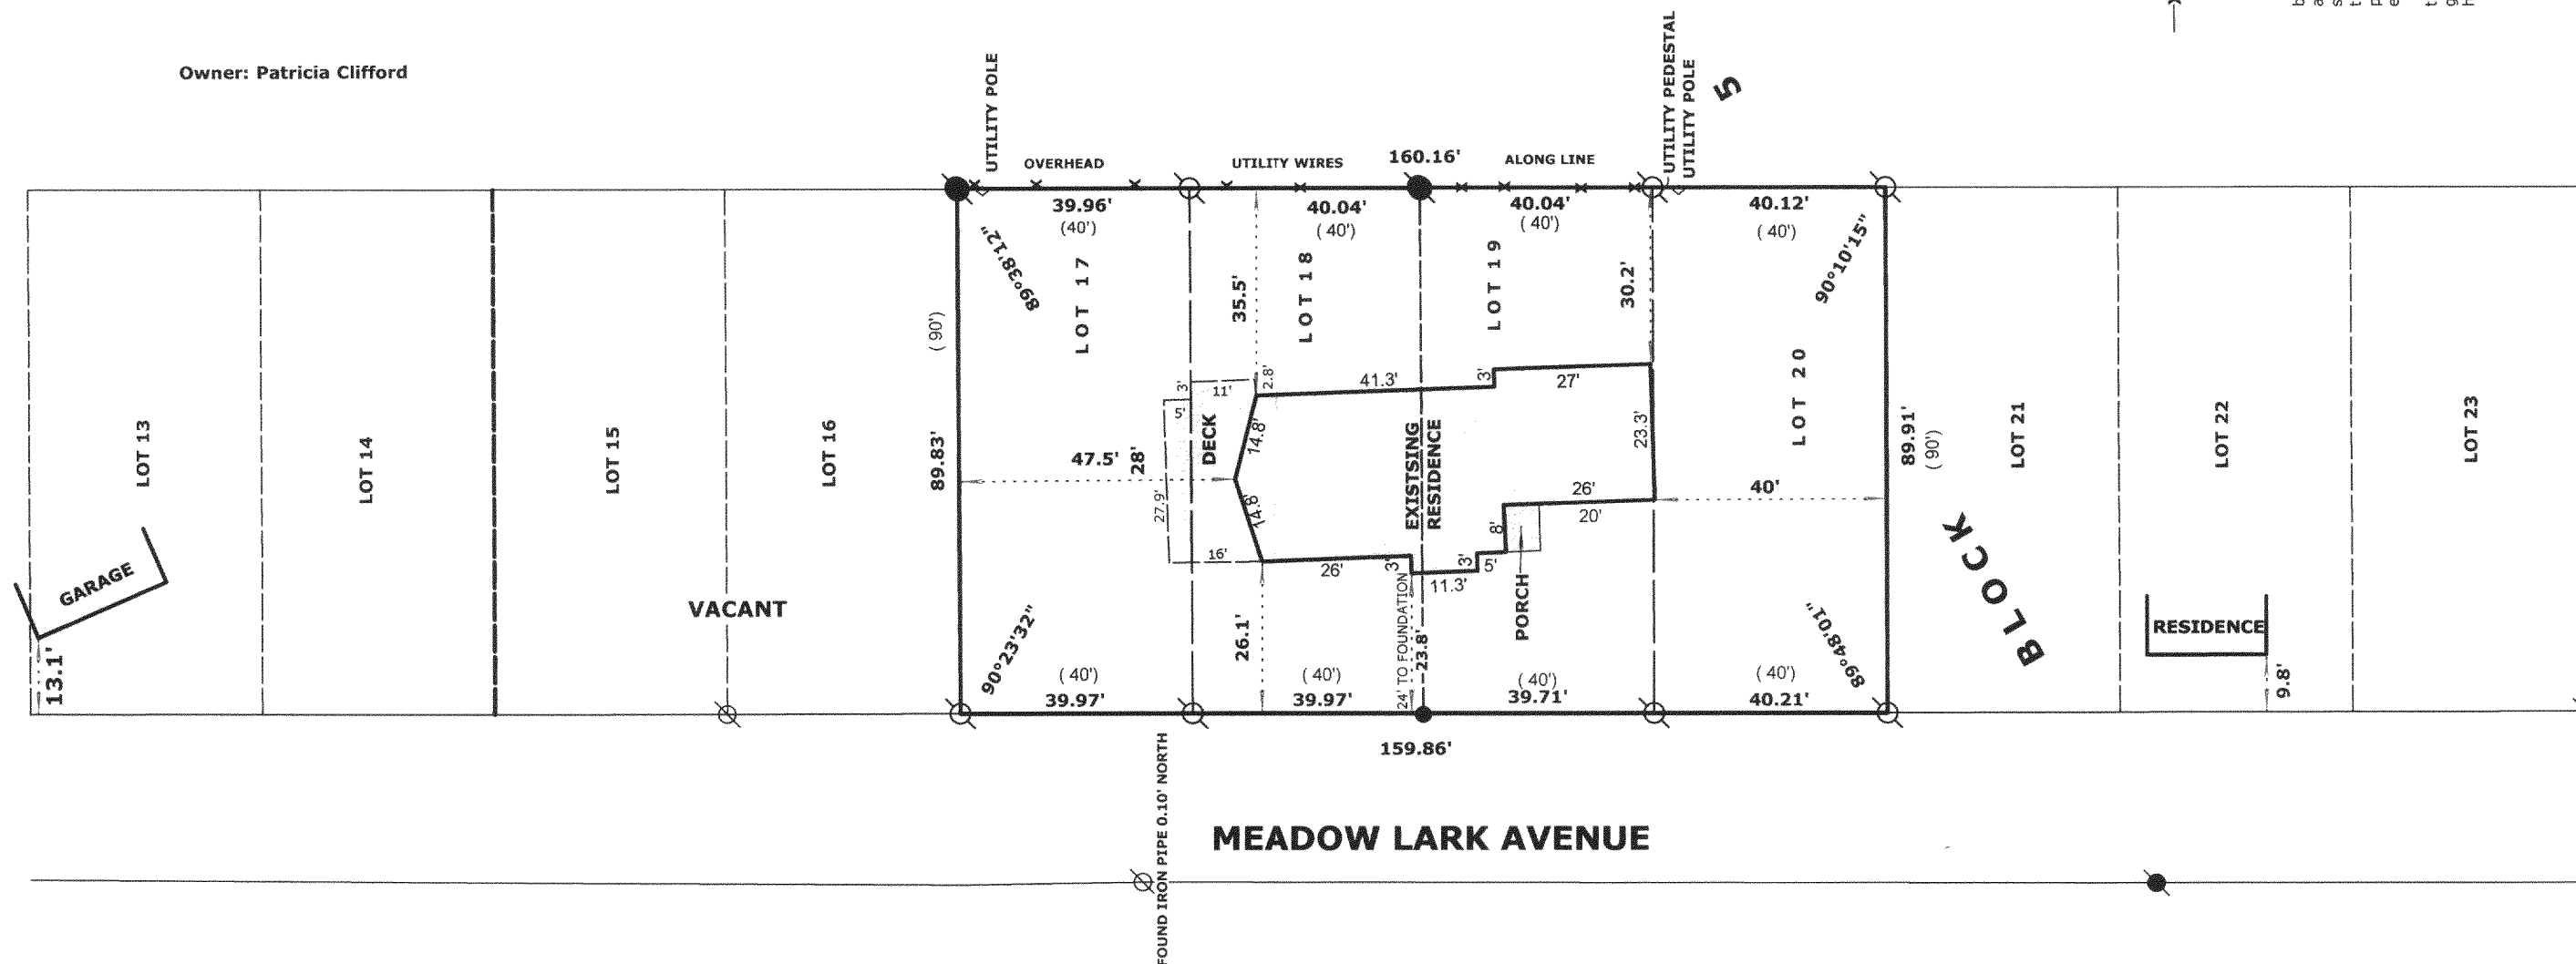

LEGEND

- FOUND IRON PIPE
- FOUND IRON ROD
- FOUND COUNTY MONUMENT
- FOUND CONCRETE MONUMENT
- CHISEL CUT IN CONCRETE
- SET IRON ROD, 24" LONG, WEIGHING 1.5 LBS./LINEAL FT., 3/4" DIA.
- RECORDED AS DIMENSION
- EXISTING FENCE

SCALE: 1" = 30 FEET

"I hereby certify that the above described property has been surveyed by me or under my direction and that the above map is a true representation thereof and shows the size and location of the property, its exterior boundaries, the location of all visible structures and dimensions of all principal buildings thereon, boundary fences, apparent easements, roadways and visible encroachments, if any."

Mark L. Miritz
MARK L. MIRITZ
WISCONSIN REGISTERED
LAND SURVEYOR S-2582

DATE: AUGUST 9, 2004 JOB NO. 04.106

REVISED AUGUST 29, 2004

FSS 00075

216-3830