


ABELL
SURVEYING & MAPPING

1140 SEQUOIA STREET • DELAVAN, WISCONSIN 53115

262-728-6737

300.00' THE S 1/2 OF THE SE 1/4 OF SEC. 6, T2N, R16E

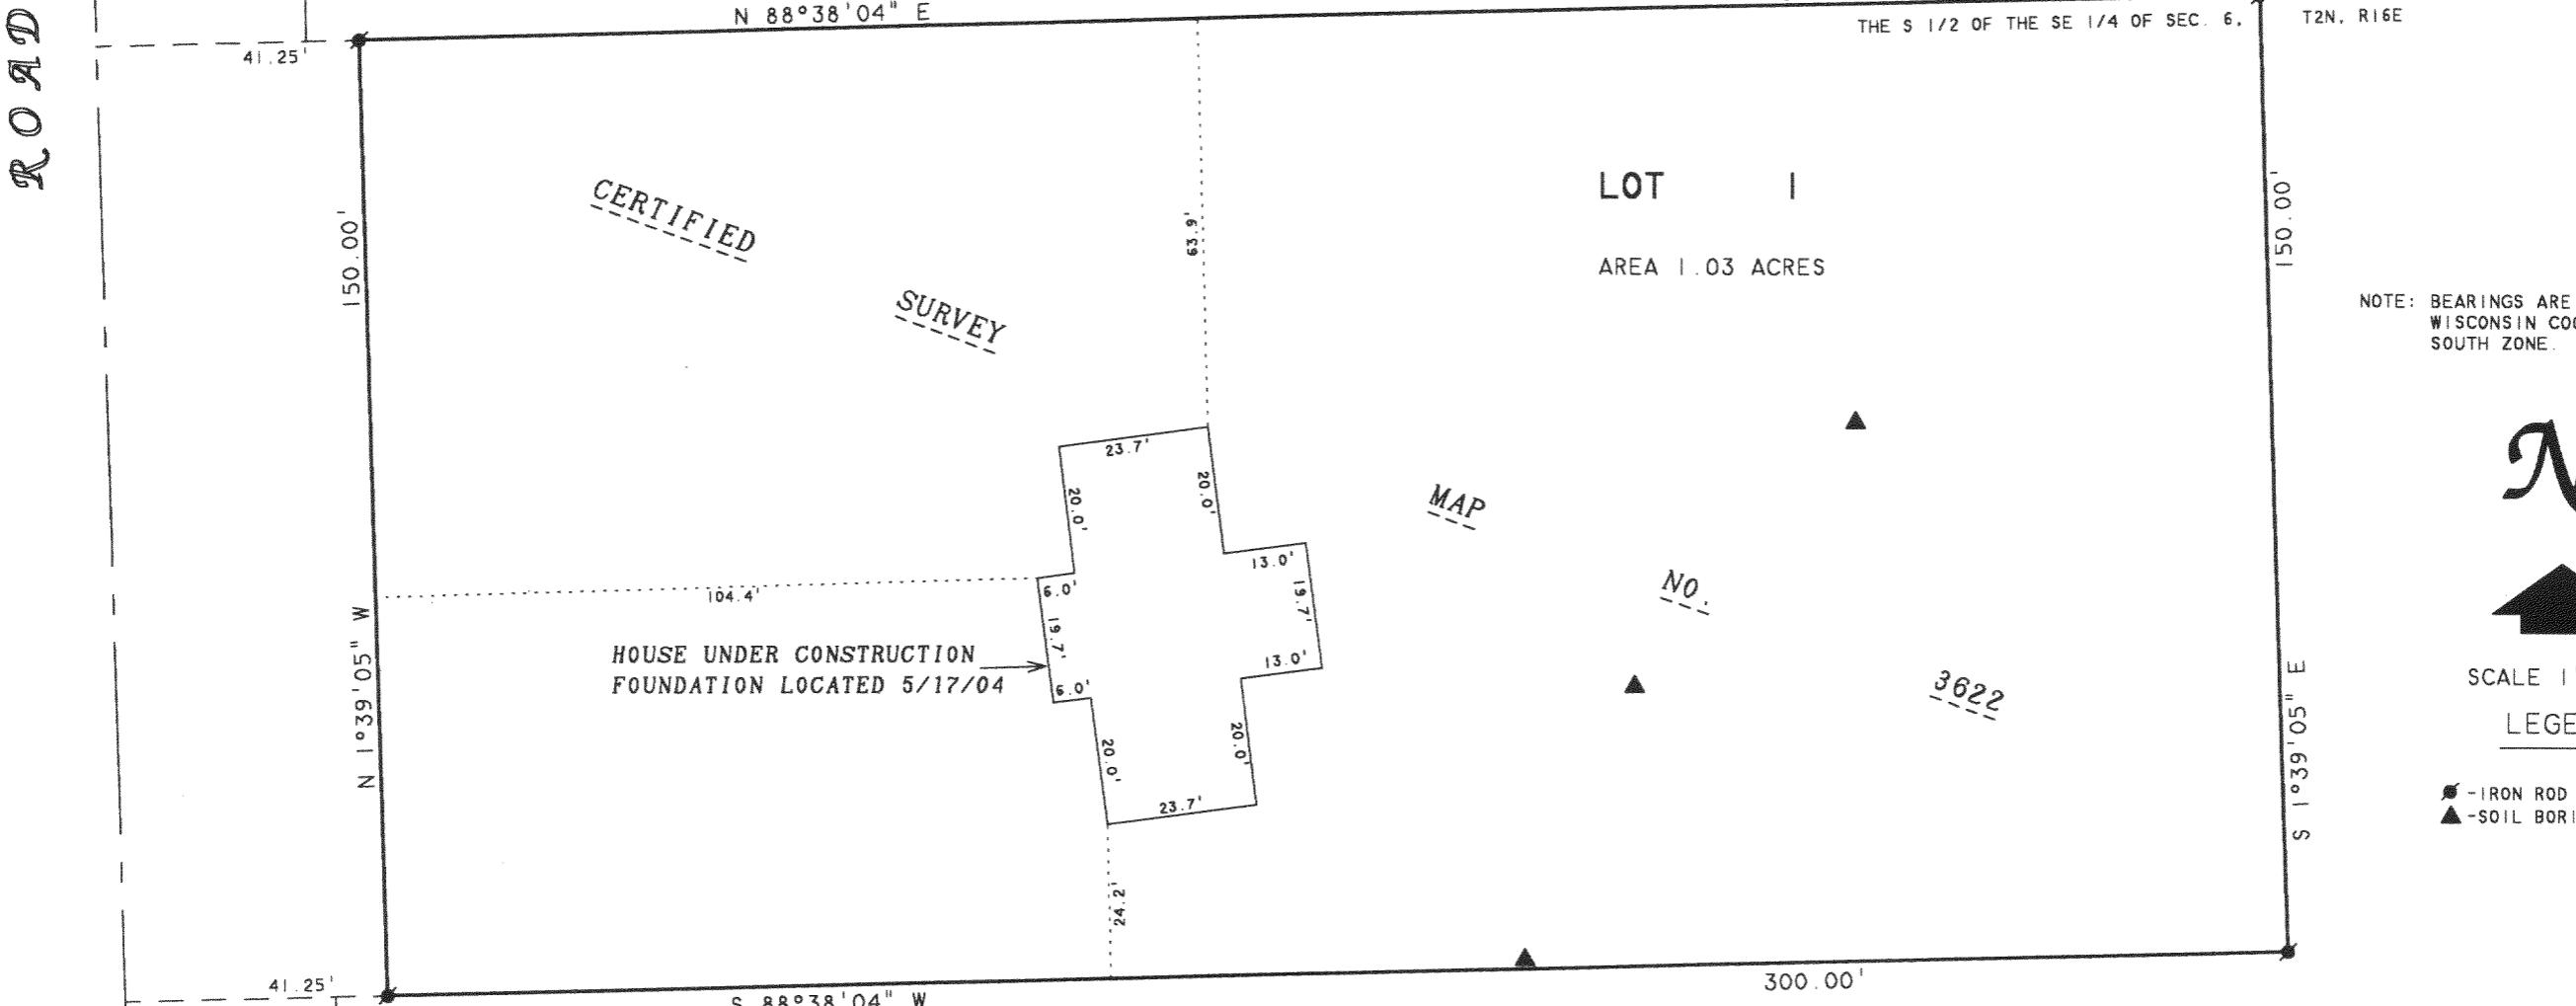

NOTE: BEARINGS ARE REFERENCED TO THE WISCONSIN COORDINATE SYSTEM - SOUTH ZONE.



SCALE 1" = 30'

LEGEND

- - IRON ROD FOUND
- ▲ - SOIL BORING

I HEREBY CERTIFY THAT I HAVE SURVEYED THE ABOVE DESCRIBED PROPERTY AND THAT THE ABOVE MAP IS A TRUE REPRESENTATION THEREOF AND SHOWS THE SIZE AND LOCATION OF THE PROPERTY, ITS EXTERIOR BOUNDARIES, THE LOCATION OF ALL VISIBLE STRUCTURES AND DIMENSIONS OF ALL PRINCIPAL BUILDINGS THEREON, BOUNDARY FENCES, APPARENT EASEMENTS, ROADWAYS AND VISIBLE ENCROACHMENTS, IF ANY, TO THE BEST OF MY KNOWLEDGE AND BELIEF.

THIS SURVEY IS MADE FOR THE USE OF THE PRESENT OWNERS OF THE PROPERTY, AND ALSO THOSE WHO PURCHASE, MORTGAGE, OR GUARANTEE THE TITLE THERETO WITHIN ONE (1) YEAR FROM DATE HEREON.

David F. Abell

DAVID F. ABELL
WISCONSIN REGISTERED LAND SURVEYOR, S-1596


PLAT OF SURVEY OF

LOT 1, CERTIFIED SURVEY MAP NO. 3622, LOCATED
IN THE SOUTHWEST 1/4 OF THE SOUTHEAST 1/4 OF
SECTION 6, T2N, R16E, WALWORTH COUNTY, WISCONSIN.

ORDERED BY: MICHAEL J. PALENSKE
1103 COTTONWOOD STREET
DELAVAN, WI 53115

REVISED: APRIL 6, 2004 TO SHOW
THE PROPOSED DECK.

REVISED: MAY 17, 2004 TO SHOW
THE CONCRETE FOUNDATION OF THE
HOUSE UNDER CONSTRUCTION.

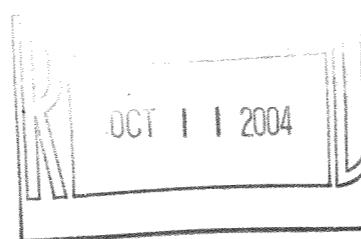

March 2, 2004
DATE
NOTE: THIS IS NOT A CERTIFIED COPY UNLESS SEALED.

JOB NUMBER - 03013D

ROAD

33'

1005.04'
N 1°39'05" W
33'
1005.04'

SOUTH 1/4 CORNER
SECTION 6-2-16

ROAD

33'

41.25'

CENTER OF SECTION
6-2-16

N 88°38'04" E

262-728-6737

300.00'

T2N, R16E

LOT 1

AREA 1.03 ACRES

LEGEND

- - IRON ROD FOUND
- ▲ - SOIL BORING

FA36220001

216-3853