


ABELL
SURVEYING & MAPPING

1140 SEQUOIA STREET • DELAVAN, WISCONSIN 53115
262-728-6737

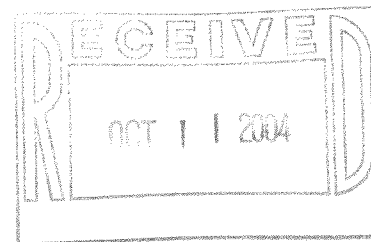

MOUND ROAD

(TOWN ROAD)

6' 1" 6'

(EAST 107.25')
S 89°59'43" E 107.20'

LOT 8

LOT 9
0.92 ACRES

LOT 10

NOTE: BEARINGS ARE REFERENCED TO THE
RECORDED SUBDIVISION PLAT.



SCALE 1"=40'

LEGEND

- - IRON PIPE FOUND
- - IRON ROD FOUND
- △ - UTILITY POLE
- - OVERHEAD UTILITY LINES
- - GUYWIRE
- - UTILITY PEDS
- x— - WIRE FENCE
- () - RECORDED AS

SHARED
WELL
○ SHARED WELL AGREEMENT AS
RECORDED IN VOL. 480 OF DEEDS
ON PAGE 566 AS DOC. NO. 469711

PLAT OF SURVEY OF

LOT 9 OF ELKWOOD, A SUBDIVISION LOCATED
IN THE NORTHEAST 1/4 OF THE NORTHEAST 1/4
OF SECTION 13, T2N,R16E, WALWORTH COUNTY,
WISCONSIN.

FENCE CORNER 1.6'
WEST OF LINE

END OF FENCE 0.3'
WEST OF LINE

N 89°57'13" W 107.23'
(WEST 107.25')

LOT 19

I HEREBY CERTIFY THAT I HAVE SURVEYED THE ABOVE DESCRIBED PROPERTY AND THAT THE
ABOVE MAP IS A TRUE REPRESENTATION THEREOF AND SHOWS THE SIZE AND LOCATION OF
THE PROPERTY, ITS EXTERIOR BOUNDARIES, THE LOCATION OF ALL VISIBLE STRUCTURES
AND DIMENSIONS OF ALL PRINCIPAL BUILDINGS THEREON, BOUNDARY FENCES, APPARENT
EASEMENTS, ROADWAYS AND VISIBLE ENCROACHMENTS, IF ANY, TO THE BEST OF MY
KNOWLEDGE AND BELIEF.

THIS SURVEY IS MADE FOR THE USE OF THE PRESENT OWNERS OF THE PROPERTY, AND ALSO
THOSE WHO PURCHASE, MORTGAGE, OR GUARANTEE THE TITLE THERETO WITHIN ONE (1) YEAR
FROM DATE HEREON.

David F. Abell

DAVID F. ABELL
WISCONSIN REGISTERED LAND SURVEYOR, S-1596

ORDERED BY: THE RAULAND AGENCY
P.O. BOX 159
WALWORTH, WI. 53184

July 28, 2004

DATE JOB NUMBER - 04091
NOTE: THIS IS NOT A CERTIFIED COPY UNLESS SEALED.

FEW 00089

216-3871