


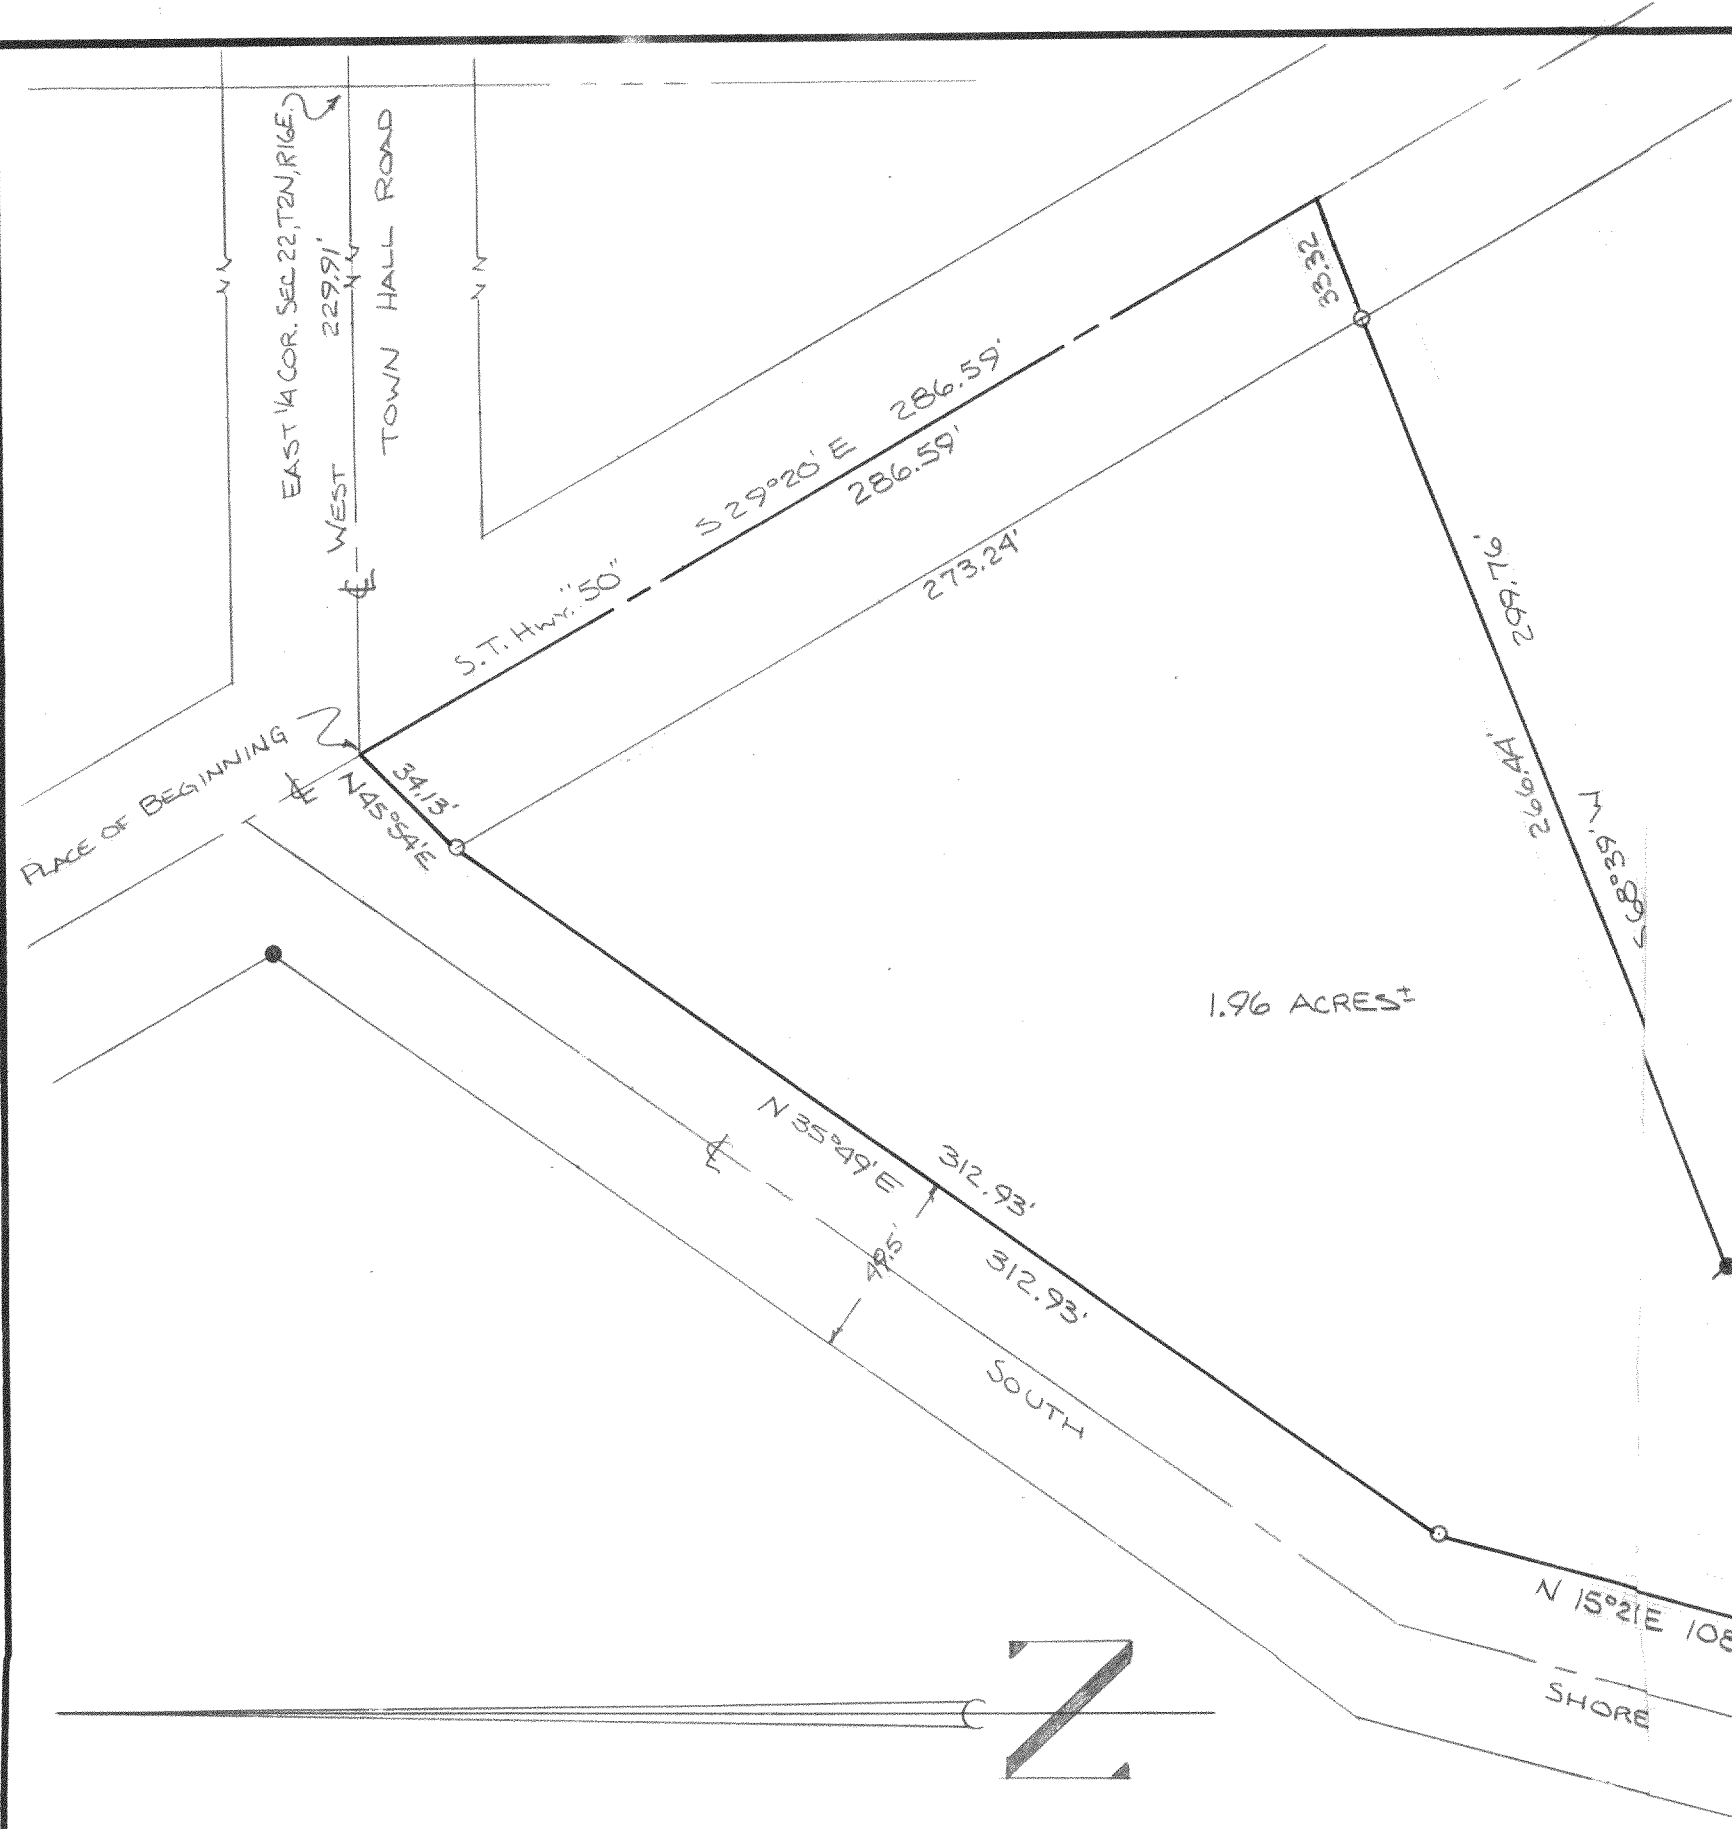

DESCRIPTION:

Commencing at the point of intersection of the East and West centerline of Section 22, Town 2 North Range 16 East, Walworth County, Wisconsin, and the centerline of the public road known as the Delavan and Lake Geneva Road (State Trunk Highway #50), thence S. 29°-20'E, along the centerline of said highway 286.59 feet to a point, thence S. 68°-39'W., 299.76 feet to an iron rod, thence S. 00°-11'W. 206.22 feet to an iron pipe, thence S. 89°-09'W., 100.00 feet to an iron pipe in the easterly line of South Shore Drive, thence N. 00°-11'W. 206.22 feet to an iron stake, thence S. 89° 09'W., 100.00 feet to an iron pipe in the easterly line of South Shore Drive, thence N. 00°-57'E., 184.45 feet to an iron pipe, thence N. 15°-21'E., 108.62 feet to an iron pipe, thence S. 15°-21'E., 108.62 feet to an iron pipe, thence N. 35°-49'E., 312.93 feet to an iron pipe, thence N. 45° 54'E., 34.13 feet to the place of beginning, Containing 1.96 acres more or less.

CERTIFICATE:

I, Joseph M. Biagi, Surveyor, hereby certify that I have on this the 18th day of April, 1974 surveyed the above described property.

Joseph M. Biagi RLS #12
Elkhorn, Wisconsin.

Signed and sealed this
18th day of April, 1974.

LEGEND:

- IRON PIPE FOUND
- ✱ IRON ROD FOUND
- IRON PIPE SET

REVISIONS			GEORGE VON SUESSMILCH EST.		
NO.	DATE	BY	SE 1/4 SEC. 22, T2N, R16E		
1			DRAWN BY GW	SCALE 1"=50'	MATERIAL
2				DATE	DRAWING NO.
3			CHK'D	APP'D	
4			TRACED		
5					

FD 22-5

D-22-5 216-38B 46-88-74