

Tax Parcel
FD 1300004

Plat of Survey


of

Lot 1 of Certified Survey Map No. 2562,

recorded in Vol. 13 of Certified Survey Maps of Walworth County on Page 29 and located in the Southeast 1/4 and the Southwest 1/4 of Section 13, Town 2 North, Range 16 East, Town of Delavan, Walworth County, Wisconsin.

Surveyed for: **The Rauland Agency, Inc.**
118 Kenosha Street * P.O. Box 159
Walworth, Wisconsin. 53184




Survey Date: January 13, 2005.
Revisions: No. 1 - Label R.O.W.

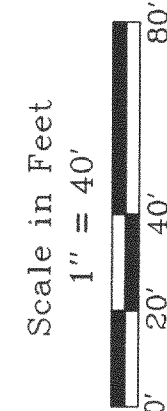

Jensen & Olson Land Surveying, LLC
45 South Wisconsin Street P.O. Box 322
Elkhorn, Wisconsin 53121
Telephone (262) 723-3434
Facsimile (262) 723-8044

Tax Parcel
FD 1300004

Tax Parcel
FD 1300004

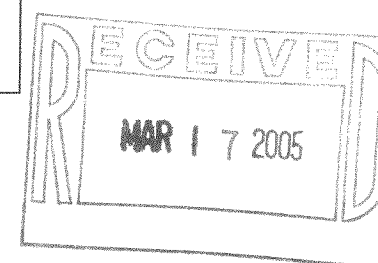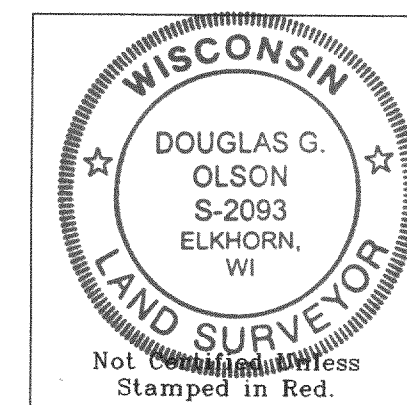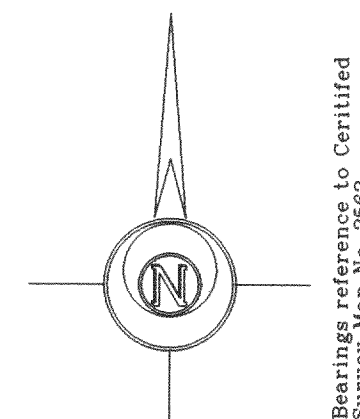

- Notes: 1) This survey plat is not certified unless signed and sealed in red ink.
2) This survey is subject to Wisconsin lien laws. This Plat of Survey is the notice of intent to file lien. Lien waiver required.

Copyright © 2005 by Jensen & Olson Land Surveying, LLC.

All rights reserved. No part of this survey plat may be reproduced or transmitted in any form by any means, graphic, electronic, or mechanical, including photocopying, tracing, or information storage and retrieval systems - without permission in writing from Douglas G. Olson, Jensen & Olson Land Surveying, LLC.

I hereby certify that I have surveyed the above described property and the map hereon is correct to the best of my professional knowledge and belief and shows the size and location of the property, its exterior boundaries, the location and dimensions of all visible structures thereon, boundary fences, apparent easements and roadways and visible encroachments, if any.
This survey is made for the exclusive use of the present owners of property, and also those who purchase, mortgage or guarantee title thereto, within one year from the date hereof.

Douglas G. Olson
Wisconsin Registered Land Surveyor - 2093

Legend
Found County Section Corner
Found Iron Pipe
Recorded Information
Utility Pole
Concrete Cover
Asphalt Surface
Concrete Surface
Gravel

Sheet 1 of 1 Sheets
Job Reference Number
2004.211

2004.211

216-3939

FA 2562 - 1