

Elevation 85' North of
this point, (on the South
edge of Willow Point Drive)
is 969.9

Plat of Survey

of

Lot 2 of Certified Survey Map No. 959,


recorded in Vol. 4 of Certified Survey Maps of Walworth County
on Page 213 and located in the Fractional Southeast 1/4 of
Section 29, Town 2 North, Range 16 East, Town of Delavan,
Walworth County, Wisconsin.

Surveyed for: **Jesse Butler**
3422 Park Place
Evanston, Illinois. 60201



Lot 1
C.S.M. 959

Lot 5
The Hamlet of
Bon Secour

Lot 1
C.S.M. 959

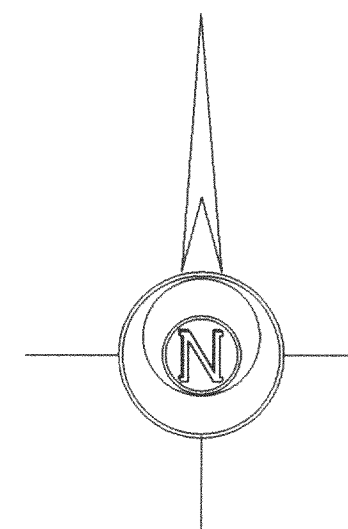

Bearings reference to Certified
Survey Map No. 959.

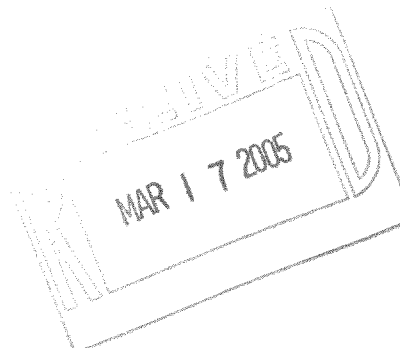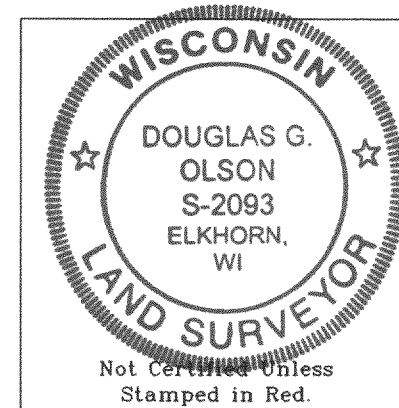

Notes: 1) This survey plat is not
certified unless signed
and sealed in red ink.

2) This survey is subject to Wisconsin lien laws.
This Plat of Survey is the notice of intent
to file lien. Lien waiver required.

Copyright c 2005 by Jensen & Olson Land Surveying, LLC.

All rights reserved. No part of this survey plat may be reproduced
or transmitted in any form by any means - graphic, electronic, or
mechanical, including photocopying, tracing, or information storage
and retrieval systems - without permission in writing from Douglas
G. Olson, Jensen & Olson Land Surveying, LLC.

I, Douglas G. Olson, Wisconsin Registered Land Surveyor,
do hereby certify that this survey was performed by me or under my
direction in full compliance with the owner's/agent's instructions
and Chapter A-E 7 of the Wisconsin Administrative Code "Minimum
Standards for Property Surveys"; and that this map is an accurate
representation thereof to the best of my knowledge and belief.

Douglas G. Olson
Wisconsin Registered Land Surveyor - 2093

Delavan Lake

Water elevation on
November 18, 2002 = 927.76.

Sheet 1 of 1 Sheets

Job Reference Number

2005.006

Legend

- Found Iron Pipe
- Found Iron Rod
- Found Cross Cut
- Recorded Information
- Manhole
- Spot Elevation
- Concrete Surface
- Deciduous Tree
- Asphalt Surface
- Coniferous Tree




Jensen & Olson Land Surveying, LLC

45 South Wisconsin Street P.O. Box 322
Elkhorn, Wisconsin. 53121
Telephone (262) 723-3434
Facsimile (262) 723-8044

Scale in Feet

1" = 20'

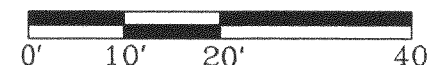

Survey Date: November 18, 2002.

Revisions: No. 1 - Proposed Addition
No. 2 - Addition as-built

FA 9590002

216-3942