


ABELL
SURVEYING & MAPPING

1140 SEQUOIA STREET • DELAVAN, WISCONSIN 53115
262-728-6737

REVISED AND RECERTIFIED: MARCH 11, 2005

ORDERED BY: RICHARD BROWN
3706 SOUTH SHORE DRIVE
DELAVAN, WI 53115

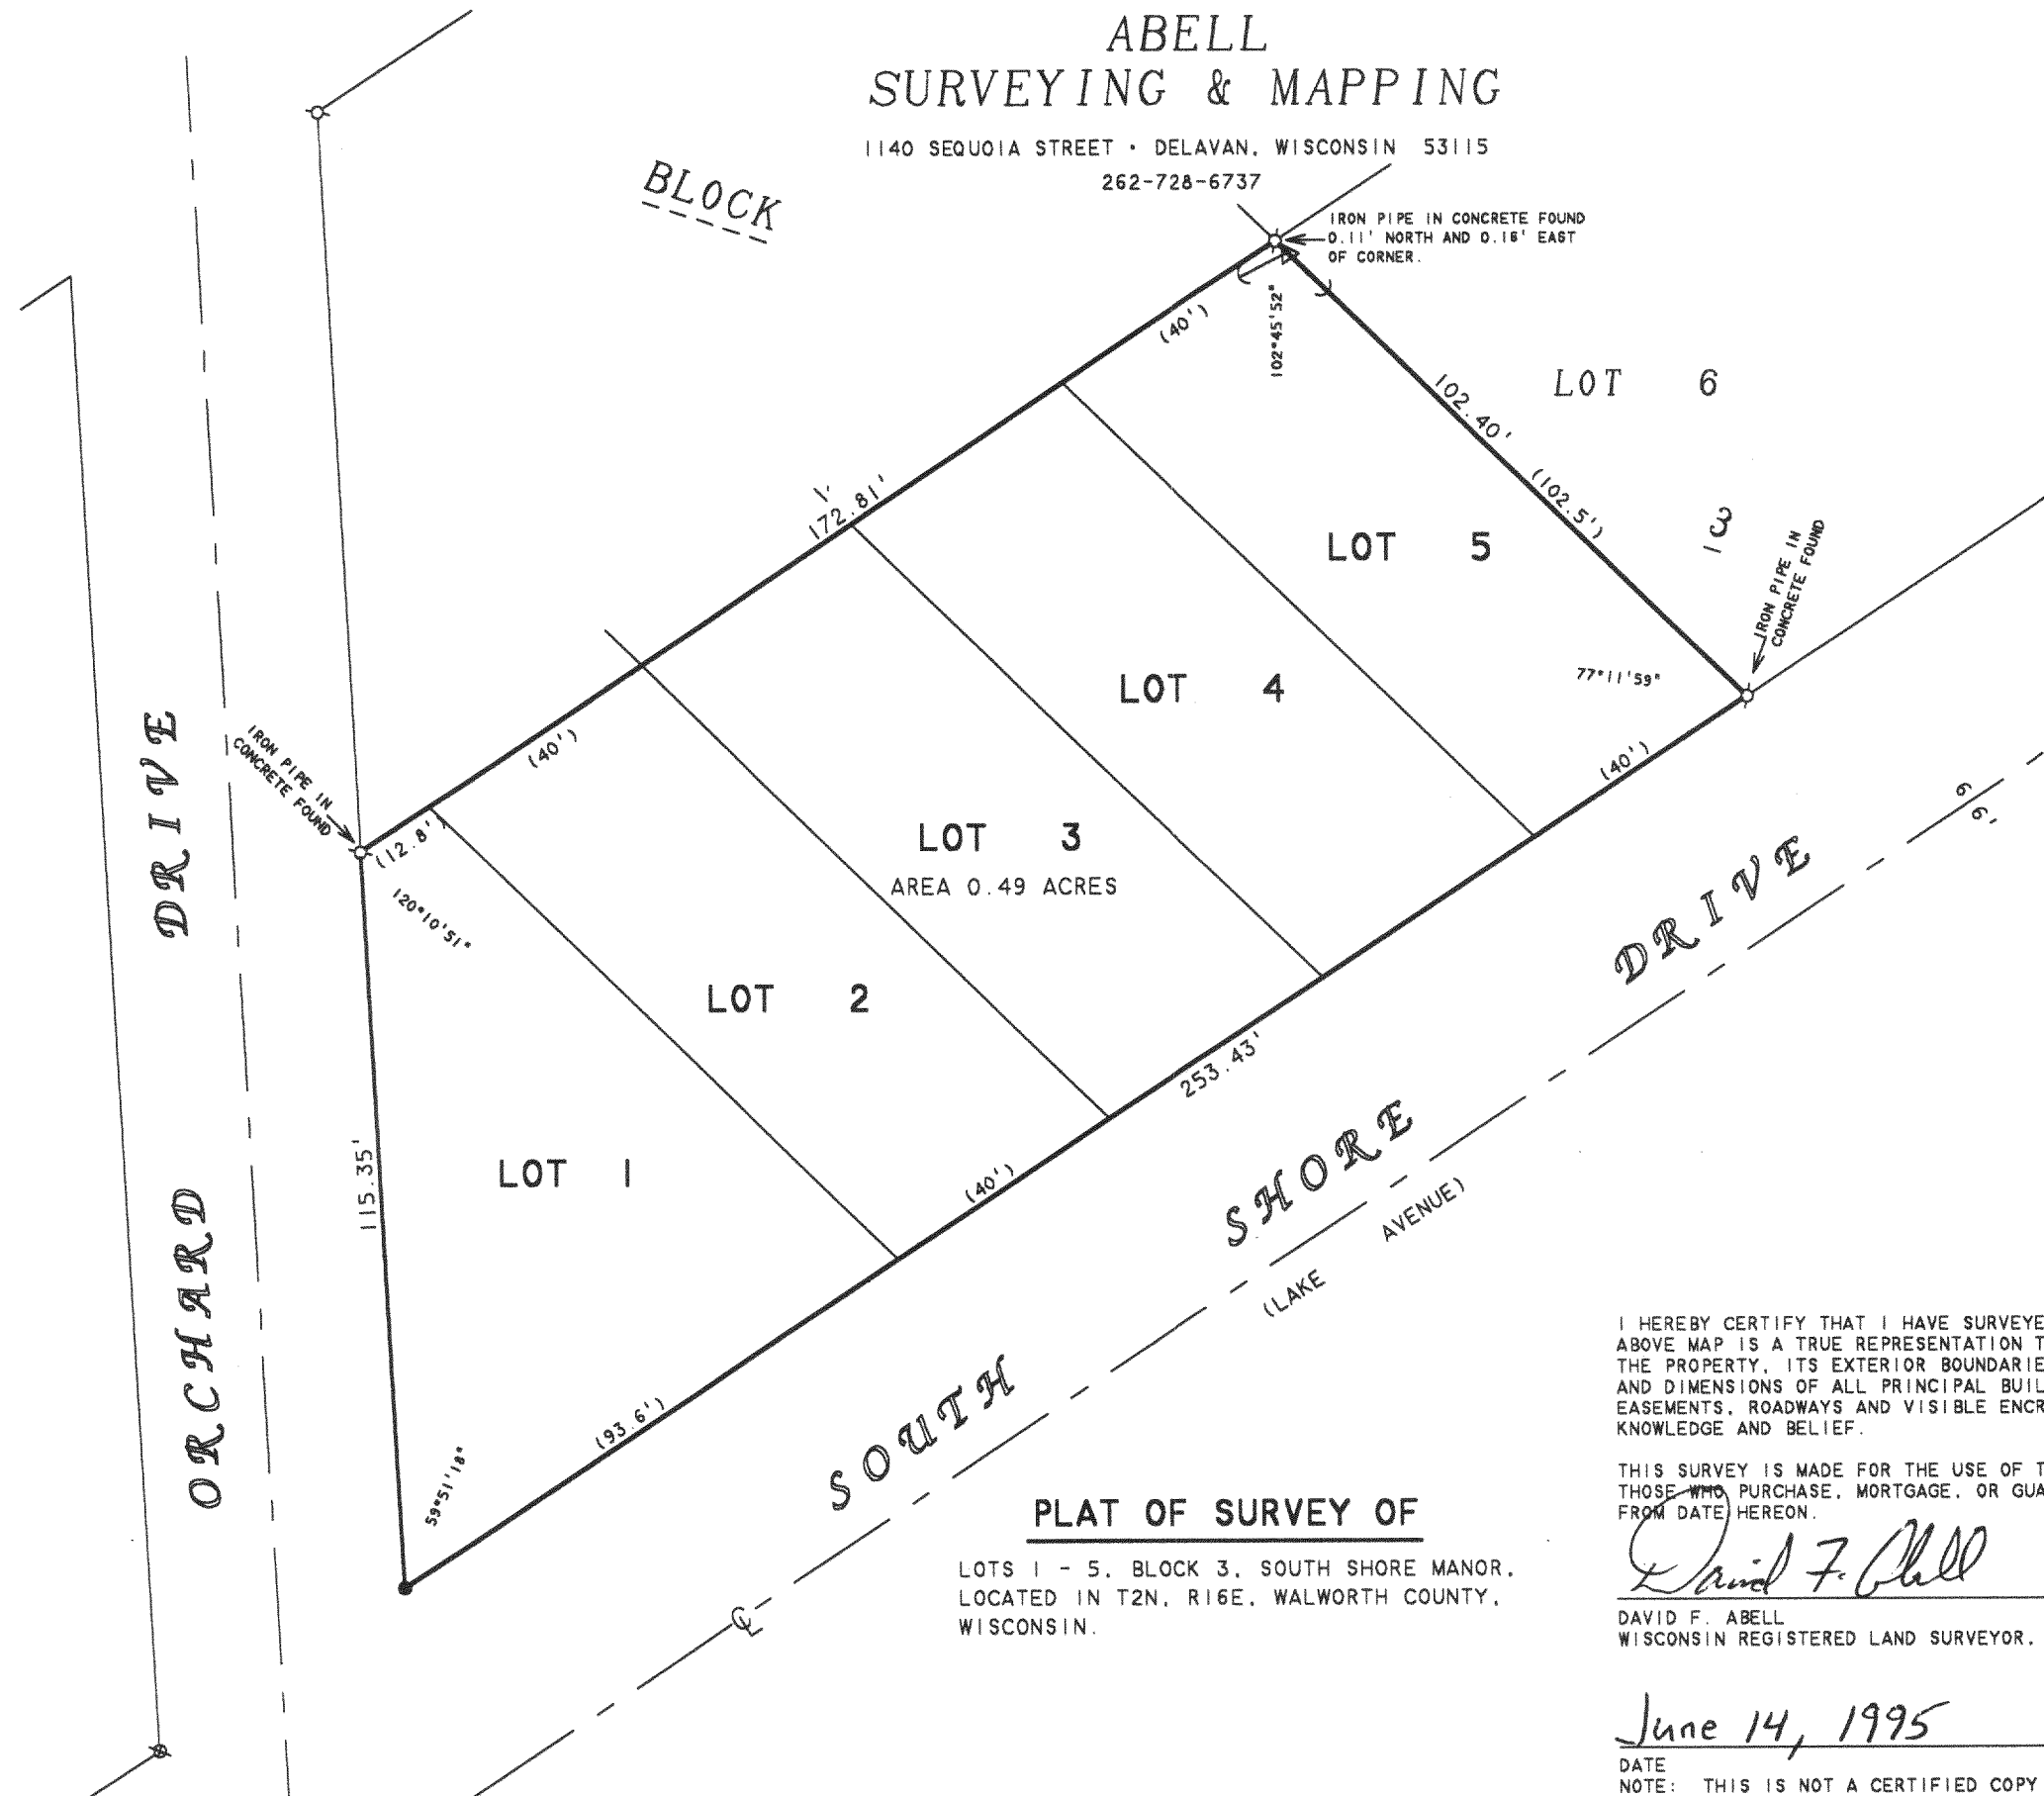

N



SCALE 1"=30'

LEGEND

- ⊗ - IRON PIPE FOUND
- ⊗ - 3/4" DIA. IRON ROD SET
- ⊗ - 60d SPIKE IN BLACKTOP FOUND
- △ - UTILITY POLE
- - GUY WIRE
- () - RECORDED AS

MAR 23 2005

PLAT OF SURVEY OF

LOTS 1 - 5, BLOCK 3, SOUTH SHORE MANOR,
LOCATED IN T2N, R16E, WALWORTH COUNTY,
WISCONSIN.

I HEREBY CERTIFY THAT I HAVE SURVEYED THE ABOVE DESCRIBED PROPERTY AND THAT THE ABOVE MAP IS A TRUE REPRESENTATION THEREOF AND SHOWS THE SIZE AND LOCATION OF THE PROPERTY, ITS EXTERIOR BOUNDARIES, THE LOCATION OF ALL VISIBLE STRUCTURES AND DIMENSIONS OF ALL PRINCIPAL BUILDINGS THEREON, BOUNDARY FENCES, APPARENT EASEMENTS, ROADWAYS AND VISIBLE ENCROACHMENTS, IF ANY, TO THE BEST OF MY KNOWLEDGE AND BELIEF.

THIS SURVEY IS MADE FOR THE USE OF THE PRESENT OWNERS OF THE PROPERTY, AND ALSO THOSE WHO PURCHASE, MORTGAGE, OR GUARANTEE THE TITLE THERETO WITHIN ONE (1) YEAR FROM DATE HEREON.

David F. Abell

DAVID F. ABELL
WISCONSIN REGISTERED LAND SURVEYOR, S-1596

June 14, 1995

DATE: June 14, 1995
JOB NUMBER - 95045A
NOTE: THIS IS NOT A CERTIFIED COPY UNLESS SEALED.

216-3969

FSS 00052
FSS 00053