
ABELL SURVEYING & MAPPING

1140 SEQUOIA STREET • DELAVAN, WISCONSIN 53115 262-728-6737

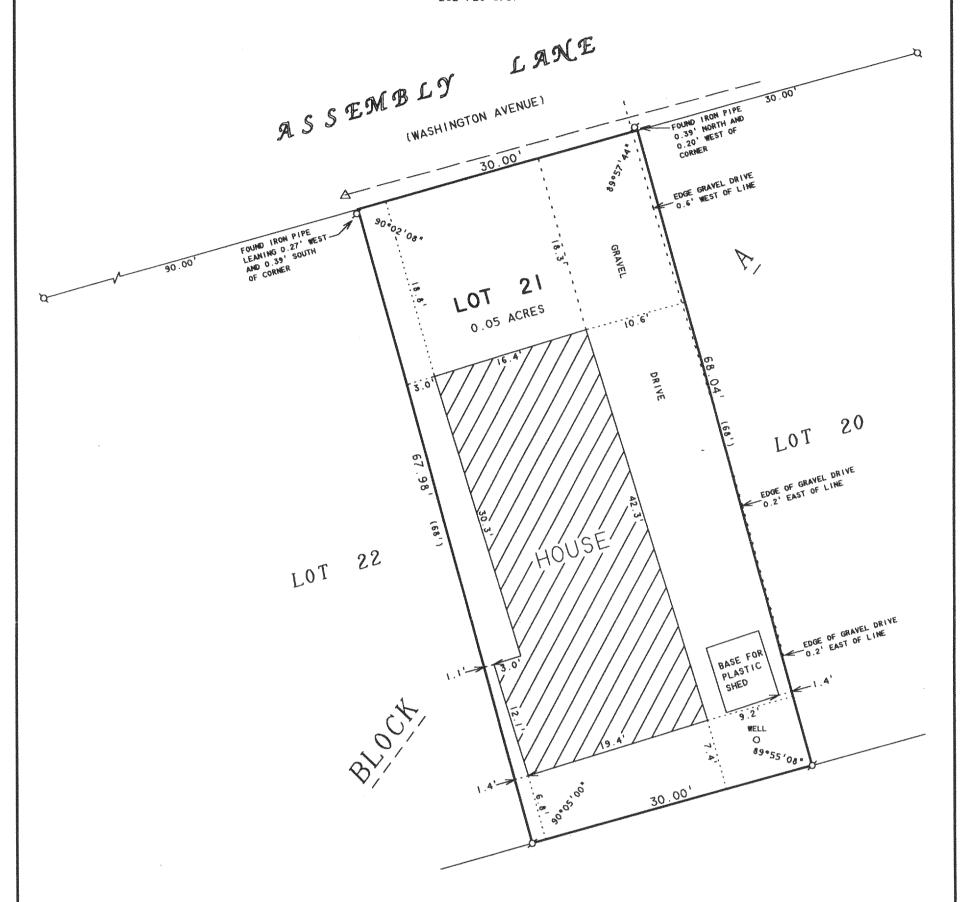

PLAT OF SURVEY OF

ORDERED BY: ALAN ALBUS
2414 RIVERMIST COURT
NAPERVILLE, IL 60565

LOT 21. BLOCK A. DELAVAN LAKE ASSEMBLY GROUNDS. LOCATED IN T2N.R16E. WALWORTH COUNTY. WISCONSIN.





SCALE | "=10'

LEGEND

Ø - IRON PIPE FOUND

Ø - UTILTIY POLE

OVERHEAD UTILITY LINES

() - RECORDED AS

I HEREBY CERTIFY THAT I HAVE SURVEYED THE ABOVE DESCRIBED PROPERTY AND THAT THE ABOVE MAP IS A TRUE REPRESENTATION THEREOF AND SHOWS THE SIZE AND LOCATION OF THE PROPERTY, ITS EXTERIOR BOUNDARIES, THE LOCATION OF ALL VISIBLE STRUCTURES AND DIMENSIONS OF ALL PRINCIPAL BUILDINGS THEREON, BOUNDARY FENCES, APPARENT EASEMENTS, ROADWAYS AND VISIBLE ENCROACHMENTS, IF ANY, TO THE BEST OF MY KNOWLEDGE AND BELIEF.

THIS SURVEY IS MADE FOR THE USE OF THE PRESENT OWNERS OF THE PROPERTY, AND ALSO THOSE WHO PURCHASE, MORTGAGE, OR GUARANTEE THE TITLE THERETO WITHIN ONE (L) YEAR FROM DATE HEREON.

Laid 7. Chill

DAVID F. ABELL WISCONSIN REGISTERED LAND SURVEYOR, S-1596

MAR 2 3 2005

January 5, 2005

DATE JOB NUMBER - 04162
NOTE: THIS IS NOT A CERTIFIED COPY UNLESS SEALED.