
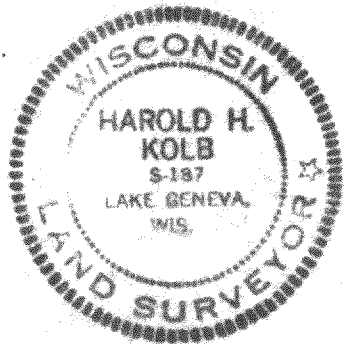


HAROLD H. KOLB
 REGISTERED PROFESSIONAL LAND SURVEYOR
 LAKE GENEVA, WISCONSIN

PLAT OF SURVEY OF

Lot 8 of Shadyside Park and Lot 7 of
 James Weed Subdivision of Shadyside
 Park, Section 33, T 2 N, R 16 E,
 Walworth County, Wisconsin.

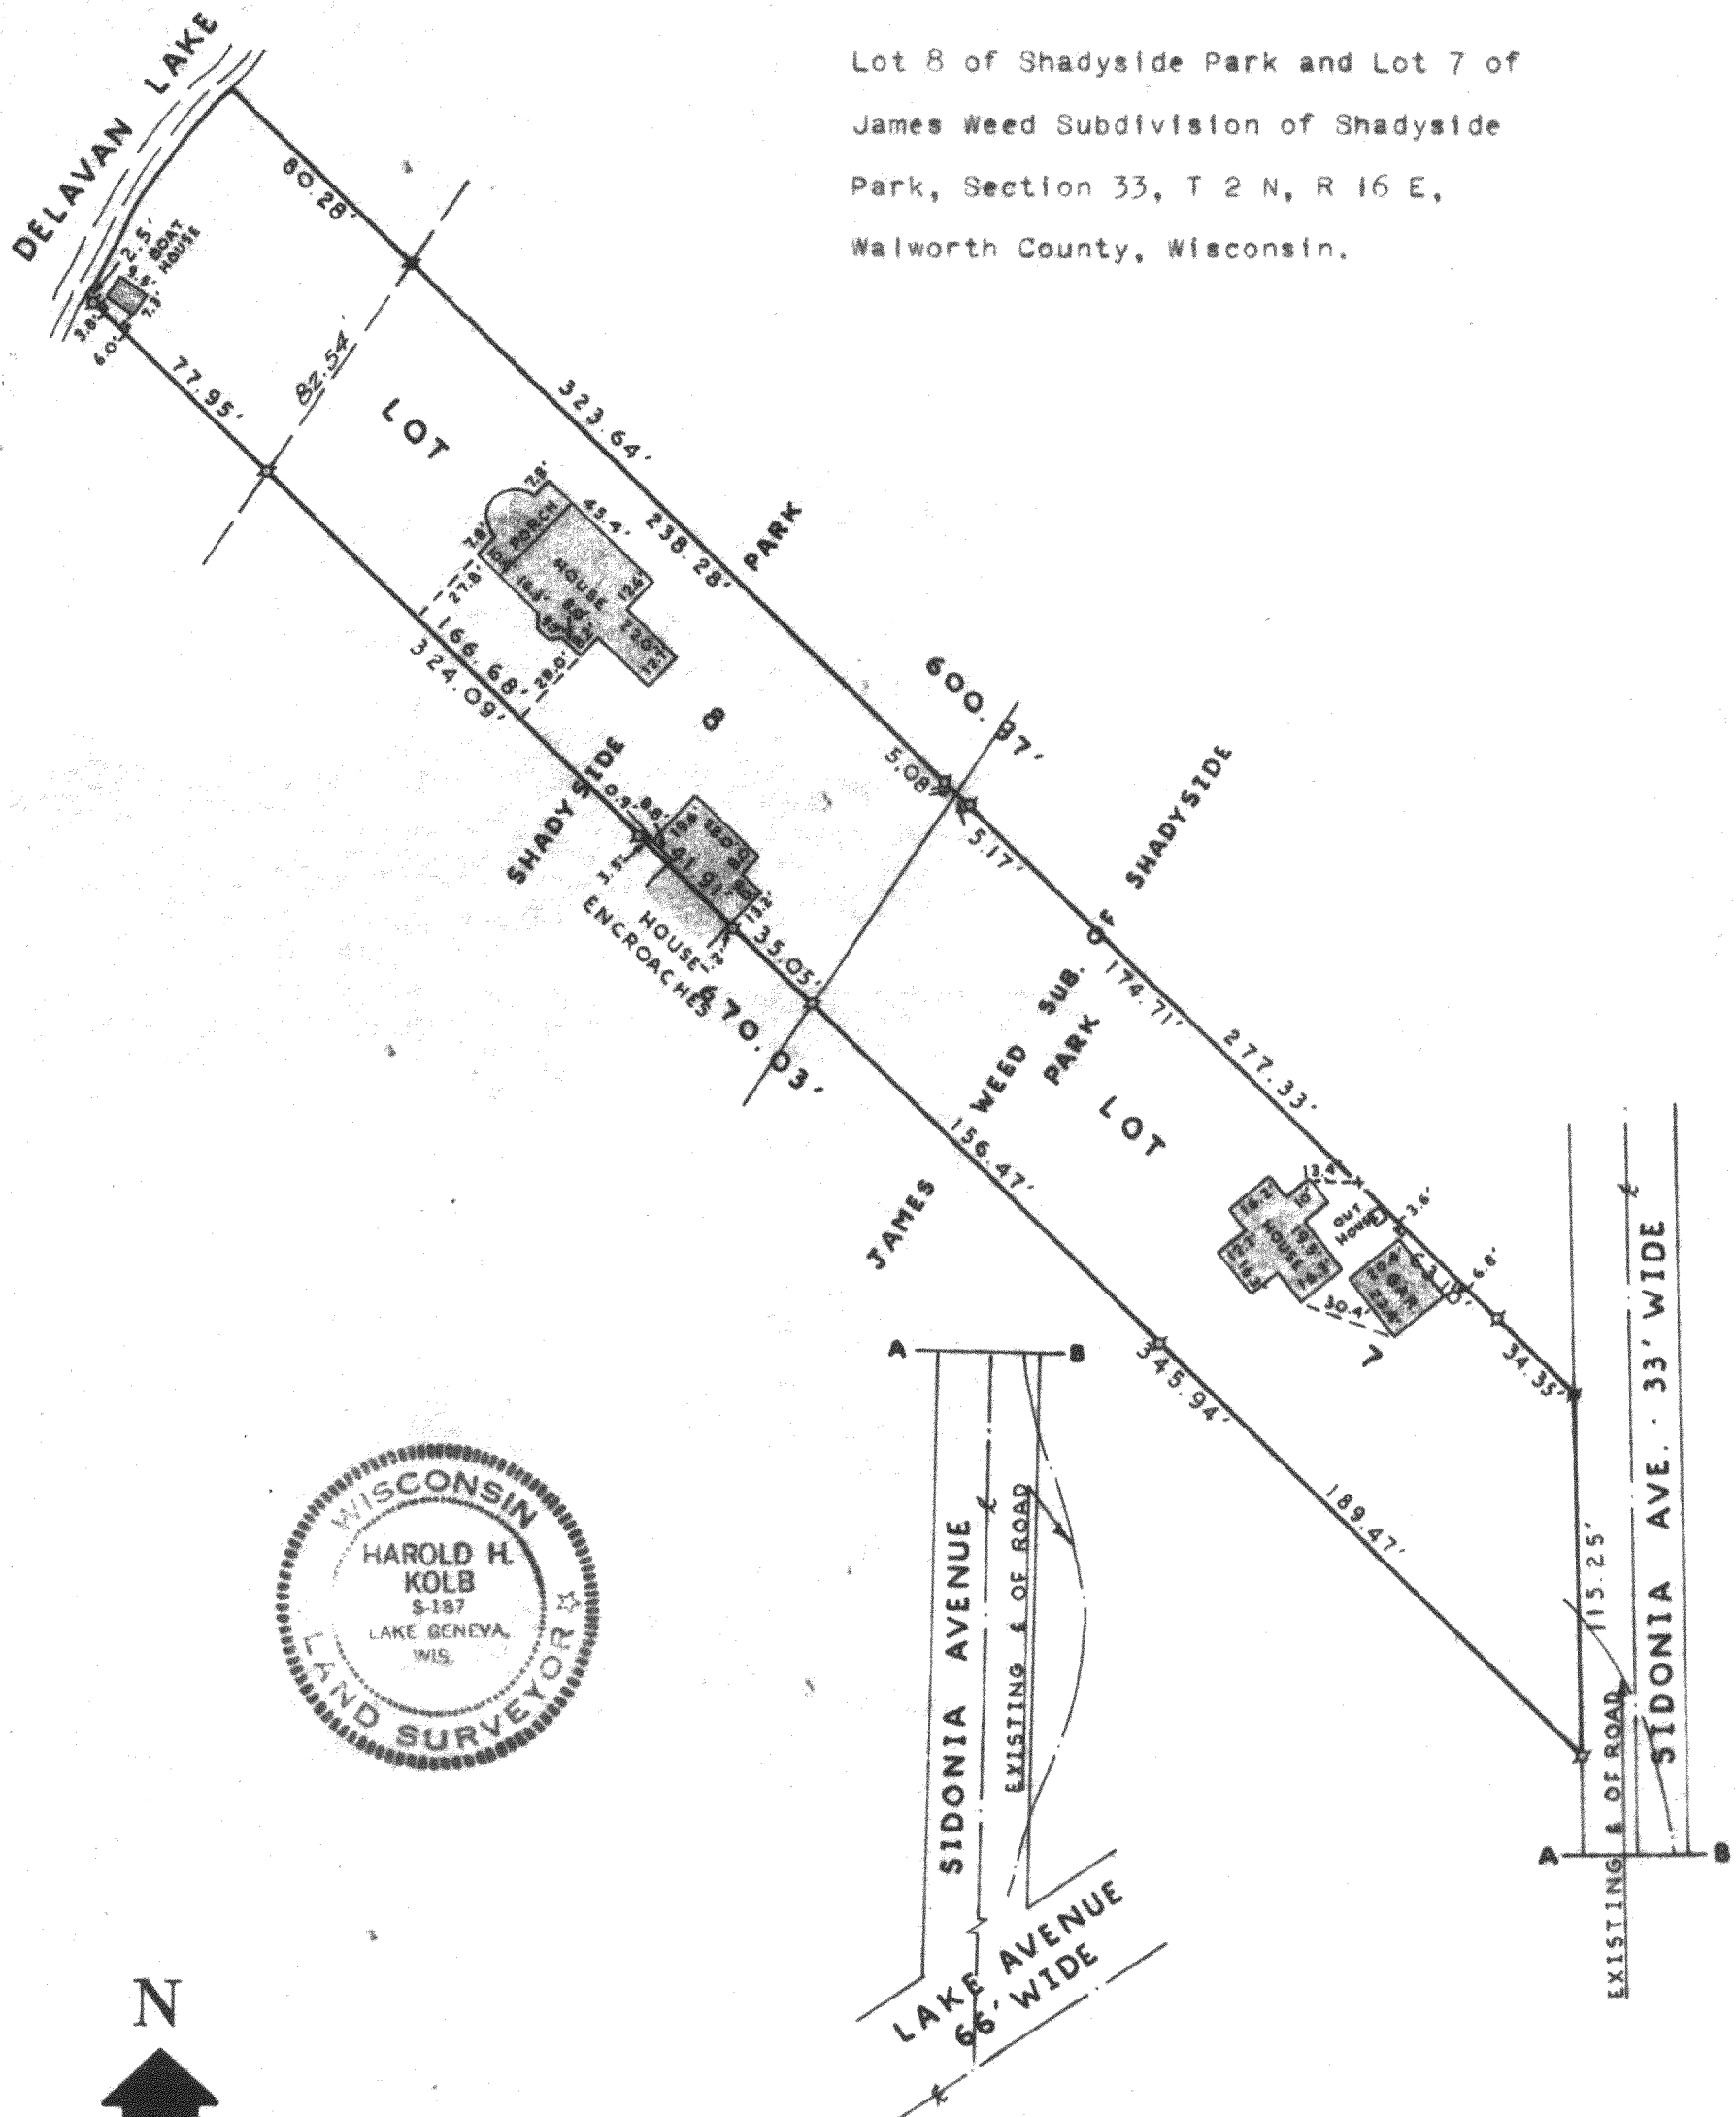

SCALE: 1"=60'

LEGEND

- ⊗ - IRON PIPE FOUND
- - IRON PIPE PLACED
- ⊕ - CONCRETE MONUMENT FOUND
- x - FOUND IRON ROD

I, HAROLD H. KOLB, DO HEREBY CERTIFY THAT I HAVE
 SURVEYED THE PROPERTY HEREON DESCRIBED ACCORDING
 TO THE OFFICIAL RECORDS, AND THAT THE PLAT HEREON
 IS A CORRECT REPRESENTATION OF THE LOT LINES.

Harold H. Kolb
 HAROLD H. KOLB

WISCONSIN REGISTERED LAND SURVEYOR, S-187
 DATE June 27, 1972

FSH-3 and FSHJ-3

216-398