

Re: Richard Labow

PREPARED FOR:
CENTURY 21 ZENK REALTY, LLC
804 N. WISCONSIN STREET
ELKHORN, WI, 53121



PLAT OF SURVEY

J.K. SURVEYING INC.
N3705 WILLOWBEND LANE
LAKE GENEVA, WI, 53147
262-248-3697

- OF -

PARCEL A : LOTS 27 & 28 EXCEPT THE EASTERLY 10' OF LOT 28 , BLOCK 14 DELAVAN LAKE VIEW CREST SUBDIVISION,
A SUBDIVISION LOCATED IN SECTION 31 TOWN 2 NORTH, RANGE 16 EAST OF THE FOURTH PRINCIPLE
MERIDIAN, TOWN OF DELAVAN, WALWORTH COUNTY, WISCONSIN

PARCEL B : THE WEST 1/2 OF LOT 30 & LOTS 29, & THE EASTERLY 10' OF LOT 28 , BLOCK 14 DELAVAN LAKE VIEW CREST SUBDIVISION,
A SUBDIVISION LOCATED IN SECTION 31 TOWN 2 NORTH, RANGE 16 EAST OF THE FOURTH PRINCIPLE
MERIDIAN, TOWN OF DELAVAN, WALWORTH COUNTY, WISCONSIN

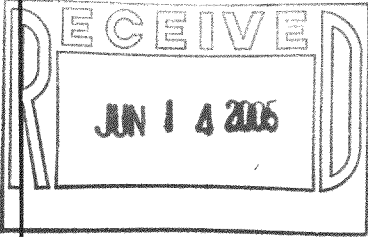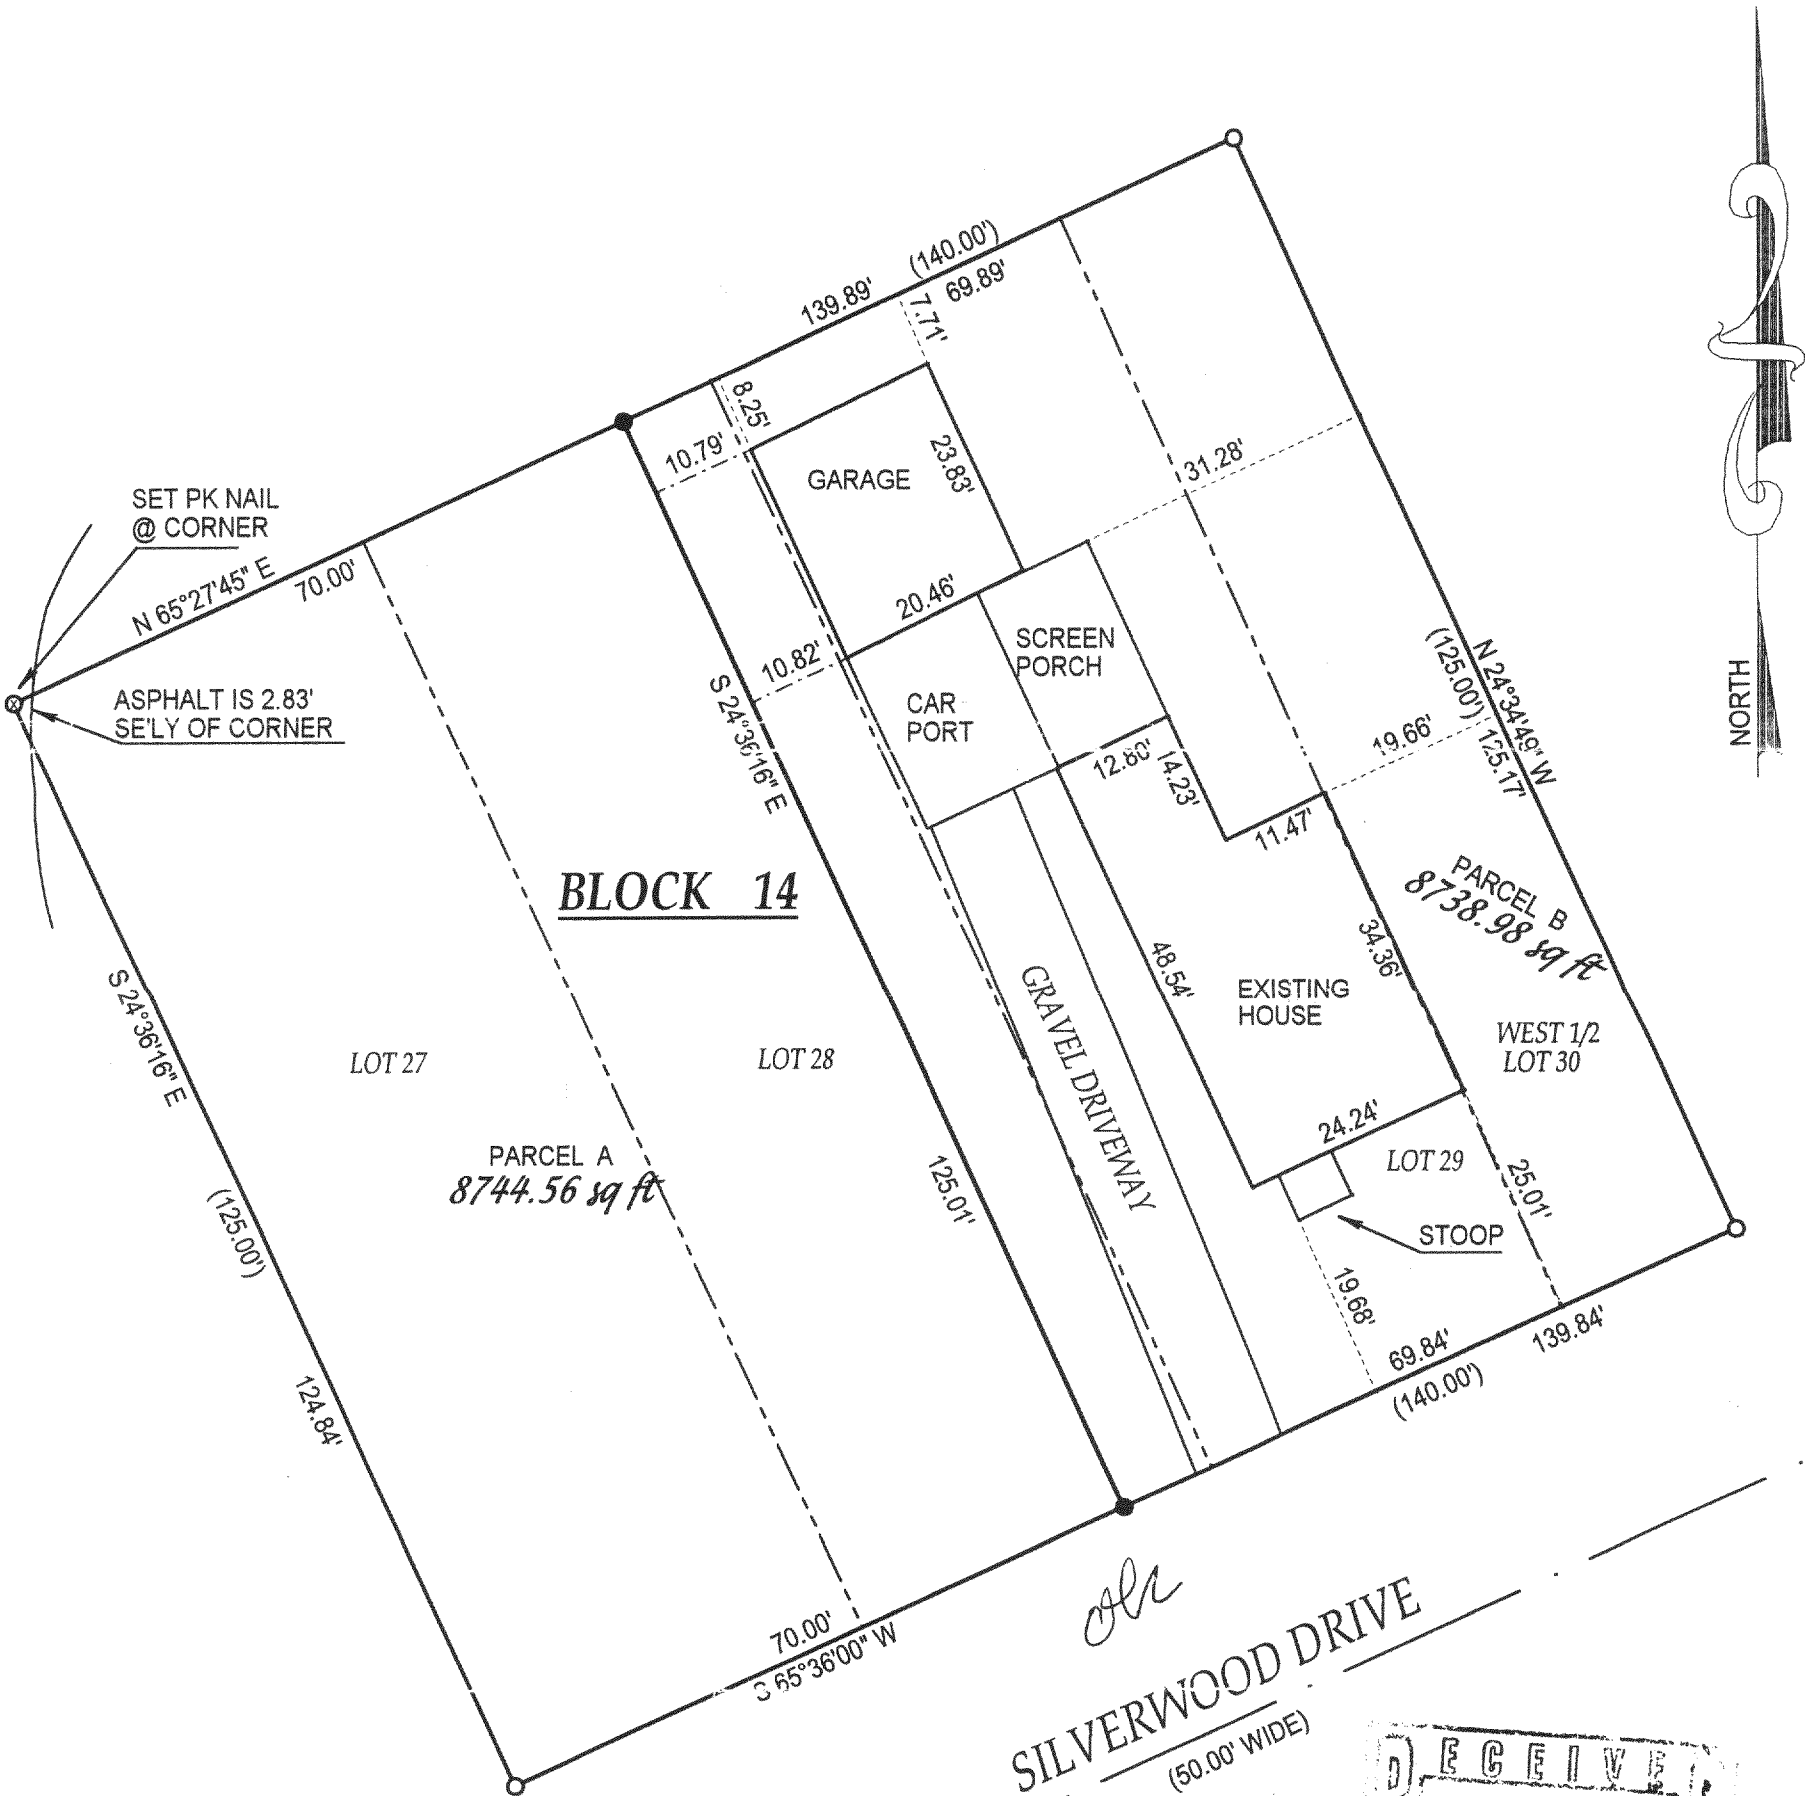



() = recorded as
□ = found iron bar
○ = found iron pipe
● = set iron pipe
■ = set iron bar
SCALE 1" = 20'
JOB # 01-222
TAX ID # 2-16-FDLV-65

DATE OF LAST REVISION 12-4-01

COMPARE LEGAL DESCRIPTION ABOVE AND DRAWING WITH DEED. FOR BUILDING RESTRICTIONS AND
EASEMENTS NOT SHOWN, REFER TO DEED, ABSTRACT SOURCES AND LOCAL MUNICIPAL CODES. NOTIFY
THE SURVEYOR IMMEDIATELY OF ANY DISCREPANCY.

"I hereby certify that I have surveyed the above described property and that
the above map is a true representation thereof and shows the size and
location of all visible structures, apparent easements and encroachments
if any."
This survey is made for the present owners of the property, and those who
purchase, mortgage, or guarantee the title thereto, within one year from
the date hereof.

DATED THIS 29 TH, DAY OF JUNE 20 01.

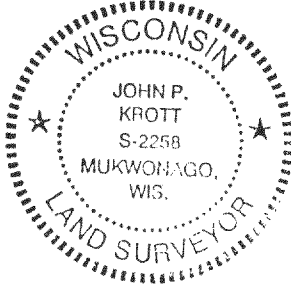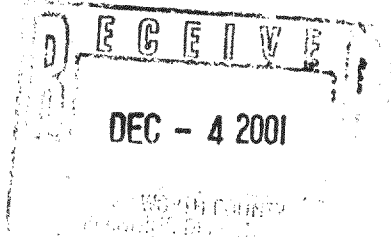

John P. Krott
JOHN KROTT S - 2258
Wisconsin Registered Land Surveyor
(original if signed in red)

FDLV 00065

216-3990