


1140 SEQUOIA STREET • DELAVAN, WISCONSIN 53115
262-728-6737

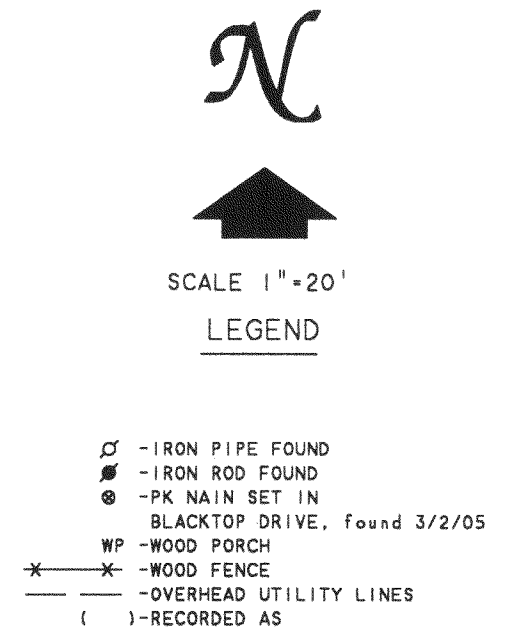

K JUL - 5 2005

THE NORTH 20 FEET OF LOT 16 AND THE
SOUTH 20 FEET OF LOT 17, CHICAGO CLUB
SUBDIVISION, LOCATED IN T2N. R16E.
WALWORTH COUNTY, WISCONSIN.

REVISED AND RECERTIFIED: MARCH 4, 2005
ORDERED BY: RE/MAX-LAKES AREA REALTORS
1815 N. SHORE DRIVE
DELAVER, WI. 53115

THIS SURVEY IS MADE FOR THE USE OF THE PRESENT OWNERS OF THE PROPERTY, AND ALSO THOSE WHO PURCHASE, MORTGAGE, OR GUARANTEE THE TITLE THERETO WITHIN ONE (1) YEAR FROM DATE HEREON.

Daniel F. Phelps

MAY 19, 1992

DATE _____ JOB NUMBER - 92067A
NOTE: THIS IS NOT A CERTIFIED COPY UNLESS SEALED.

216-3994

6800 FH