


APC-31P

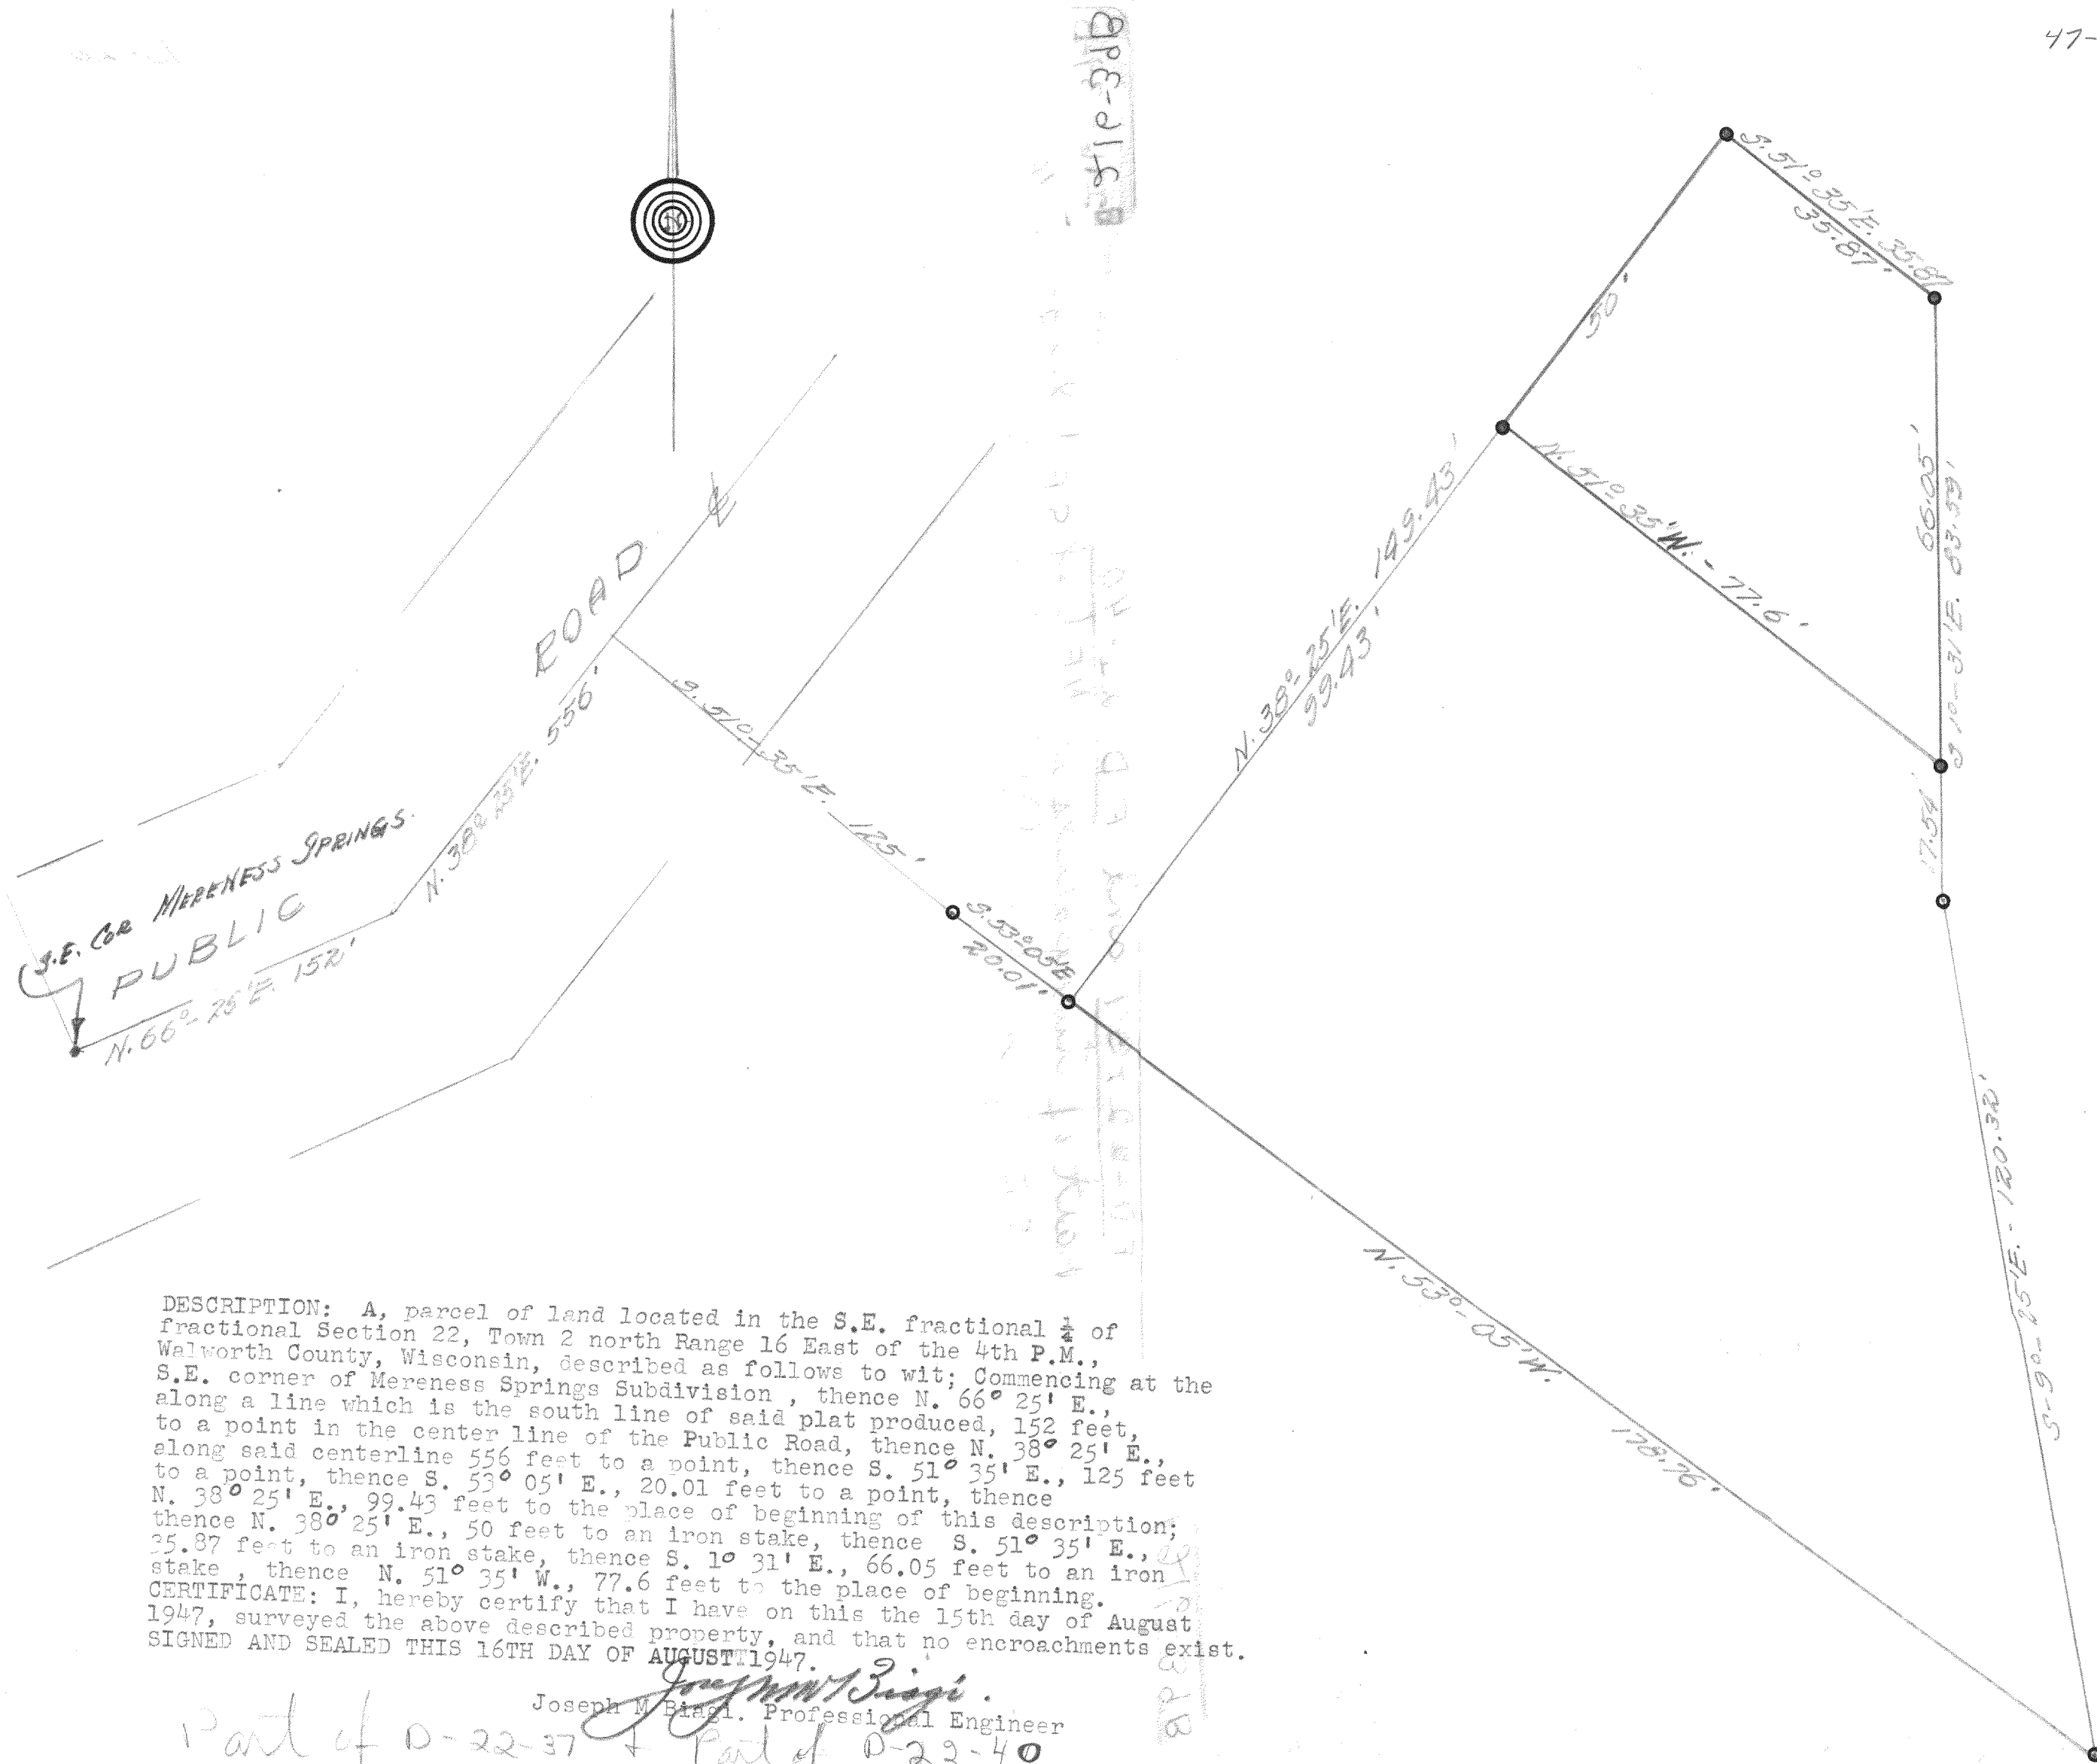

DESCRIPTION: A, parcel of land located in the S.E. fractional $\frac{1}{4}$ of fractional Section 22, Town 2 north Range 16 East of the 4th P.M., Walworth County, Wisconsin, described as follows to wit; Commencing at the S.E. corner of Mereness Springs Subdivision, thence N. 66° 25' E., along a line which is the south line of said plat produced, 152 feet, to a point in the center line of the Public Road, thence N. 38° 25' E., along said centerline 556 feet to a point, thence S. 51° 35' E., 125 feet to a point, thence S. 53° 05' E., 20.01 feet to a point, thence N. 38° 25' E., 99.43 feet to the place of beginning of this description; thence N. 38° 25' E., 50 feet to an iron stake, thence S. 51° 35' E., 35.87 feet to an iron stake, thence S. 10° 31' E., 66.05 feet to an iron stake, thence N. 51° 35' W., 77.6 feet to the place of beginning.

CERTIFICATE: I, hereby certify that I have on this the 15th day of August 1947, surveyed the above described property, and that no encroachments exist.

SIGNED AND SEALED THIS 16TH DAY OF AUGUST 1947.

Joseph M. Biagi, Professional Engineer

Part of D-22-37 + Part of D-22-40

216-398

935. NORTH

14.98 ACRES ±

935 S 00°16' E

EAST LINE SEC. 24, T2N, R16E

S.T.H. "67"

N 00°16' W 450.00'

S.E. CORNER
SEC. 24, T2N, R16E

PLACE OF BEGINNING

WEST 700.00'

WEST, 33.00'

PLAT OF SURVEY OF

A parcel of land located in the Southeast $\frac{1}{4}$ of Section 24, Town 2 North, Range 16 East, Walworth County, Wisconsin; and described as follows, to wit:

Commencing at the Southeast corner of said Section 24; thence N 00°16' W along the East line of said Section 24, 450.00 feet; thence West, 33.00 feet to an iron pipe on the West line of S.T.H."67" and the Point of Beginning; thence continue West, 700.00 feet to an iron pipe; thence North, 935.00 feet to an iron pipe; thence East, 695.55 feet to an iron pipe on said West line of S.T.H."67"; thence S 00°16' E along said West line of S.T.H."67", 935.01 feet to the Point of Beginning; containing 14.98 acres of land more or less.

CERTIFICATE

I, James F. Biagi, surveyor, do hereby certify that I have surveyed the lands hereon described.

March 5, 1971

James F. Biagi R.L.S. 272



REVISIONS					
NO.	DATE	BY			
1					
2					
3			DRAWN BY	SCALE	MATERIAL
4			CHK'D	DATE	DRAWING NO.
5			TRACED	APP'D	

D-24-9C

216-398B