

SCHROEDER AVENUE

40 FEET WIDE


ABELL SURVEYING & MAPPING

1140 SEQUOIA STREET • DELAVAN, WISCONSIN 53115
262-728-6737

STREET

COOL

G

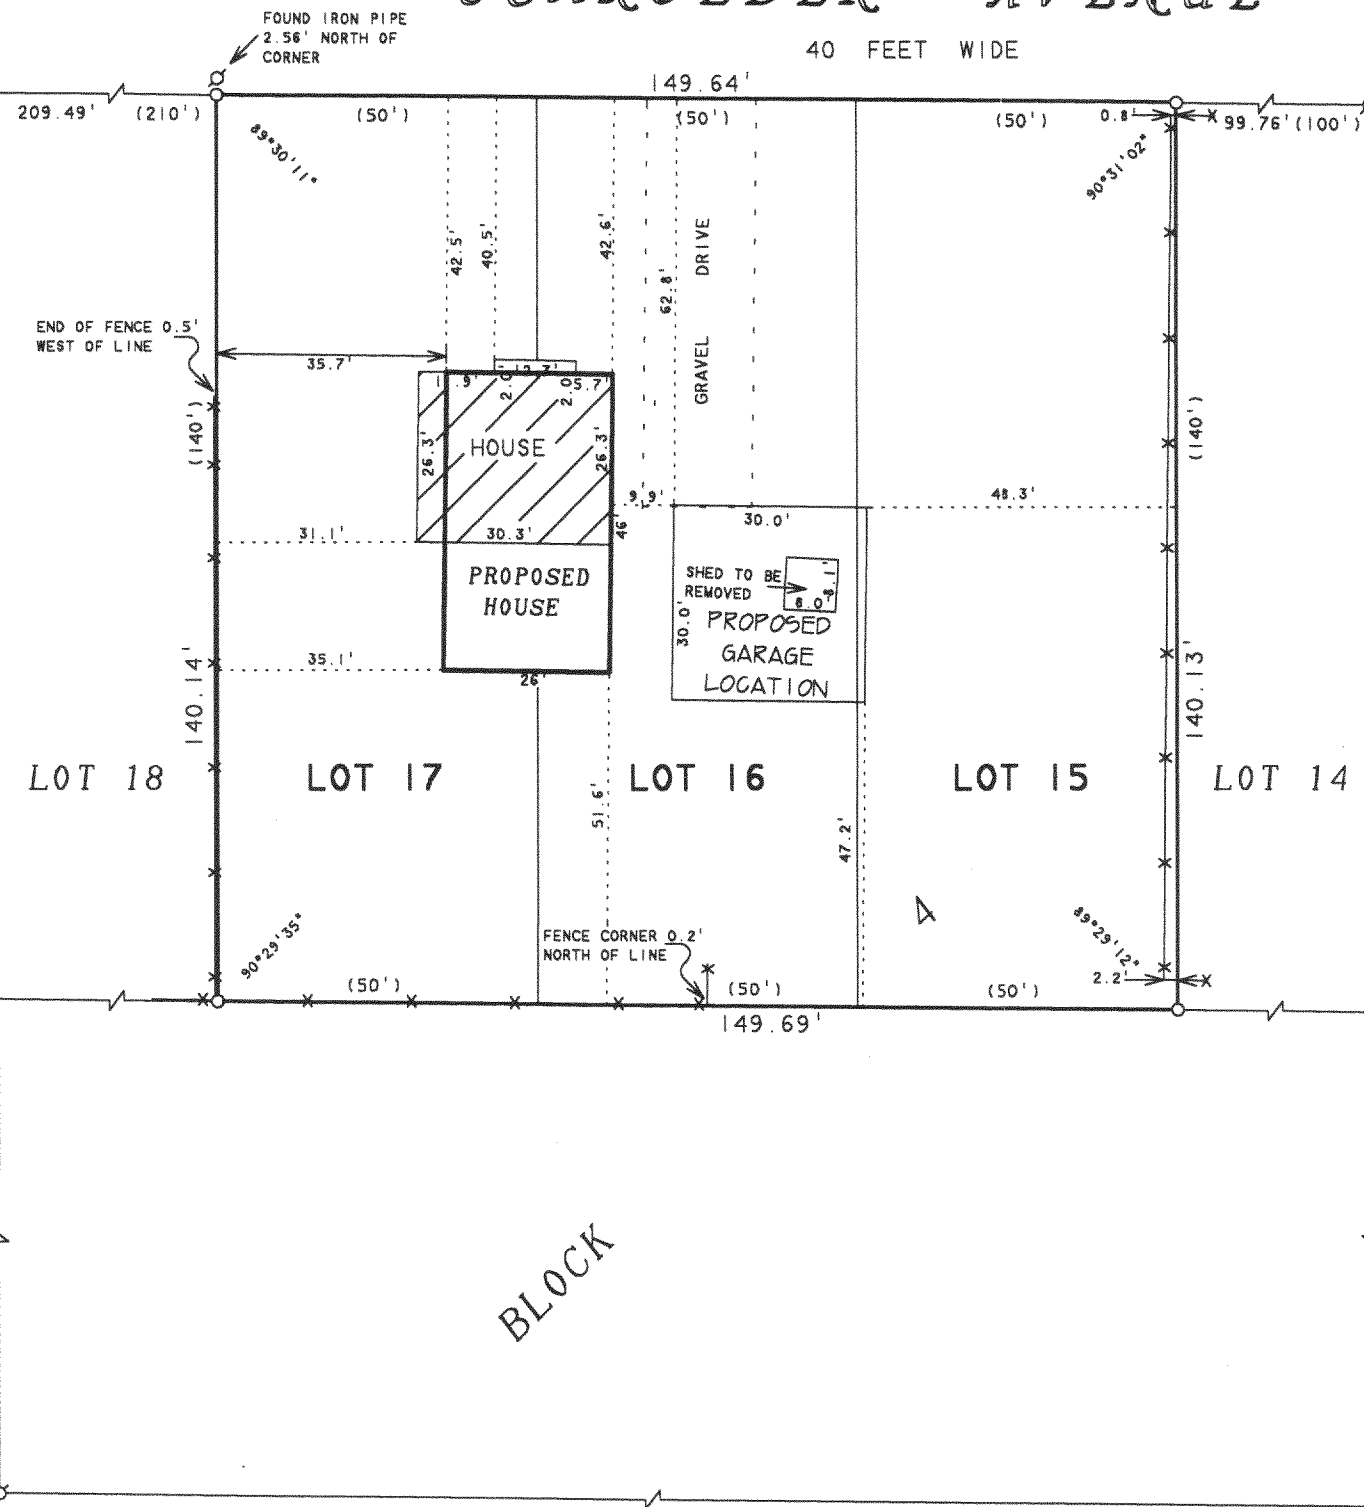

DELAVAN DRIVE

40 FEET WIDE

STREET

SUMMER

40 FEET WIDE

N



SCALE 1"=20'

LEGEND


- - IRON PIPE FOUND
- - IRON PIPE SET
- ✕ - WIRE FENCE
- - IRON ROD FOUND
- () - RECORDED AS

PLAT OF SURVEY OF

LOTS 15-17, BLOCK 4, INLET OAKS SUBDIVISION
NO. 4, T2N, R16E, WALWORTH COUNTY, WISCONSIN

REVISED: MARCH 23, 2005 TO SHOW THE
PROPOSED HOUSE ONLY.

ORDERED BY: MARK BOSS
413 SCHROEDER AVE.
DELAVAN, WI 53115

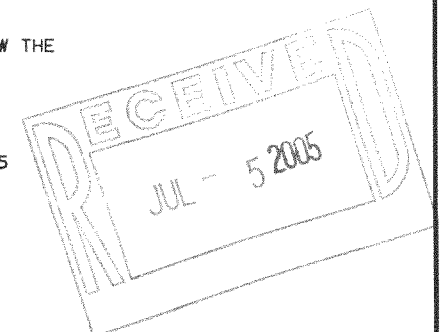

I, DAVID F. ABELL, DO HEREBY CERTIFY THAT I HAVE SURVEYED THE PROPERTY HEREON
DESCRIBED ACCORDING TO THE OFFICIAL RECORDS AND THAT THE PLAT HEREON IS A
CORRECT REPRESENTATION OF THE PROPERTY LINES TO THE BEST OF MY KNOWLEDGE AND
BELIEF.

David F. Abell

DAVID F. ABELL
WISCONSIN REGISTERED LAND SURVEYOR, S-1596

May 4, 1998

DATE: May 4, 1998 JOB NUMBER - 98068A
NOTE: THIS IS NOT A CERTIFIED COPY UNLESS SEALED.

216-4016

FIN 4 0031A