

216-4038

— WORK ORDERED BY —
MIKE FLORINO
BLOOM & FLORINO ARCHITECTS, INC.
1110 JORIE BLVD. #300
OAK BROOK, IL 60523

FARRIS, HANSEN & ASSOCIATES, INC.
ENGINEERING — ARCHITECTURE — SURVEYING
7 RIDGWAY COURT P.O. BOX 437
ELKHORN, WISCONSIN 53121
OFFICE: (262) 723-2098 FAX: (262) 723-5886



REVISIONS
02/14/2005
SITE, GRADING,
DRAINAGE, &
EROSION
CONTROL PLAN
05/20/2005
TO SHOW SIZE
& LOCATION OF
AS-BUILT
FOUNDATIONS

PROJECT NO.
6714
DATE:
01/31/05
SHEET NO.
1 OF 1

FRA 00044

AS-BUILT MAPPING PLAT OF SURVEY

LOTS 49-51 OF KRUMHAAR'S ADDITION TO RAVENSWOOD
LOCATED IN SECTION 31, TOWN 2 NORTH, RANGE 16 EAST,
WALWORTH COUNTY, WISCONSIN

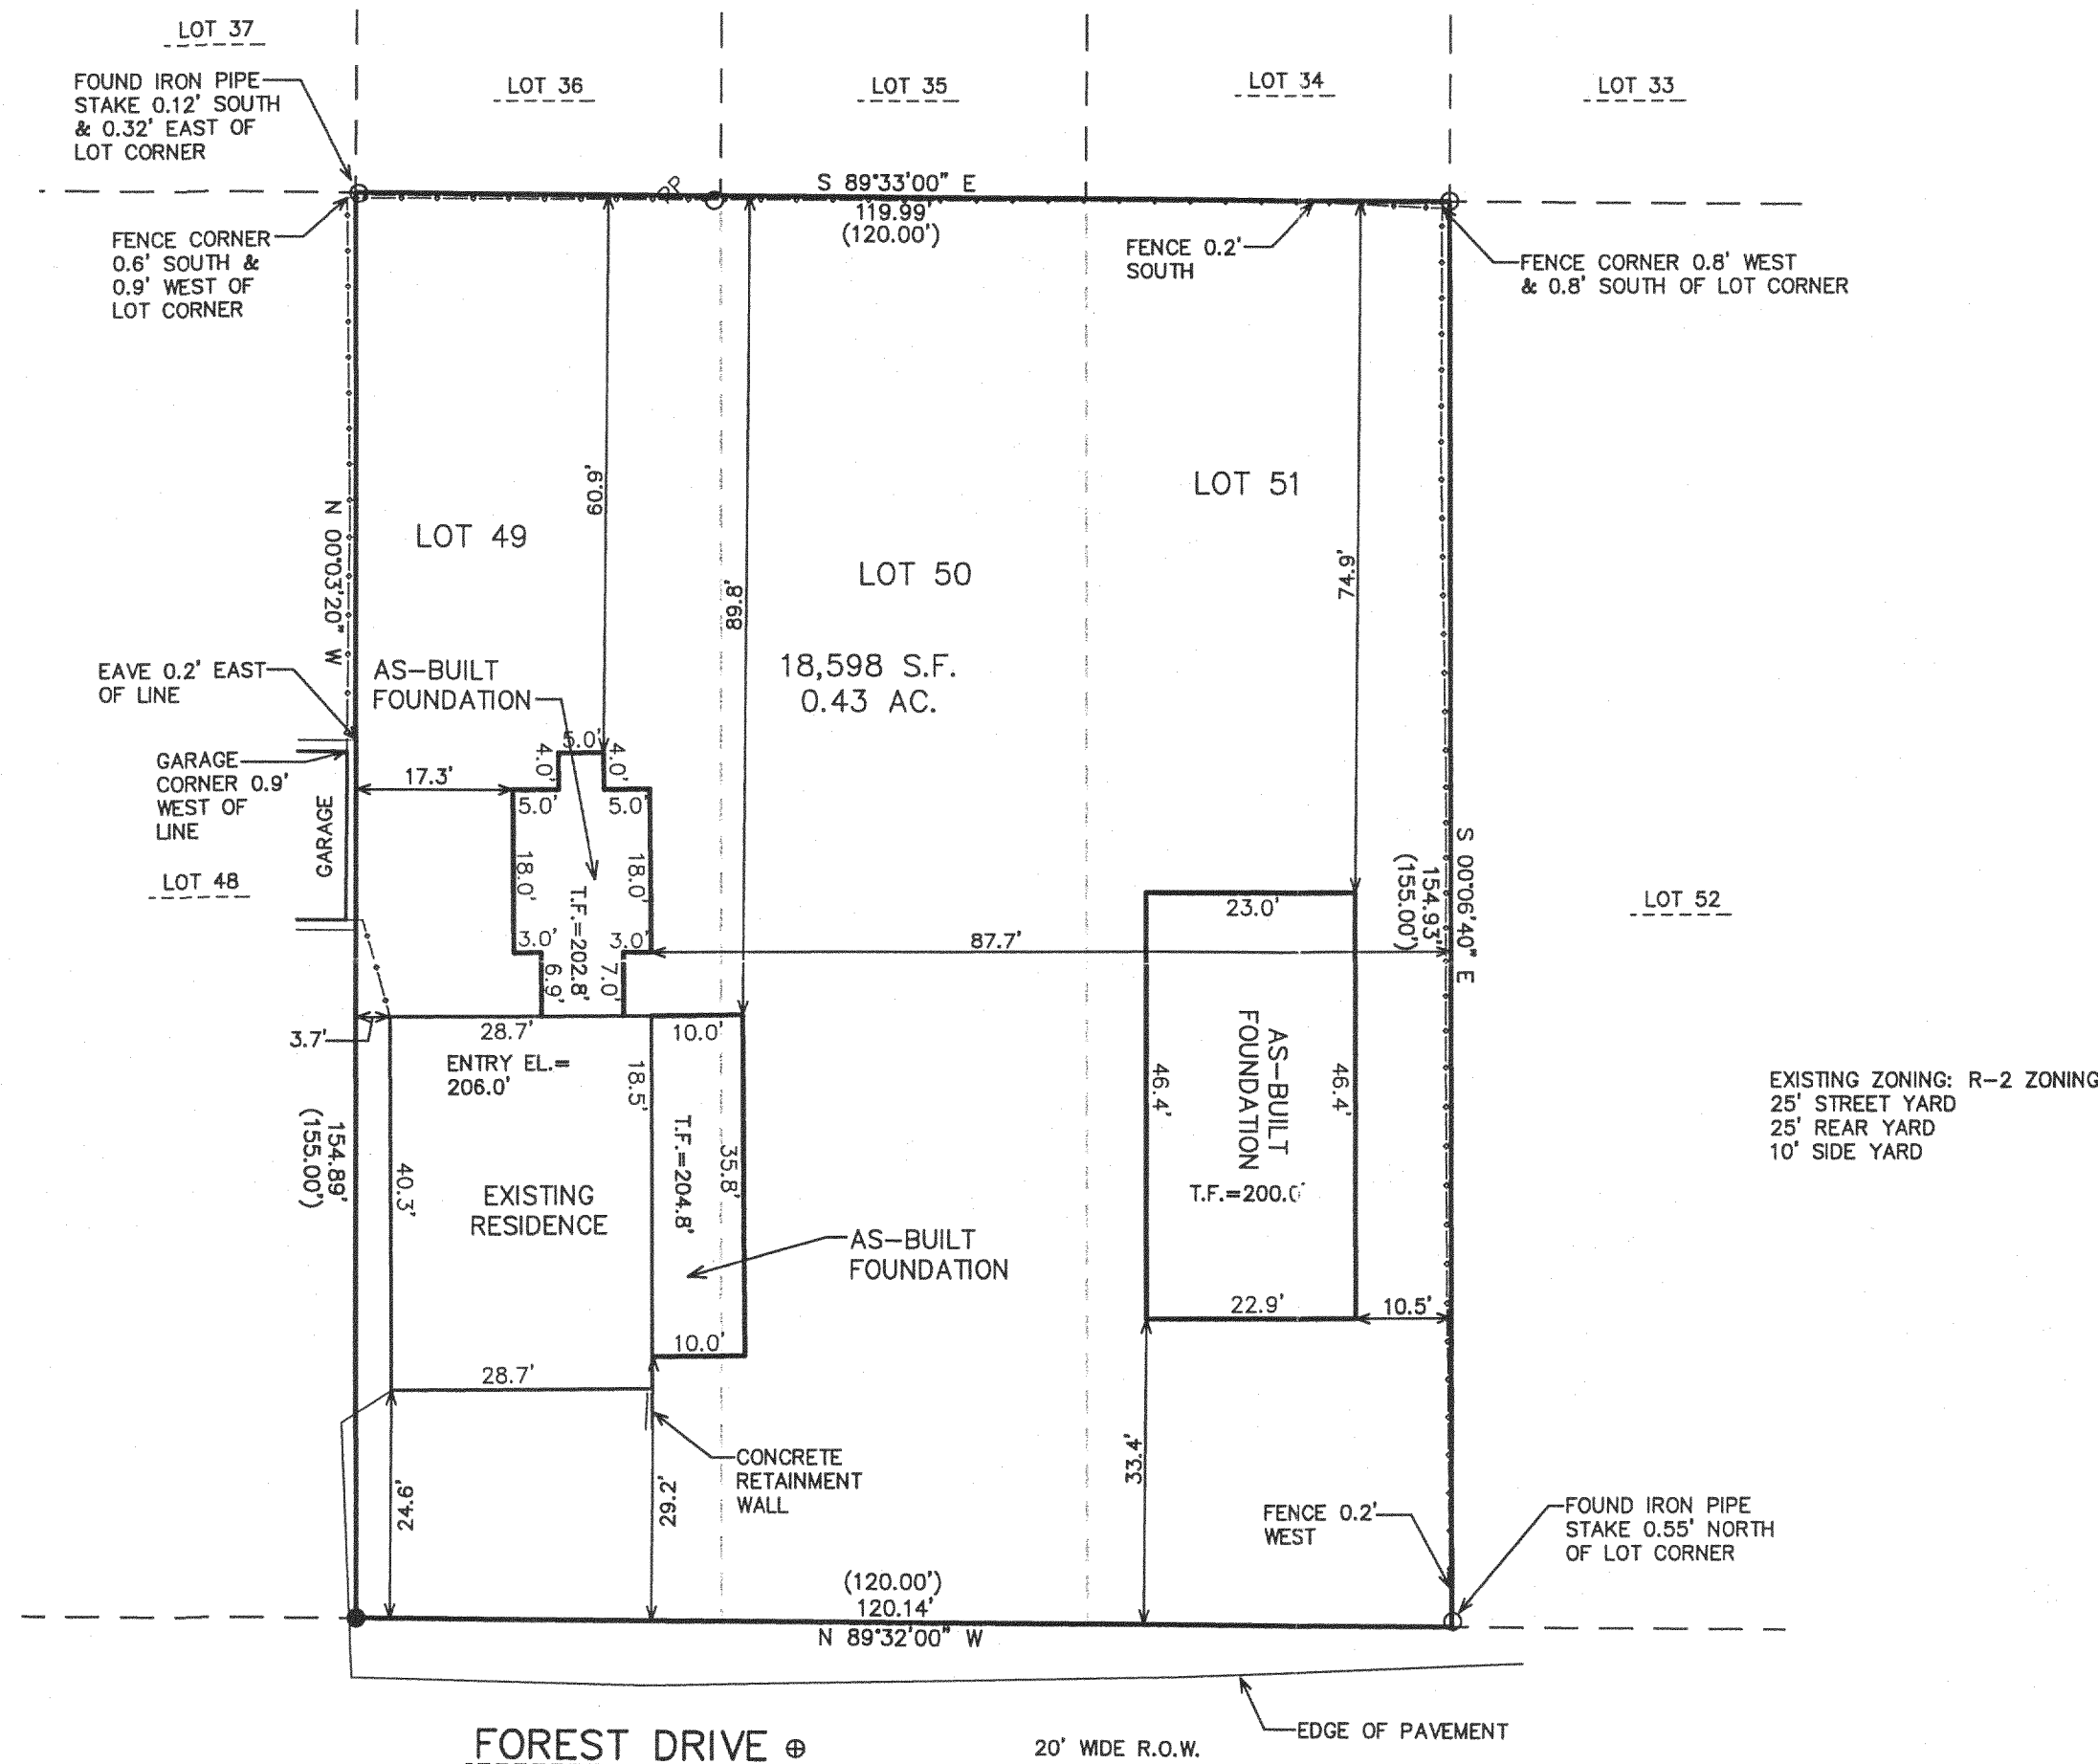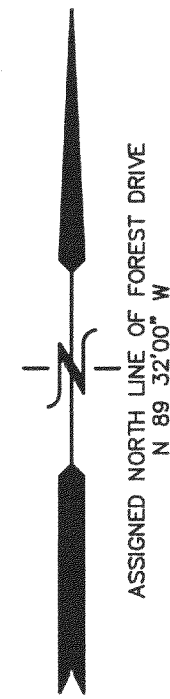

EXISTING ZONING: R-2 ZONING
25' STREET YARD
25' REAR YARD
10' SIDE YARD

FOREST DRIVE

20' WIDE R.O.W.

EDGE OF PAVEMENT

BENCH MARK
CHISELED "X" ON
WEST RIM SANITARY
MANHOLE, ASSIGNED
ELEV.=200.00'

LEGEND



- = FOUND IRON PIPE STAKE
- = FOUND IRON REBAR STAKE
- (XXX) = RECORDED AS
- T.F. = TOP OF FOUNDATION GRADE
- G.E. = GARAGE ENTRY GRADE

NOTE: COPIES OF THIS MAP TO WHICH THE FOLLOWING CERTIFICATE
WILL APPLY SHOW THE SURVEYOR'S ORIGINAL SEAL AND SIGNATURE
IN RED INK. COPIES BY ANY OTHER MEANS MAY HAVE ALTERATIONS
WHICH DO NOT REPRESENT THE SURVEYOR'S WORK PRODUCT.

I HEREBY CERTIFY THAT THE ABOVE DESCRIBED PROPERTY HAS BEEN
SURVEYED UNDER MY DIRECTION AND THAT THE ABOVE MAP IS A TRUE
REPRESENTATION THEREOF AND SHOWS THE SIZE AND LOCATION OF
THE PROPERTY AND ITS EXTERIOR BOUNDARIES. THIS SURVEY IS
MADE FOR THE USE OF THE PRESENT OWNERS OF THE PROPERTY, AND
ALSO THOSE WHO PURCHASE, MORTGAGE, OR GUARANTEE THE TITLE
THERE TO WITHIN ONE YEAR FROM THE DATE HEREOF.

DATED: JANUARY 31, 2005

Peter S. Gordon
PETER S. GORDON R.L.S. 2101

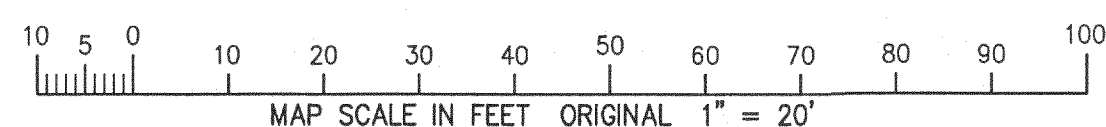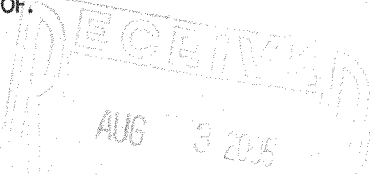

5/20/2005 X:\Projects\6714\Draw\AS-BUILT

MAY 20 2005