

ABELL SURVEYING & MAPPING

1140 SEQUOIA STREET • DELAVAN, WISCONSIN 53115
262-728-6737

FENCE CORNER 0.4' NORTH AND
0.7' WEST OF IRON PIPE

AVENUE

TILDEN


N



SCALE 1"=20'

LEGEND

- - IRON PIPE FOUND
- ⊙ - 10" SPIKE SET
- - SEWER CLEANOUT
- △ - UTILITY POLE
- - - OVERHEAD UTILITY LINES
- * - CHAINLINK FENCE
- () - RECORDED AS

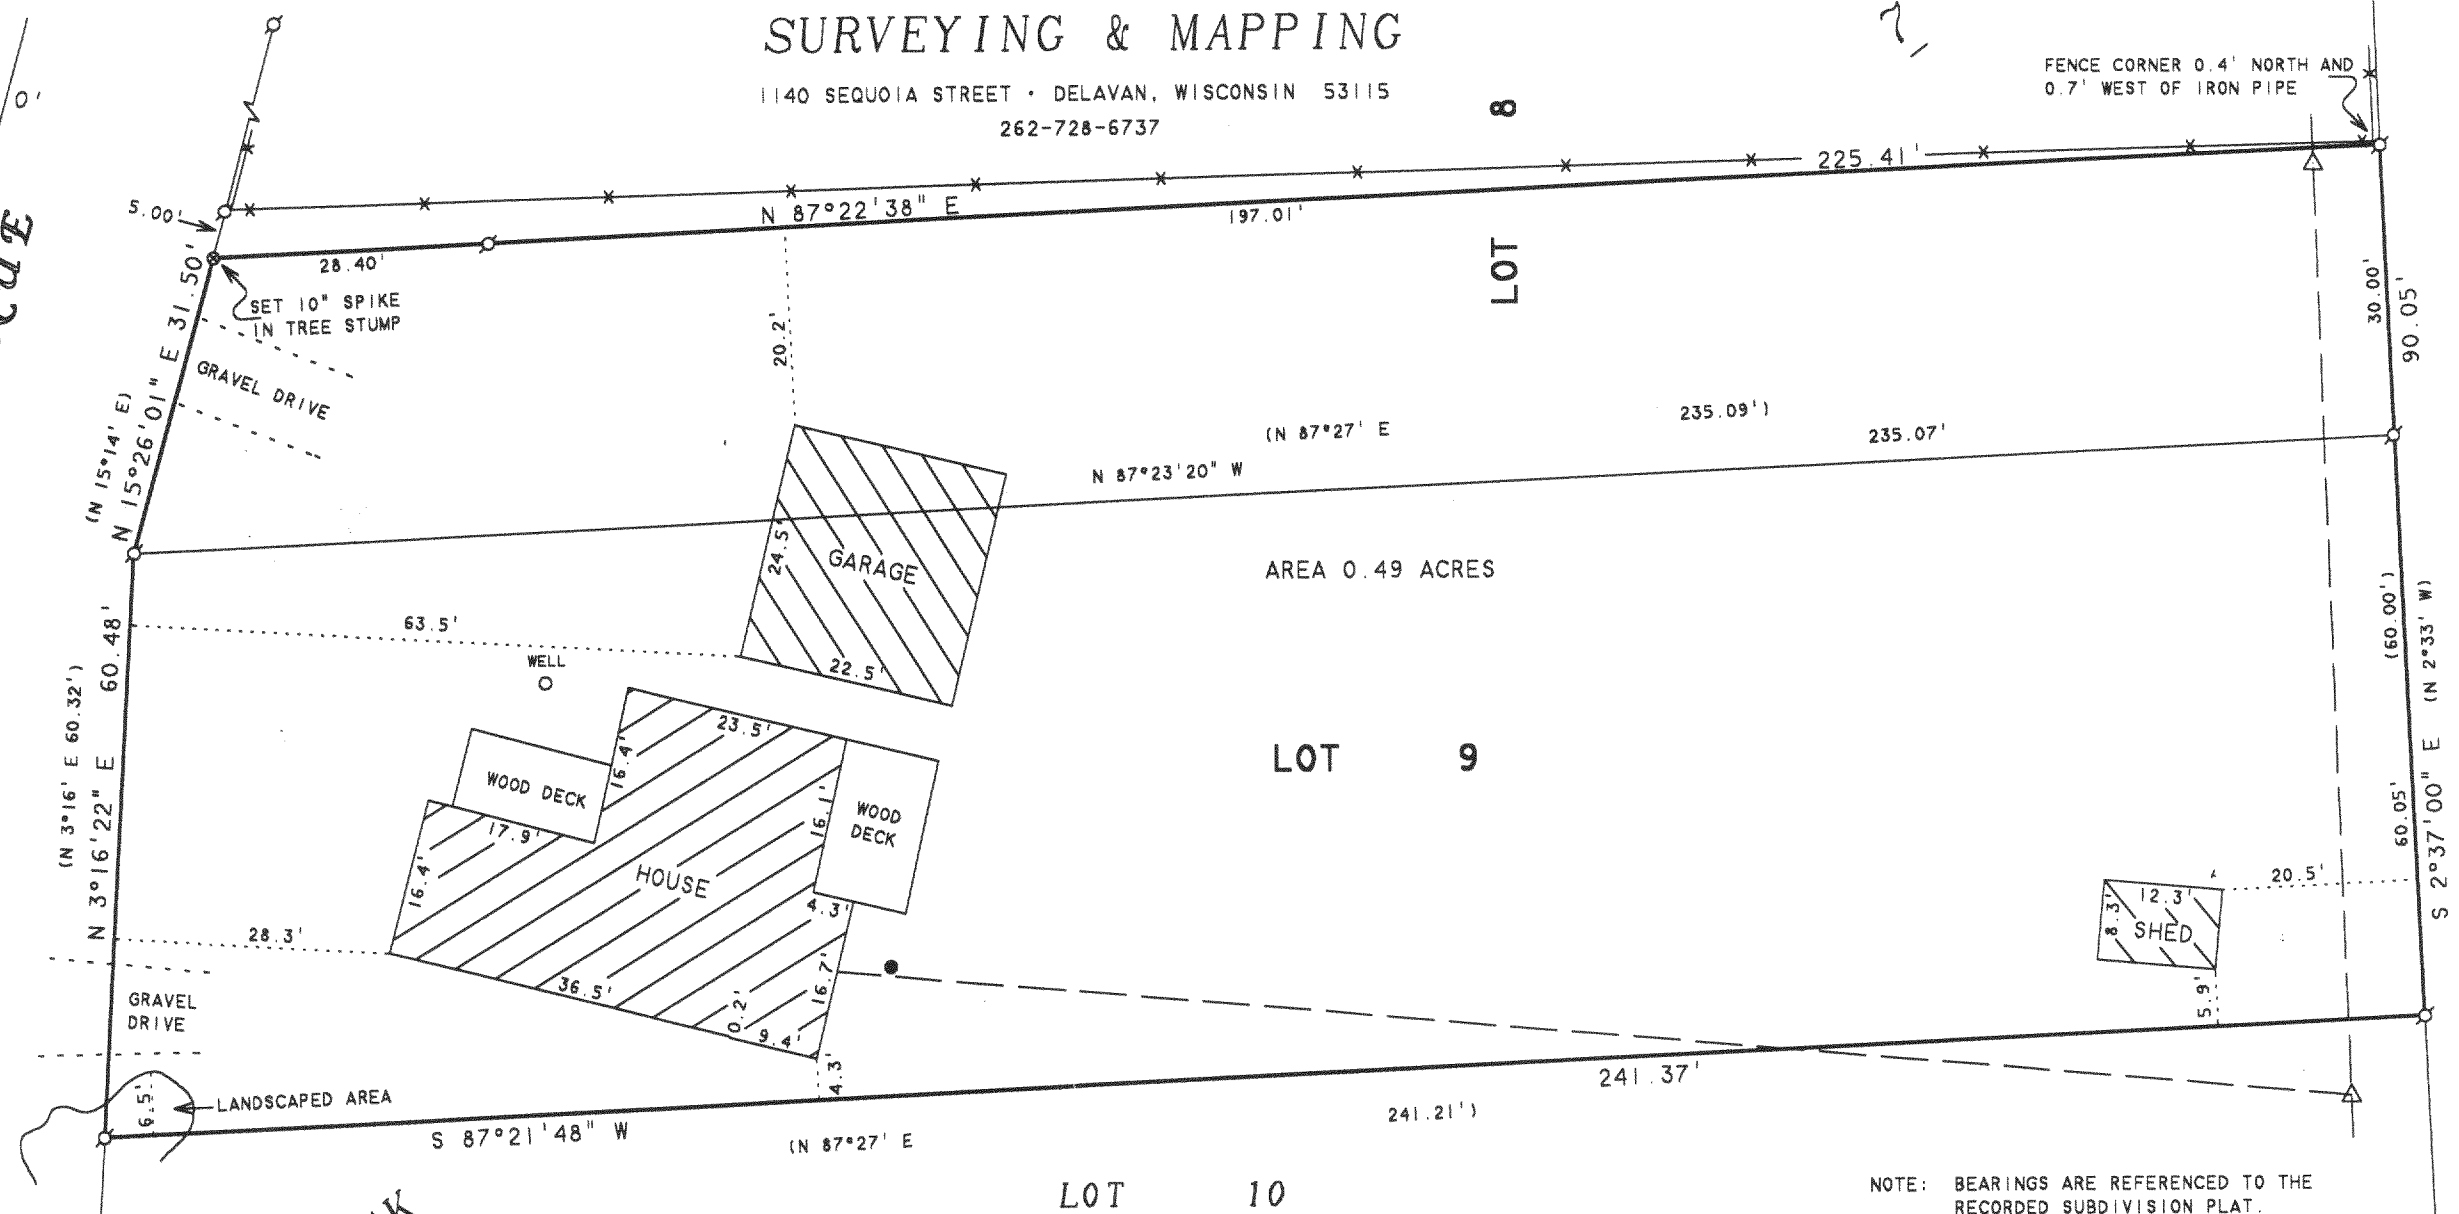

PLAT OF SURVEY OF

LOT 9 AND THE SOUTH 30 FEET OF LOT 8,
BLOCK 7, DELMAR SUBDIVISION, LOCATED
IN T2N, R16E, WALWORTH COUNTY, WISCONSIN.

NOTE: BEARINGS ARE REFERENCED TO THE
RECORDED SUBDIVISION PLAT.

I HEREBY CERTIFY THAT I HAVE SURVEYED THE ABOVE DESCRIBED PROPERTY AND THAT THE ABOVE MAP IS A TRUE REPRESENTATION THEREOF AND SHOWS THE SIZE AND LOCATION OF THE PROPERTY, ITS EXTERIOR BOUNDARIES, THE LOCATION OF ALL VISIBLE STRUCTURES AND DIMENSIONS OF ALL PRINCIPAL BUILDINGS THEREON, BOUNDARY FENCES, APPARENT EASEMENTS, ROADWAYS AND VISIBLE ENCROACHMENTS, IF ANY, TO THE BEST OF MY KNOWLEDGE AND BELIEF.

THIS SURVEY IS MADE FOR THE USE OF THE PRESENT OWNERS OF THE PROPERTY, AND ALSO THOSE WHO PURCHASE, MORTGAGE, OR GUARANTEE THE TITLE THERETO WITHIN ONE (1) YEAR FROM DATE HEREON.

David F. Abell

DAVID F. ABELL
WISCONSIN REGISTERED LAND SURVEYOR, S-1596

August 8, 2005

DATE: August 8, 2005
JOB NUMBER - 05095
NOTE: THIS IS NOT A CERTIFIED COPY UNLESS SEALED.

ORDERED BY: PAT DZIERZYNSKI
136 W. WAYNE PLACE
WHEELING, IL 60090

RECEIVED
AUG 26 2005

2K6-4056

FDm 0035B