

Wisconsin Registered Land Surveyor S-2582



LAND-MARKSURVEYING.COM

NOV 17 1995

8mf-


**ORDERED BY: SCHAUDER HOMES
6326 1ST AVE.
LAKE GENEVA, WI. 53147
(262) 248-1088**

**OWNER: JACK MELZER
4408 HIGHLAND DRIVE
DELAVAN, WI 53115**

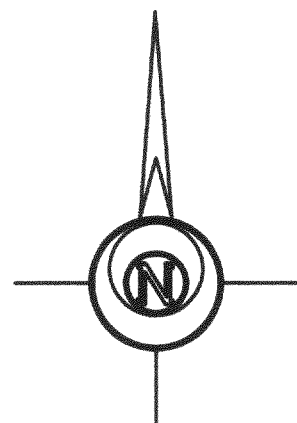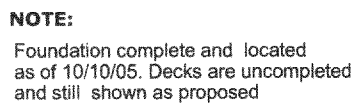

	FOUND IRON PIPE
	FOUND IRON ROD
	FOUND COUNTY MONUMENT
	OFFSET STAKE
+	CHISEL CUT IN CONCRETE
	SET IRON ROD, 24" LONG, WEIGHING 1.5 LBS./LINEAL FT., 3/4" DIA.
(x x)	RECORDED AS DIMENSION
	EXISTING FENCE

REVISD 10/10/05 FOUNDATION LOCATED "AS BUILT"

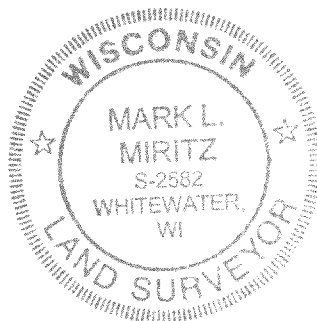

SCALE: 1" = 30 FEET

"I hereby certify that the above described property has been surveyed by me or under my direction and that the above map is a true representation thereof and shows the size and location of the property, its exterior boundaries, the location of all visible structures and dimensions of all principal buildings thereon, boundary fences, apparent easements, roadways and visible encroachments, if any."

"This survey is made for the use of the present owners of the property, and also those who purchase, mortgage, or guarantee the title thereto within one year from date hereof."

Mark L. Miritz
MARK L. MIRITZ
WISCONSIN REGISTERED
LAND SURVEYOR S-2582

DATE: JULY 26, 2005 JOB NO. 05.715

FDLV-157

216-4102