

ABELL SURVEYING & MAPPING

1140 SEQUOIA STREET • DELAVAN, WISCONSIN 53115
262-728-6737

NOTE: BEARINGS ARE REFERENCED TO
EXISTING SURVEY RECORDS.



SCALE 1"=30'

LEGEND

- ⊙ - IRON PIPE FOUND
- ⊙ - IRON ROD FOUND
- ⊙ - IRON "T" POST FOUND
- ⊙ - UTILITY POLE
- ⊙ - GUYWIRE
- ⊙ - PK NAIL SET, OR AS NOTED
- ⊙ - PK NAIL FOUND
- BE - BASEMENT ENTRY
- () - RECORDED AS

ORDERED BY: LES CUDZIK
35A TERRACE LANE
LAKE ZURICK, IL 60047

REVISED: JANUARY 19, 2006 TO SHOW THE
HOUSE UNDER CONSTRUCTION

I HEREBY CERTIFY THAT I HAVE SURVEYED THE ABOVE DESCRIBED PROPERTY AND THAT THE ABOVE MAP IS A TRUE REPRESENTATION THEREOF AND SHOWS THE SIZE AND LOCATION OF THE PROPERTY, ITS EXTERIOR BOUNDARIES, THE LOCATION OF ALL VISIBLE STRUCTURES AND DIMENSIONS OF ALL PRINCIPAL BUILDINGS THEREON, BOUNDARY FENCES, APPARENT EASEMENTS, ROADWAYS AND VISIBLE ENCROACHMENTS, IF ANY, TO THE BEST OF MY KNOWLEDGE AND BELIEF.


THIS SURVEY IS MADE FOR THE USE OF THE PRESENT OWNERS OF THE PROPERTY, AND ALSO THOSE WHO PURCHASE, MORTGAGE, OR GUARANTEE THE TITLE THERETO WITHIN ONE (1) YEAR FROM DATE HEREON.

David F. Abell

DAVID F. ABELL
WISCONSIN REGISTERED LAND SURVEYOR, S-1596


July 18, 2005

DATE: _____ JOB NUMBER - 05070A
NOTE: THIS IS NOT A CERTIFIED COPY UNLESS SEALED.

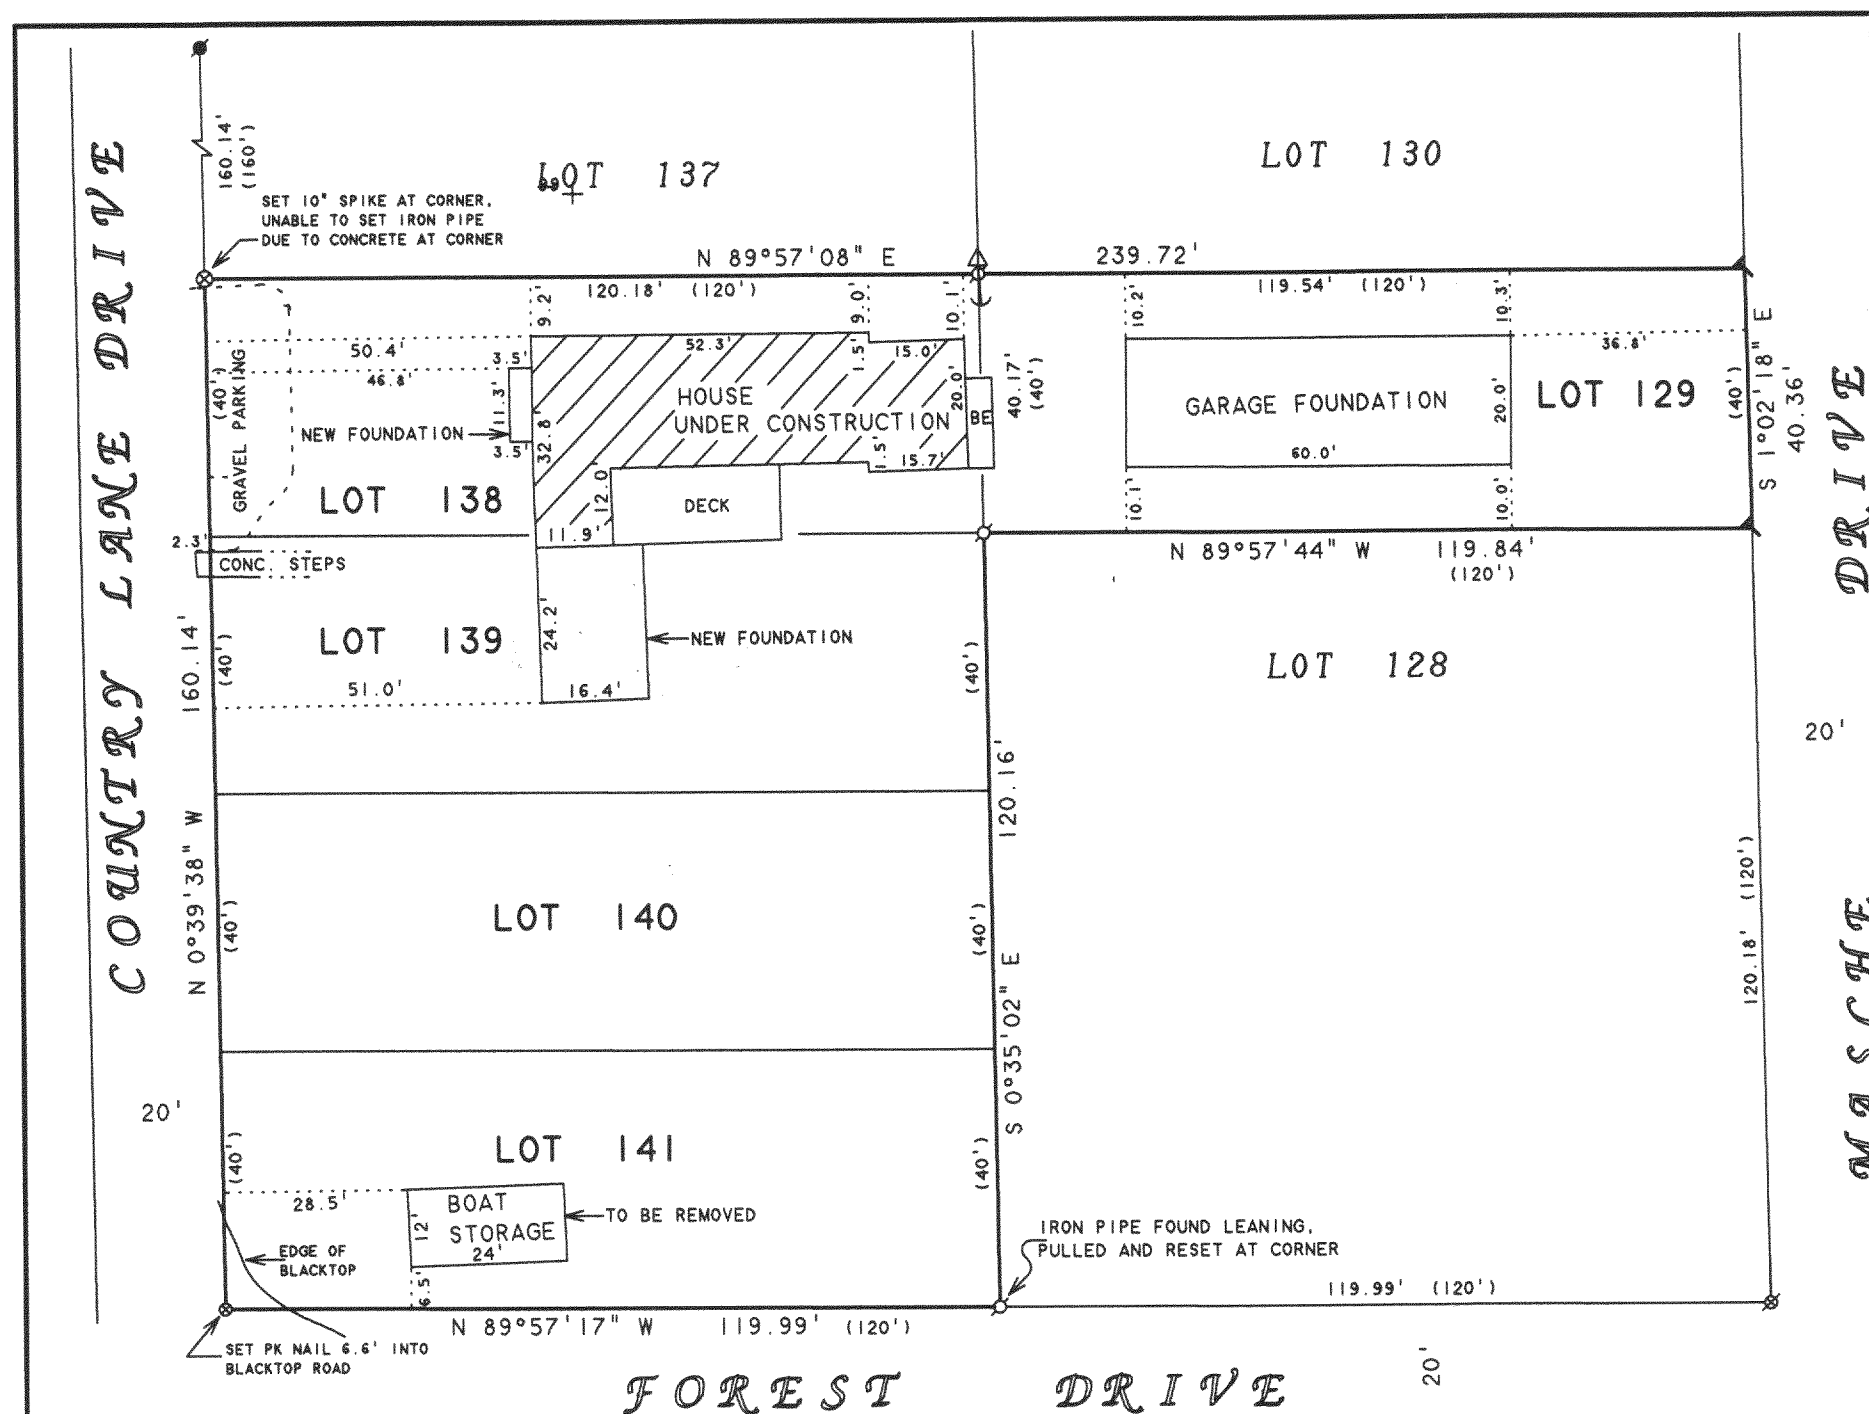

PLAT OF SURVEY OF

LOT 129 AND LOTS 138-141, KRUMHAAR'S ADDITION
TO RAVENSWOOD, LOCATED IN T2N, R16E, WALWORTH
COUNTY, WISCONSIN, CONTAINING 0.55 ACRES.

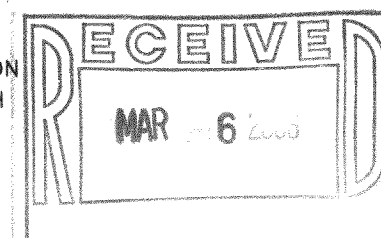

~~FRA2-129~~ FRA2-31

216 4172