


ABELL
SURVEYING & MAPPING

1140 SEQUOIA STREET • DELAVAN, WISCONSIN 53115
262-728-6737

NOTE: THE SECTION LINE BETWEEN SECTIONS
27 AND 28 IS ASSUMED NORTH-SOUTH.

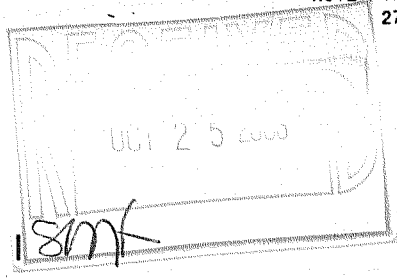

N



SCALE 1"=20'

LEGEND

- ⊙ - IRON PIPE FOUND
- - IRON BAR FOUND
- - 3/4" DIA. IRON ROD SET
- CB ⊗ - CATCH BASIN
- MC ⊗ - METAL COVER
- *—*— - WOOD BOARD FENCE
- **—**— - CHAINLINK FENCE
- () - RECORDED

PLAT OF SURVEY OF

PART OF LOT 1 OF THE SUBDIVISION OF LOT 1 OF THE
PLAT OF METTOWEE, LOCATED IN SECTION 28, T2N, R16E
AND PART OF TAX PARCEL FD-27-30, LOCATED IN SECTION
27, T2N, R16E, WALWORTH COUNTY, WISCONSIN.

NOTE: THIS PLAT IS A RETRACEMENT OF
A PORTION OF SURVEYS BY
LLOYD L. JENSEN DATED APRIL 28, 1939
AND BY GEORGE T. DUNHAM DATED APRIL 6,
1973.

TAX PARCEL FTMI-2

TAX PARCEL FTMI-2A

TAX PARCEL FD-27-30

FENCE 0.7'
S.W. OF LINE

MOST SOUTHERLY CORNER OF LOT 1
OF THE SUBDIVISION OF LOT 1 OF
THE PLAT OF METTOWEE.
FENCE 0.3' S.W. OF LINE

ORDERED BY: THE TOWN OF DELAVAN
5621 TOWN HALL ROAD
DELAVAN, WI 53115

I, DAVID F. ABELL, DO HEREBY CERTIFY THAT I HAVE SURVEYED THE PROPERTY HEREON
DESCRIBED ACCORDING TO THE OFFICAL RECORDS AND THAT THE PLAT HEREON IS A
CORRECT REPRESENTATION OF THE PROPERTY LINES TO THE BEST OF MY KNOWLEDGE AND
BELIEF.

David F. Abell

DAVID F. ABELL
WISCONSIN REGISTERED LAND SURVEYOR, S-1596

June 6, 2006

DATE: June 6, 2006 JOB NUMBER - 06045
NOTE: THIS IS NOT A CERTIFIED COPY UNLESS SEALED.

FTMI-2 FD27-30

216-4257