


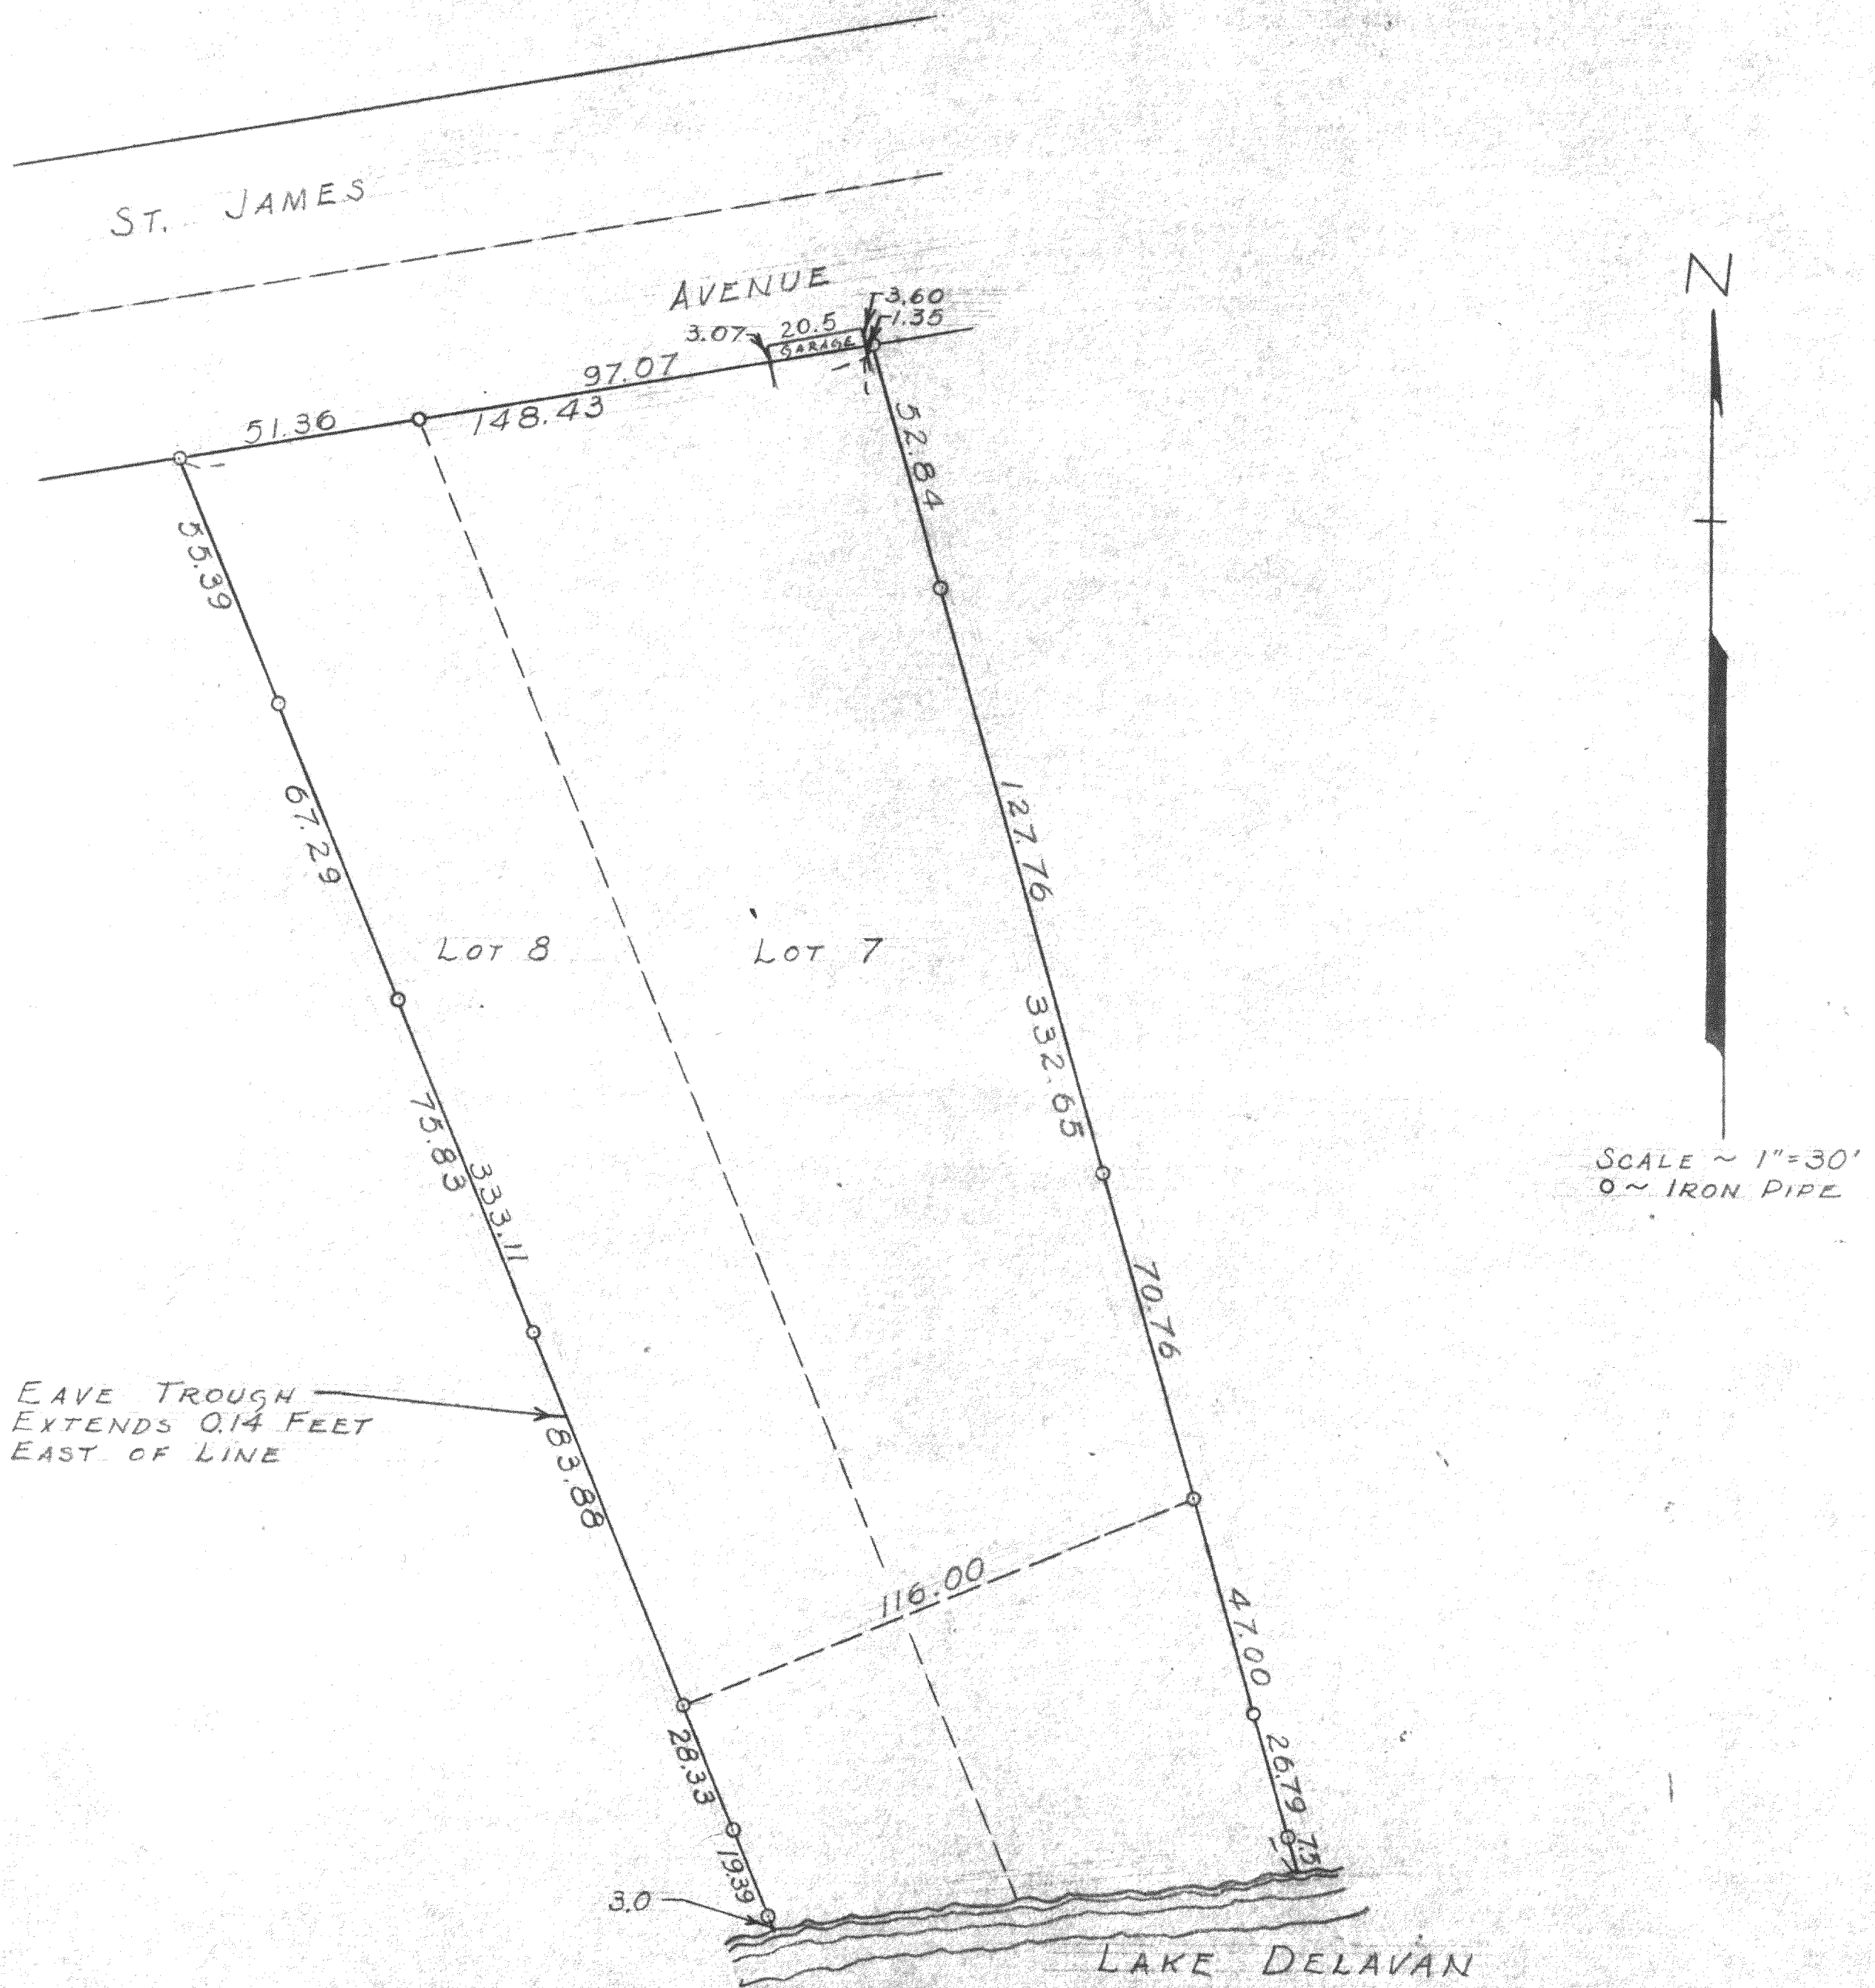

PLAT OF SURVEY OF LOTS 7 AND 8, ST. MARY'S SUBDIVISION OF DELAVAN LAKE, T2NR16E, WALWORTH COUNTY, WISCONSIN, JULY 1956

FS-4

216-43

George H. Dunham
GEORGE H. DUNHAM, SURVEYOR
DELAVAN, WISCONSIN