


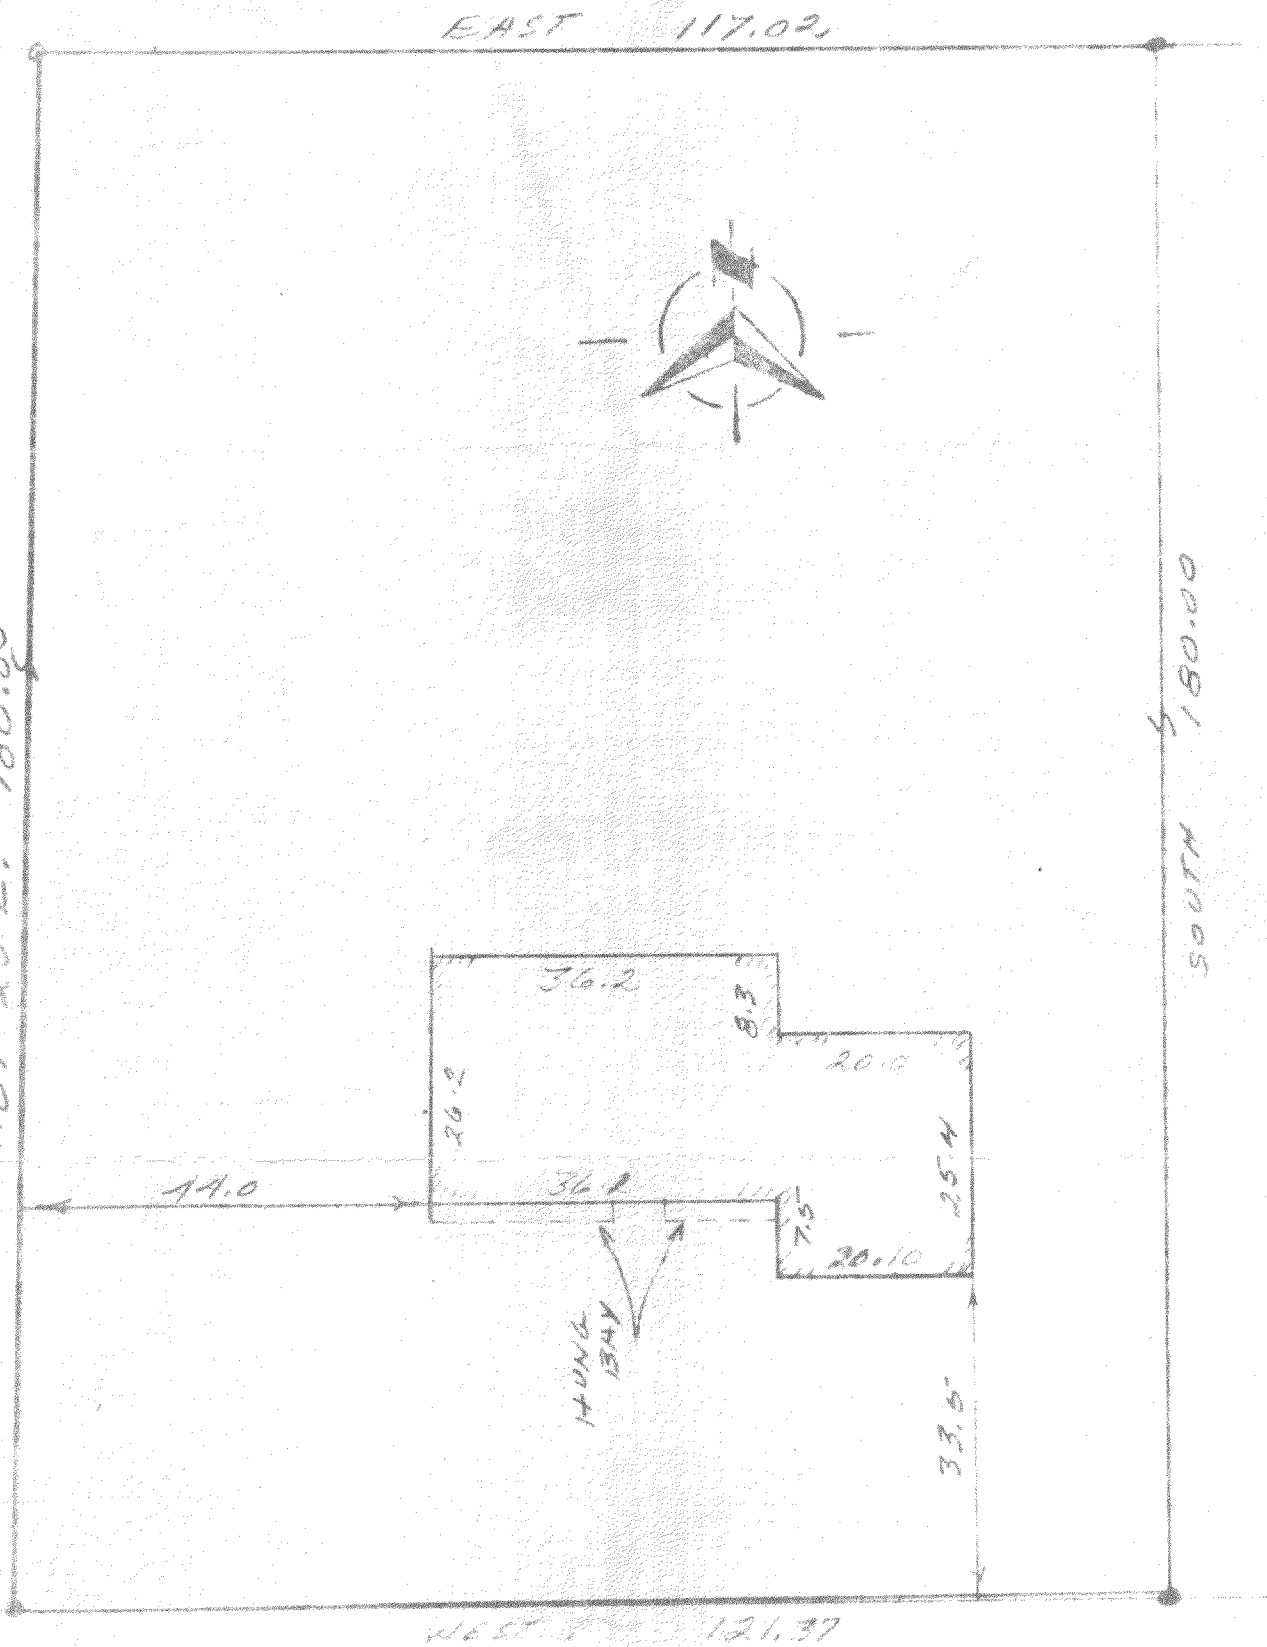

VALENCIA DRIVE

Lot 1 in Block 14 of Inlet Oaks Subdivision Number 5. Said land being in the Town of Delevan, Walworth County, and the State of Wisconsin. Located in the West $\frac{1}{4}$ of the Southeast $\frac{1}{4}$ and in the Northeast $\frac{1}{4}$ of the Southeast $\frac{1}{4}$ of Section 15 Township 2 North of Range 16 of the Fourth Principle Meridian.....

Survey for: ROBERT MARSHALL

Name: _____

Address of survey: 546 4100A DE


DELEVAN

Harold M. Schneider registered land surveyor do hereby certify that I have made the survey as represented hereon, and that it is correct to the best of my knowledge and belief.

Harold M. Schneider
HAROLD M. SCHNEIDER

Part of SE Quarter of
Section 15 Town 2 N.R. 16 E.

SCALE 1"=20'
PIPE

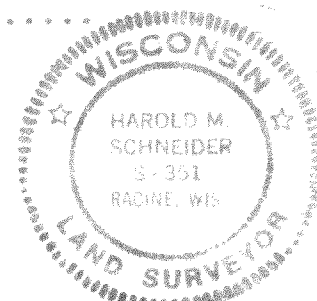

Surveyed and Platted by:
HAROLD M. SCHNEIDER
Racine, Wisconsin 53406

216-432

FIN 5-39 2-26-77

SURVEY 20